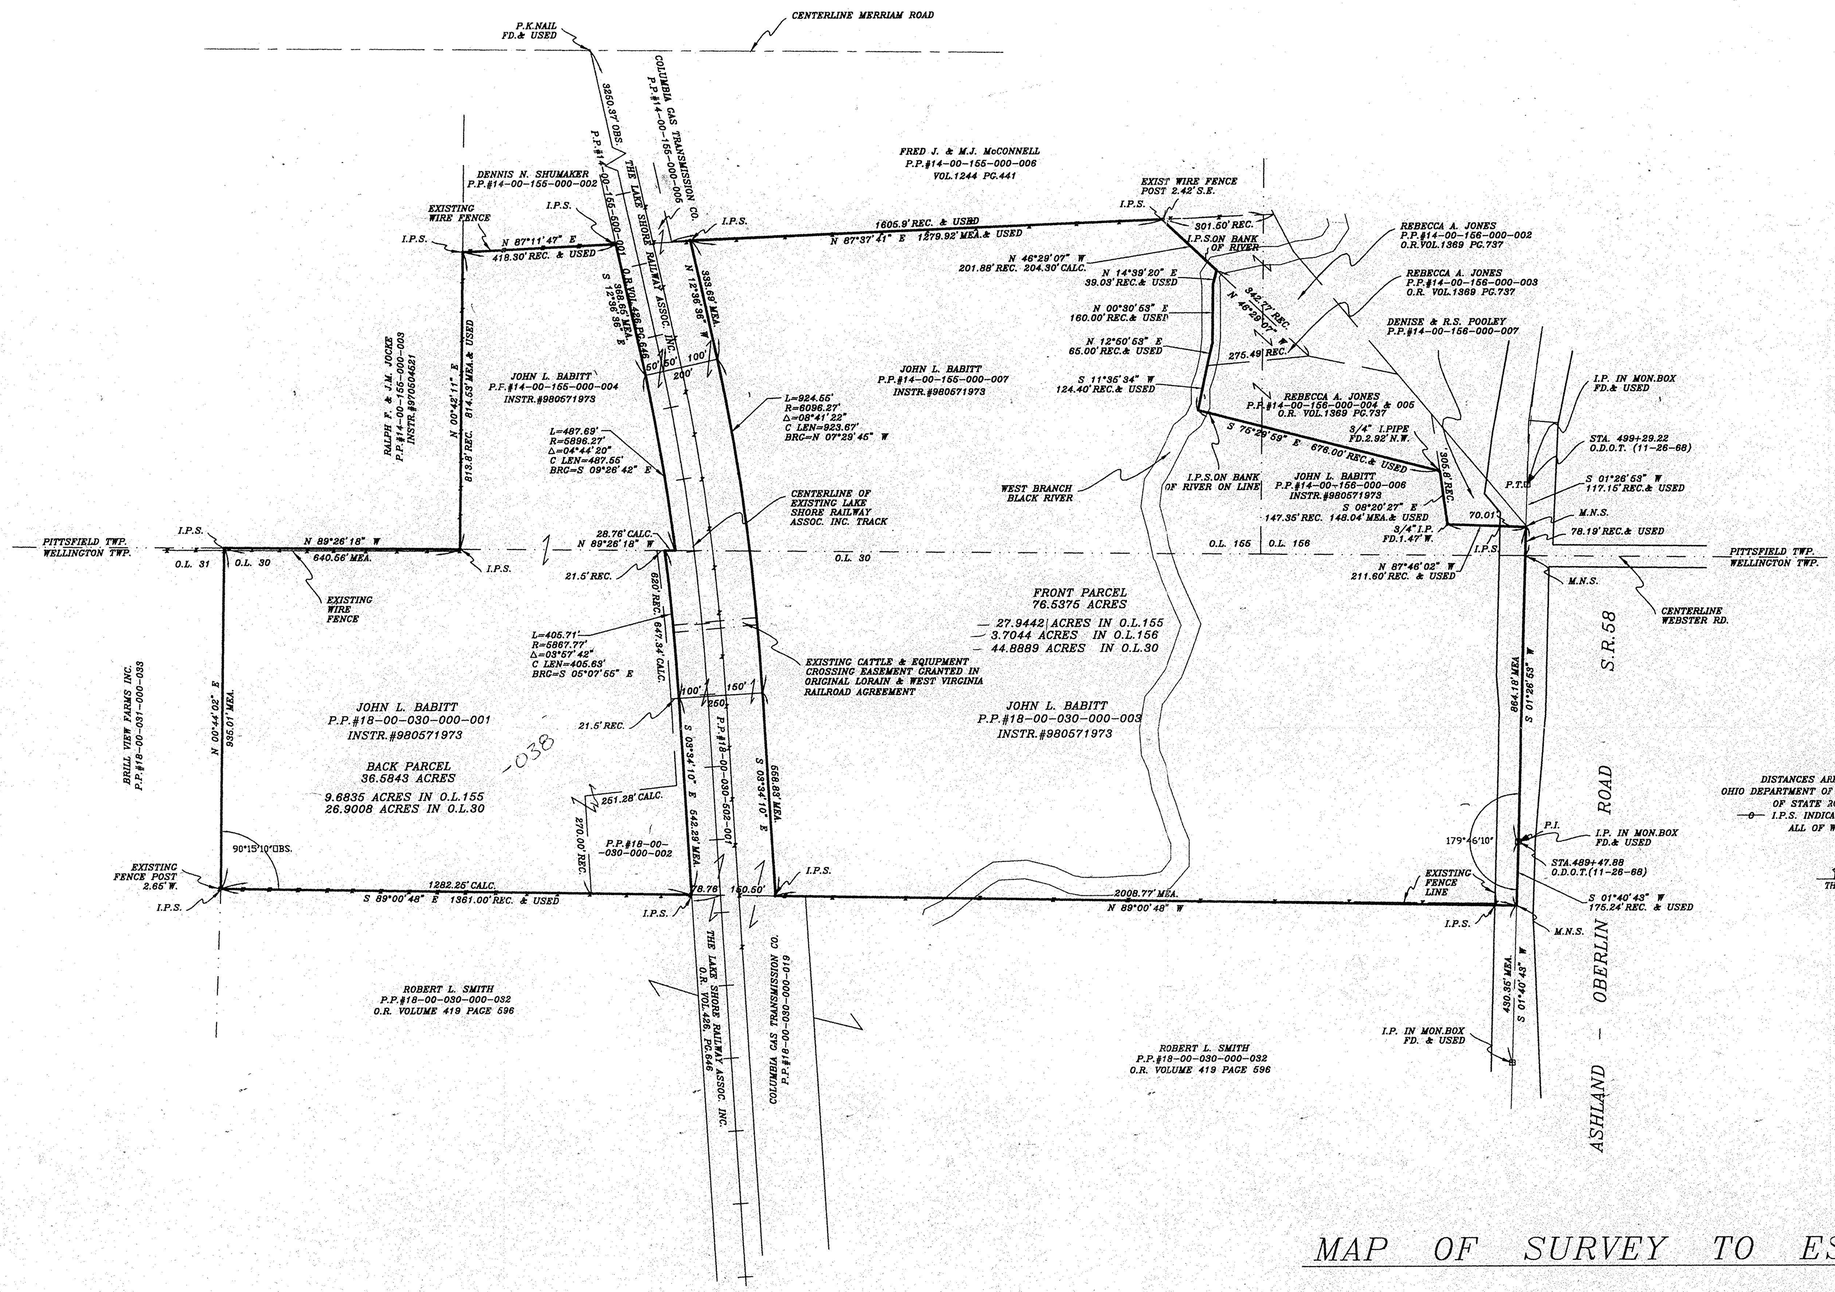

SURVEYOR'S STATEMENT

DISTANCES ARE EXPRESSED IN FEET AND DECIMAL PARTS THEREOF. BEARING ARE BASED ON OHIO DEPARTMENT OF TRANSPORTATION RIGHT-OF-WAY PLANS DATED 11-26-68 ESTABLISHING THE CENTERLINE OF STATE ROUTE 58. PERMANENT MONUMENTS WERE FOUND OR SET AS INDICATED HEREON. —o— I.P.S. INDICATES A 5/8" IRON PIN WITH CAP SET. —•— M.N.S. INDICATES A MAGNETIC NAIL SET. ALL OF WHICH I DECLARE TO BE CORRECT TO THE BEST OF MY ABILITY AND BELIEF.

Thomas M. Snezek
THOMAS M. SNEZEK, R.L.S. #7051

7-30-00
DATE

STATE OF OHIO
THOMAS M. SNEZEK
8-7051
SURVEYOR

#00571
APPROVED
LORAIN CO.
MAP DEPT.
DATE 10/19/00
PAGE 18-B & H-F & G
BY T. SPILLMAN
MAP NUMBER 00571

MAP OF SURVEY TO ESTABLISH BOUNDARIES

PREPARED FOR

JOHN L. BABITT

SITUATED IN THE TOWNSHIPS OF PITTSFIELD AND WELLINGTON, IN THE COUNTY OF LORAIN, STATE OF OHIO AND BEING KNOWN AS PART OF ORIGINAL PITTSFIELD TOWNSHIP LOTS 155 AND 156, ALSO BEING PART OF ORIGINAL WELLINGTON TOWNSHIP LOT 30

PROJECT #9929 7/20/00