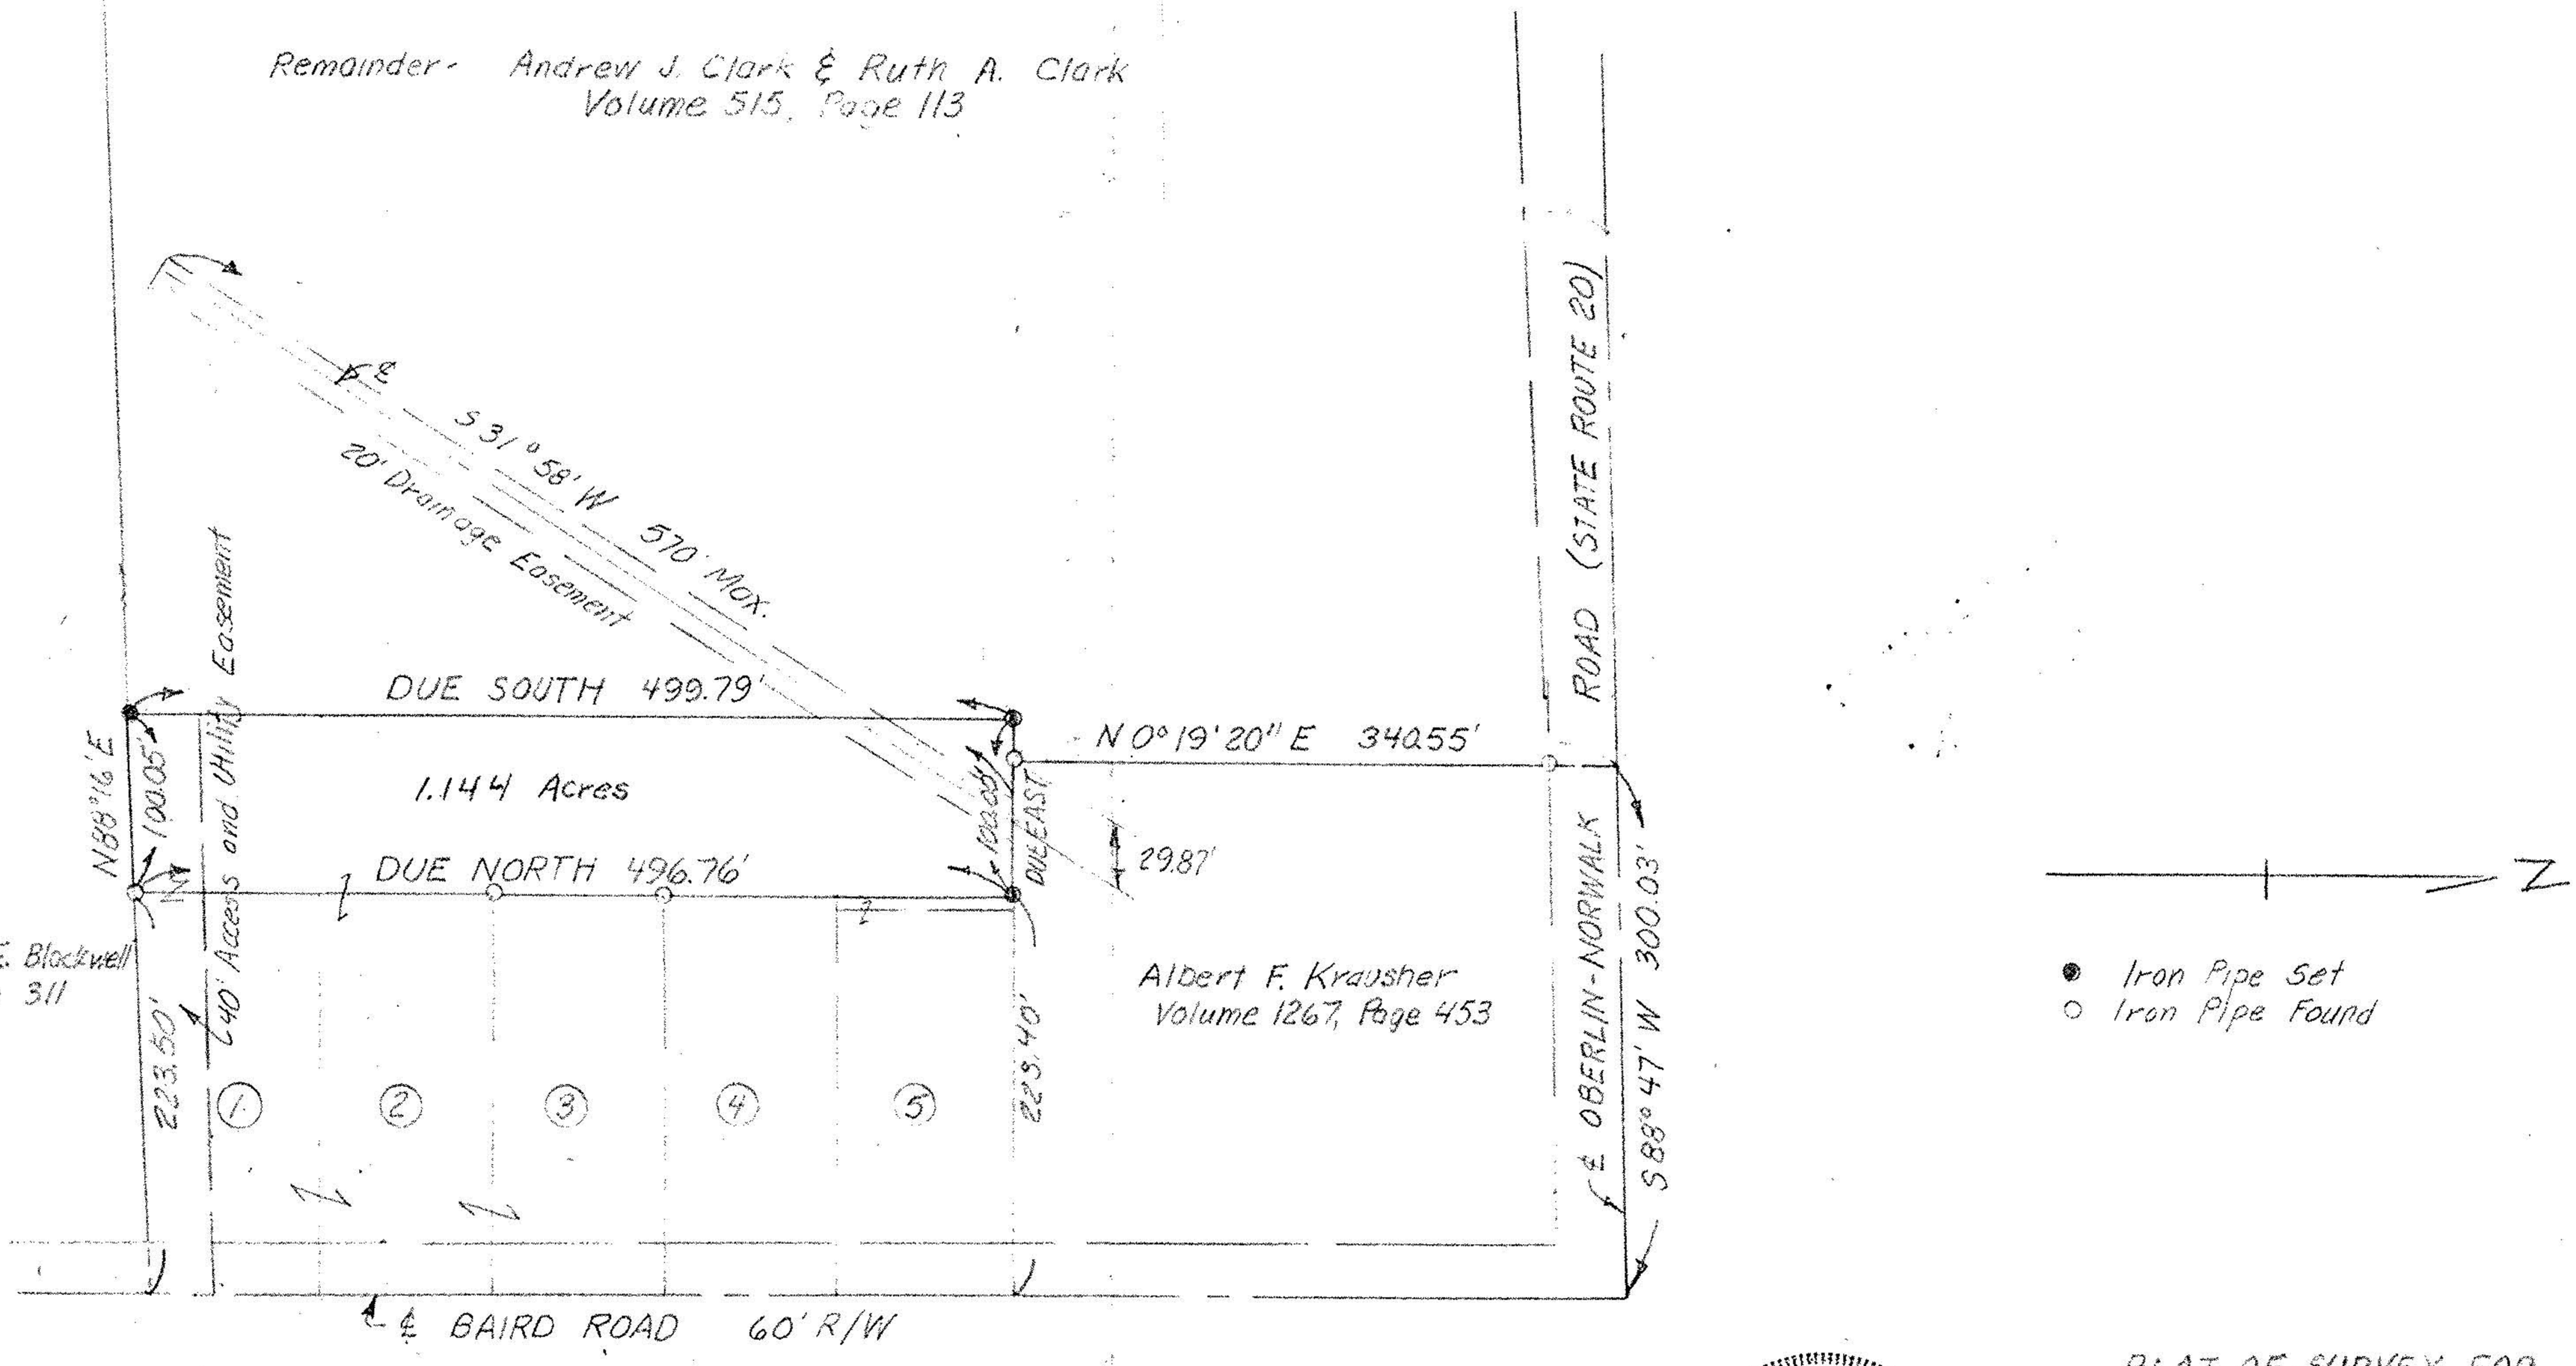


| | | |
|---|---|---|
| (1) | Marvin B. & Judith E. Fannin | Volume 1131, Page 522 |
| (2) | Marvin B & Judith E Fannin | Volume 1243, Page 105 |
| (3) | Marvin B. & Judith E Fannin | Volume 1164, Page 266 |
| (4) | Dale L. & Karen C. Husted | Volume 1131, Page 526 |
| (5) | Ralph P. & Andrea Piotrowski | Volume 1065, Page 412 |

N

● Iron Pipe Set
○ Iron Pipe Found

APPROVED
LORAIN CO.
MAP DEPT.
DATE 5-26-89
PAGE 13-B
BY Carol Frances
VOID AFTER # 18455

#18455

STATE OF OHIO
LAWRENCE
V.
McGLINCHY
4970
REGISTERED
SURVEYOR

PLAT OF SURVEY FOR
MARVIN B. & JUDITH E. FANNIN
O.L. 3, TRACT 10 CAMDEN TWP.
LORAIN COUNTY, OHIO

McGLINCHY & ASSOCIATES
AMHERST, OHIO 3-8-89
1" = 100' Job # 898775
Revised 3-14-89