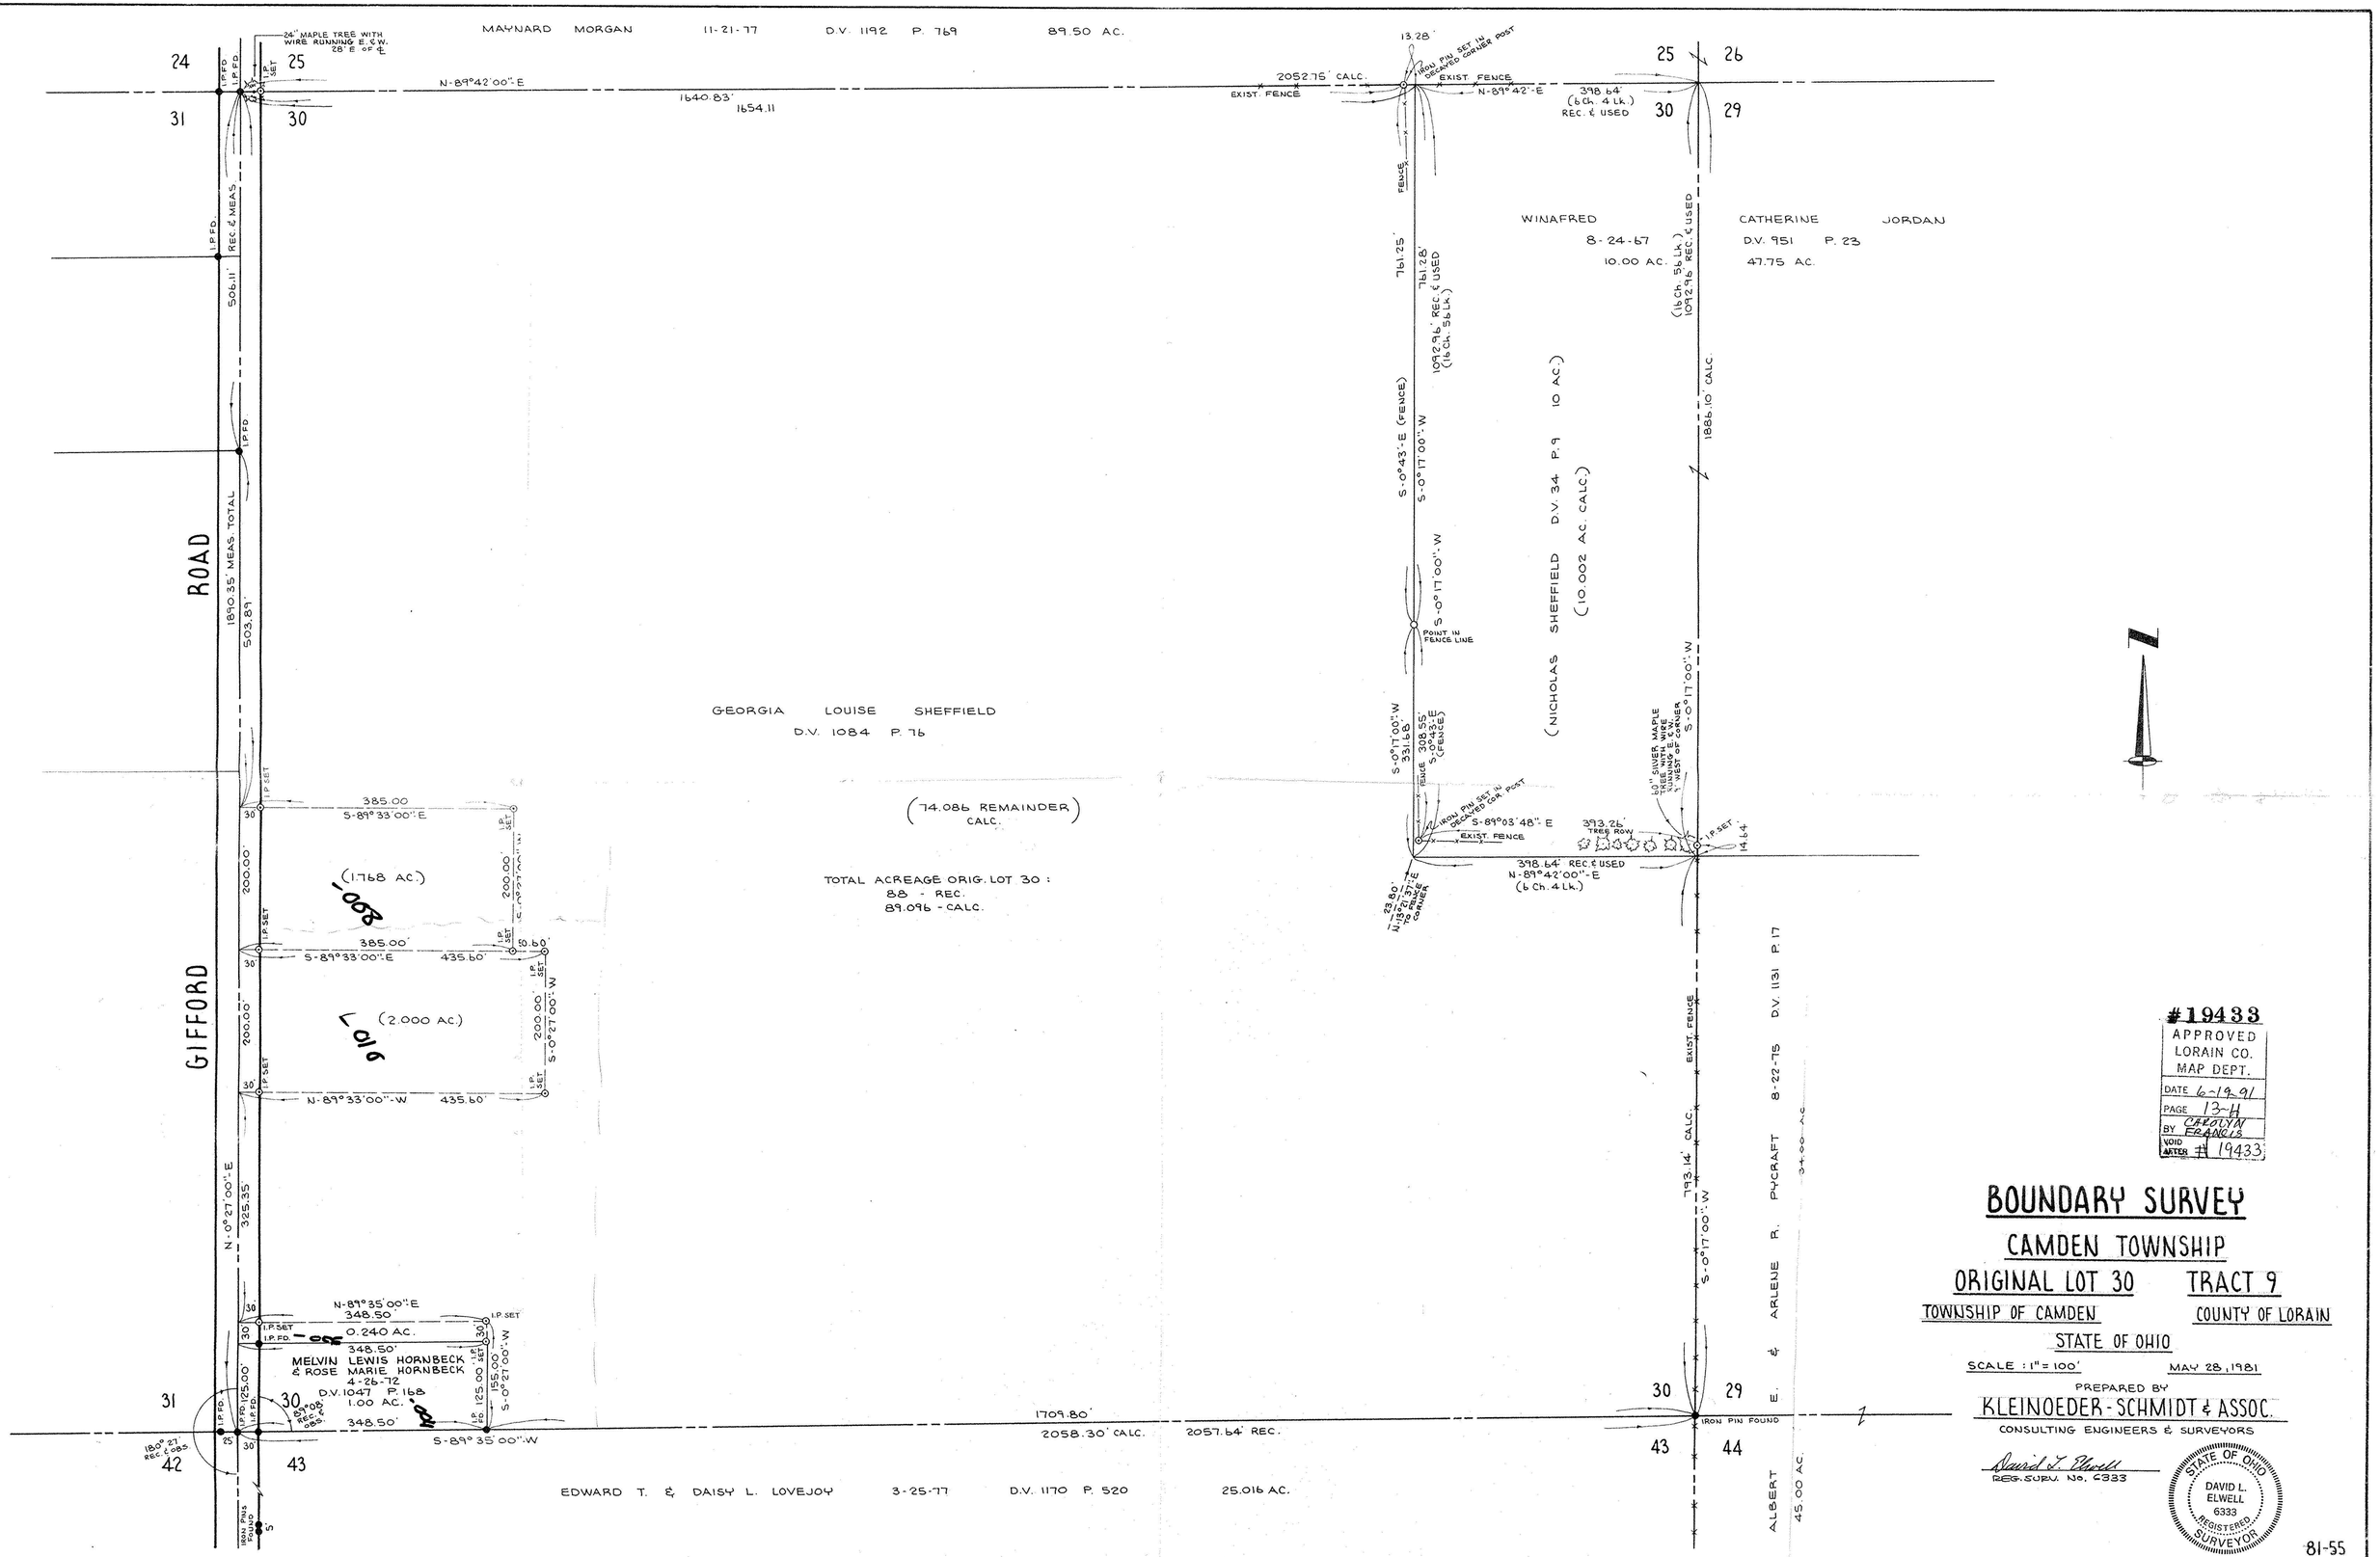

#19433

APPROVED
LORAIN CO.
MAP DEPT.

DATE 6-19-91
PAGE 13-H
BY CAROLYN FRANCIS
VOID AFTER # 19433

BOUNDARY SURVEY

CAMDEN TOWNSHIP

ORIGINAL LOT 30 **TRACT 9**

TOWNSHIP OF CAMDEN COUNTY OF LORAIN

STATE OF OHIO

SCALE : 1" = 100' MAY 28, 1981

PREPARED BY

KLEINOEDER-SCHMIDT & ASSOC.

CONSULTING ENGINEERS & SURVEYORS

David L. Elwell
REG. SURV. NO. 6333

STATE OF OHIO
DAVID L. ELWELL
6333
REGISTERED SURVEYOR

81-55