Map of Part of Lot 7 Tract 11 Camden Twp. Lorain Co. Ohio
Scale 1" 100' Nov. 27,1976

By Arnold f. Koepp Reg. Surveyor No. 4306

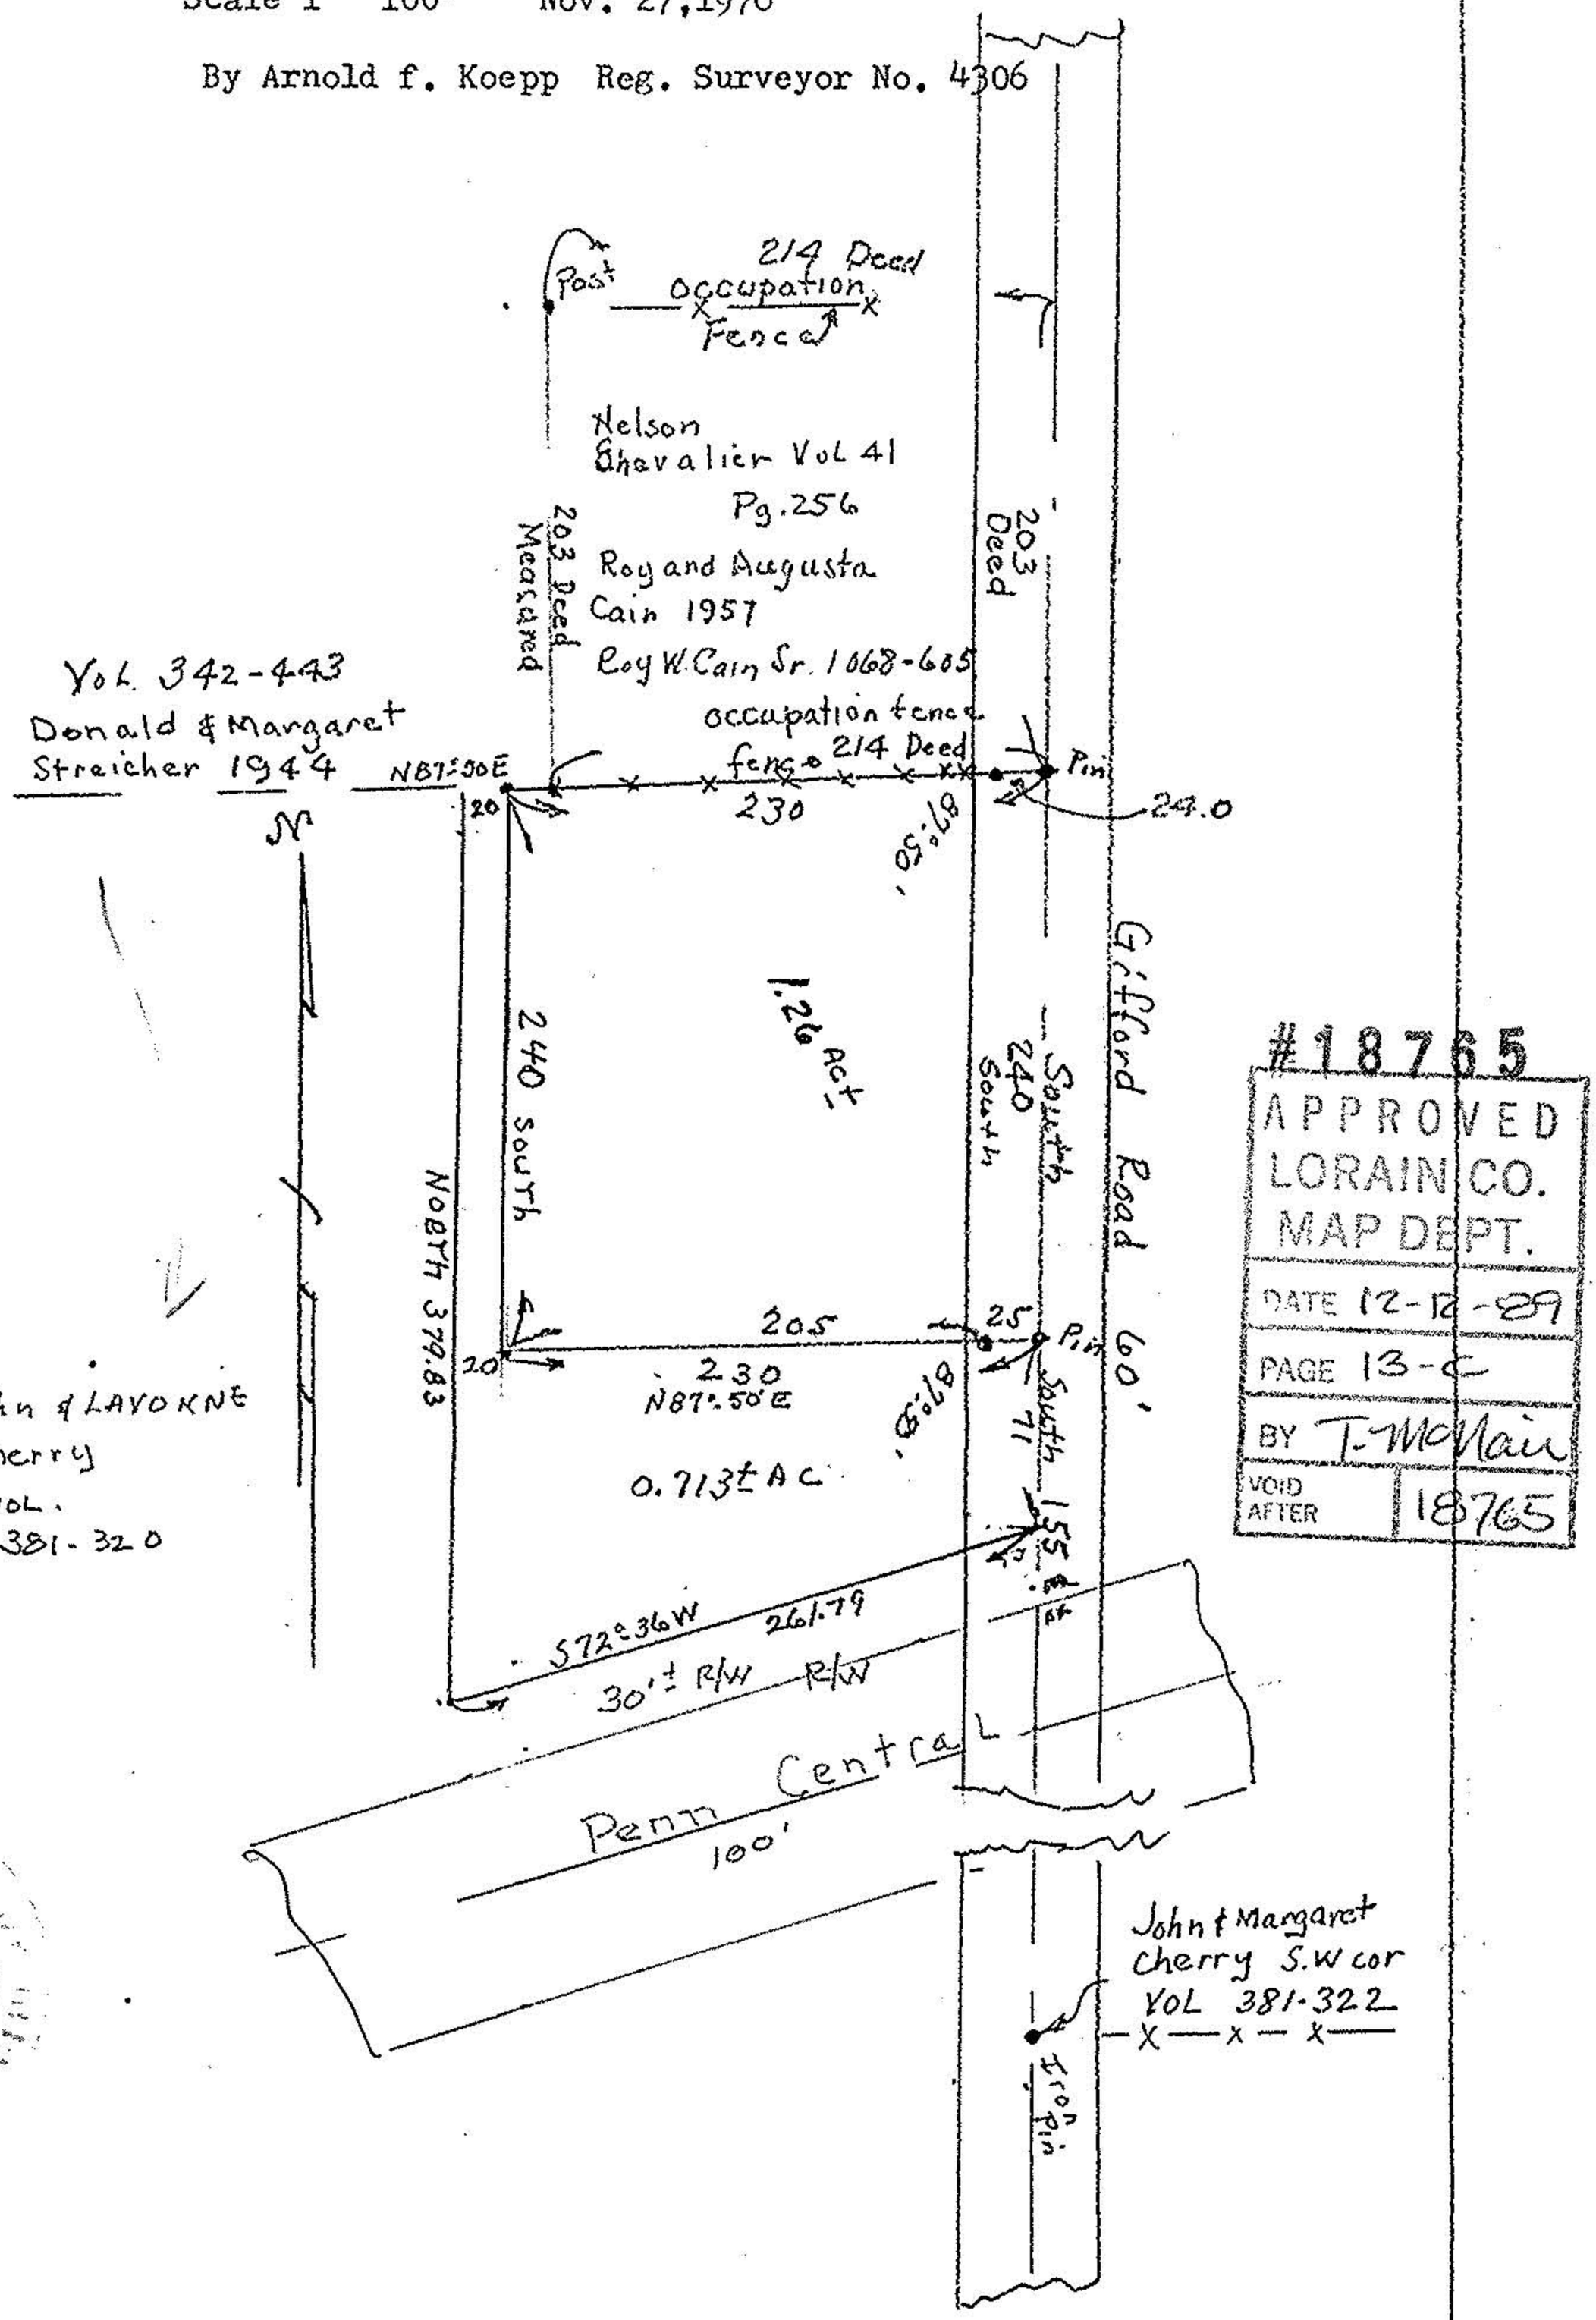

#18765
APPROVED
LORAIN CO.
MAP DEPT.
DATE 12-12-89
PAGE 13-C
BY T. McNair
VOID AFTER 18765

C90-01-7

-90-11-01-