



Janice Merrill & Sandra Krupp

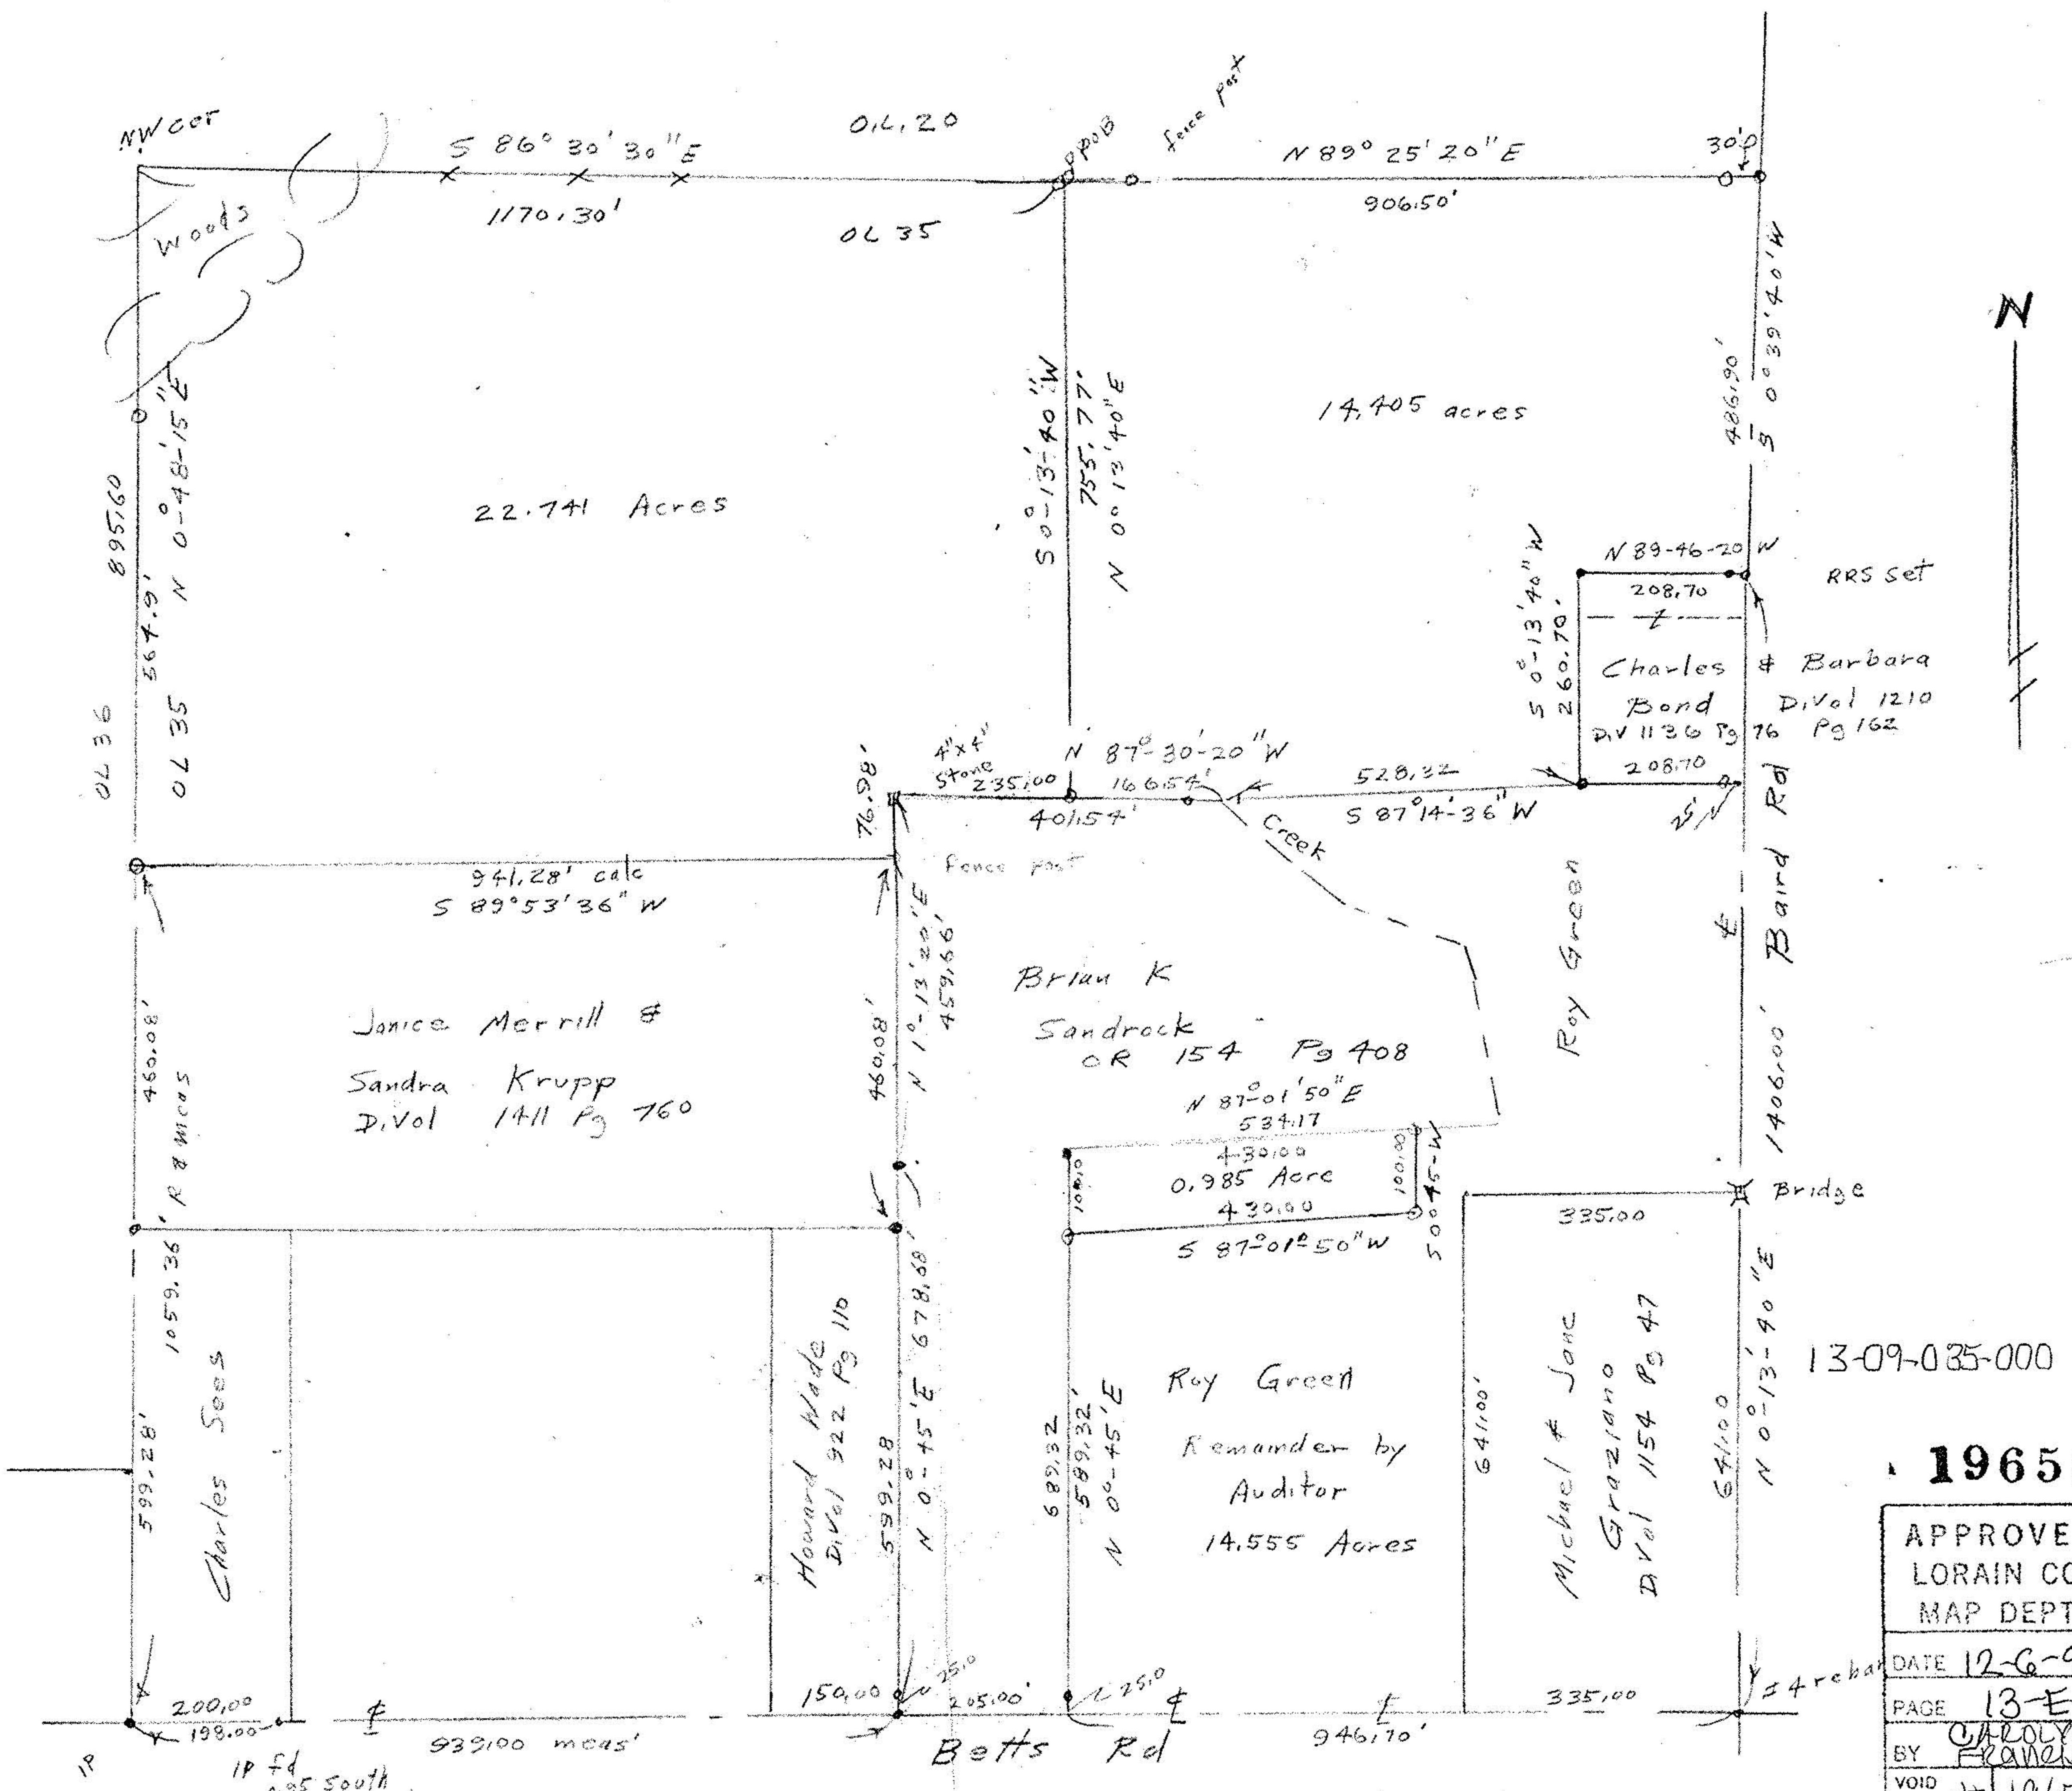

● Iron pipes fd
○ Iron pipes set

John Poznyarski
Reg Surveyor
5292

Survey for Roy Green
Part Original Lot 35 Tract 9
Lorain County Ohio
Scale 1" = 200' Sept. 16, 1991

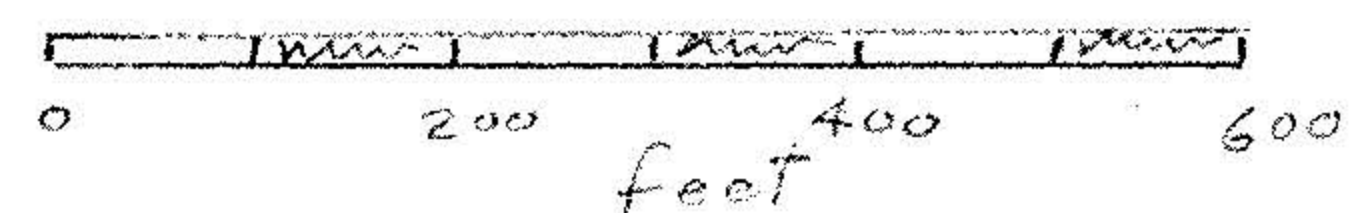

13-09-035-000

19652

APPROVED	LORAIN CO.
MAP DEPT.	
DATE	12-6-91
PAGE	13-E
BY	CAROLYN FRANKS
VOID AFTER	# 19652