


Note I found an error in the Lewis deed. The Lewis deed calls for 1498.60 feet from the centerline intersection of Baumhart Road with Plate Road. Using the 3/4" iron pin found in the location pointed out to me by Clyde Lewis, I measured 1595.63 feet to the East line of Clyde Lewis's lands and set pins.

assumed

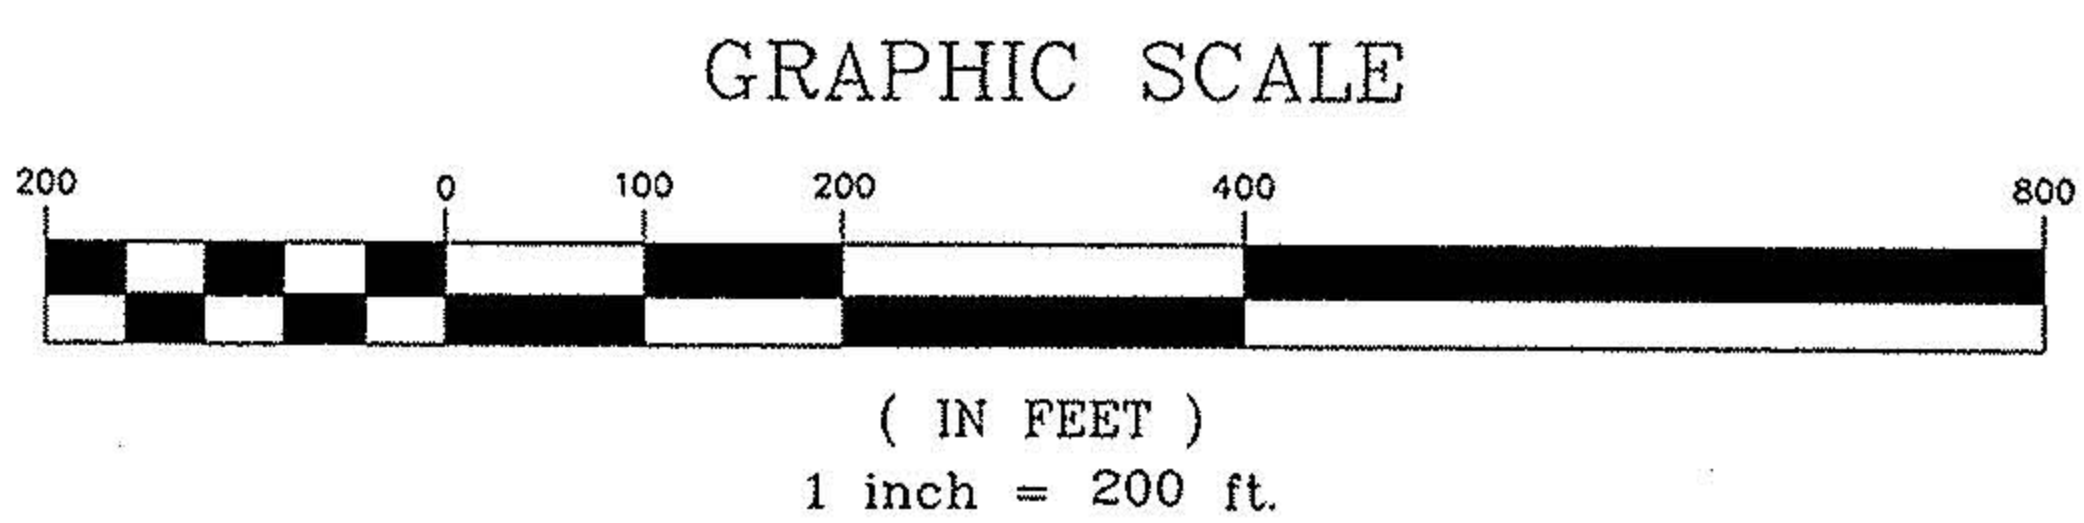

Carl Feick
Carl M. Feick P.S. 7035

| | |
|---|---------------|
| FEICK SURVEYORS | |
| 224 East Water Street, Sandusky, Ohio 44870, 419-625-3241 | |
| DRAWN BY: CMF | DATE: 9/21/96 |
| JOB NO.: S4737 | SHEET 1 OF 1 |
| Plat of Survey | |
| Chuck Davidson | |
| 49300 Rt. 20 West Tract 11, Lot 29 Camden Twp., Lorain Co. Ohio | |