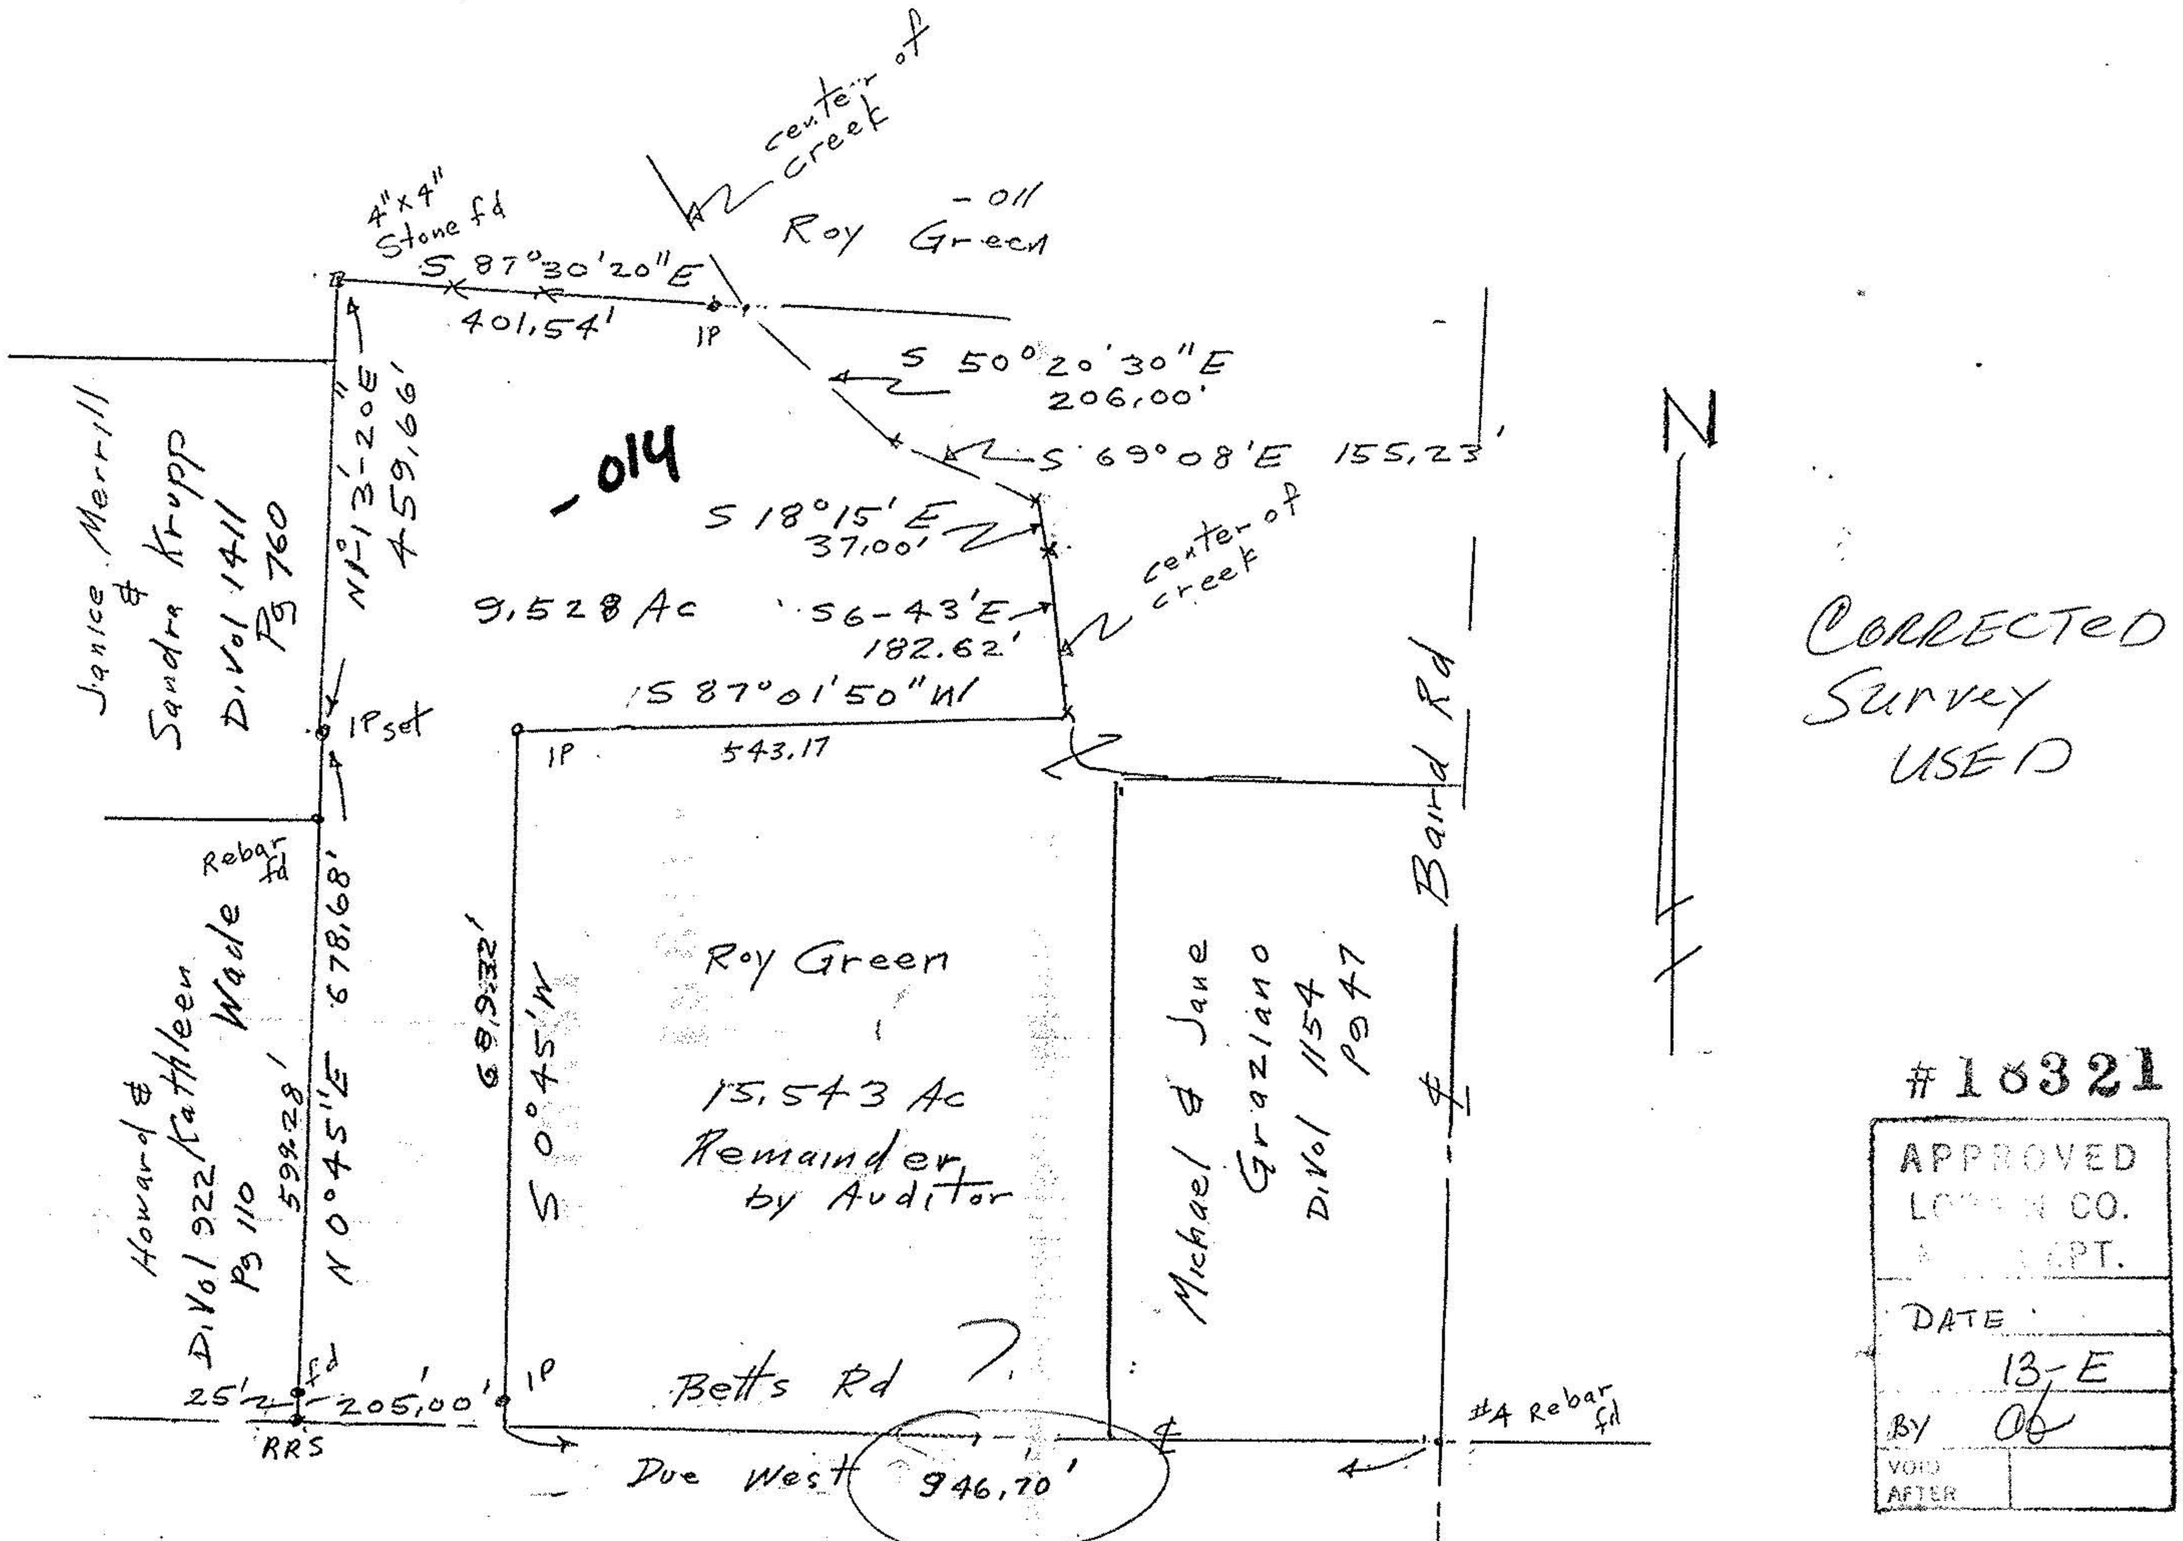

CORRECTED SURVEY USED

#18321

APPROVED
LORAIN CO.
ENGR. DEPT.
DATE
13-E
BY
VOID AFTER

John Pozywak
Reg Surveyor
5292

STATE OF OHIO
JOHN
POZYWAK
6557
REGISTERED
SURVEYOR

Survey for Byron Sandrock
Part of Original lot 35, Tract 9
Camden Township
Lorain County Ohio
Scale 1"=200' Sept 25, 1988