13-11-016-103

[1 - 103]

Mpa of Part of Lot 16 Tract 11 Village of Kipton, Twp. of Camden
County of Lorain and State of Ohio
Scale 1" 100' Nov. 20, 1981
By Arnold F. Koepp Reg. Surveyor

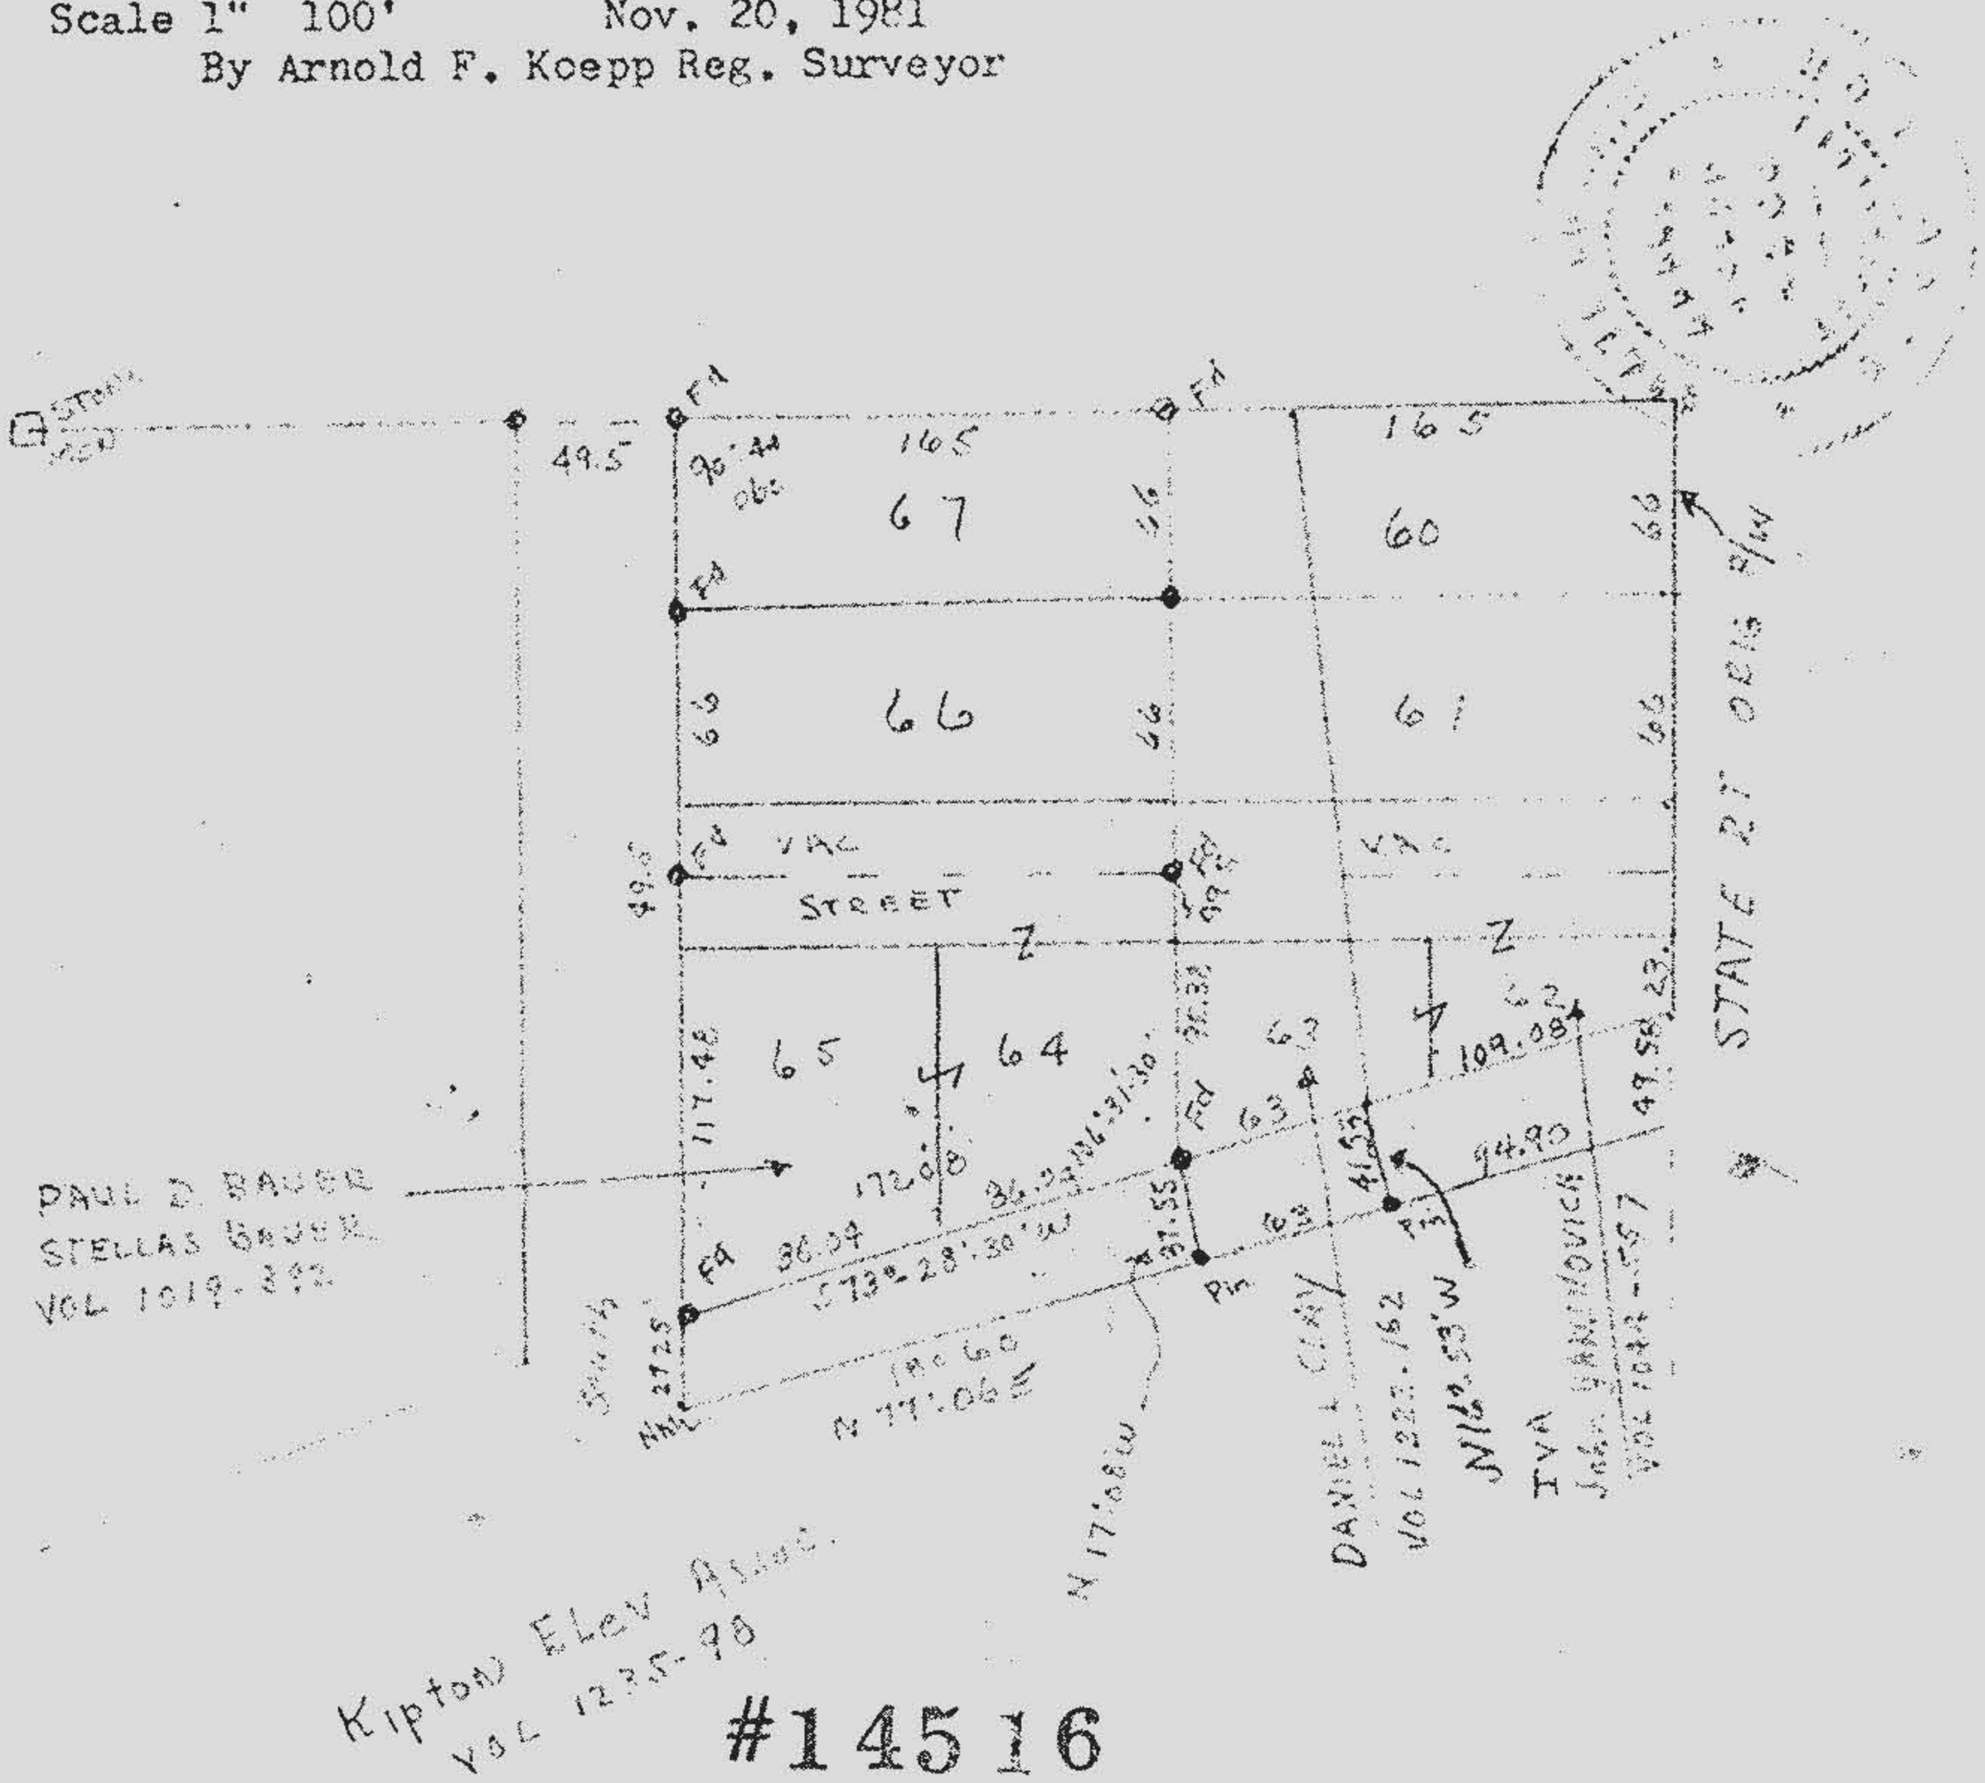

#14516

APPROVED
LORAIN CO.
MAP DEPT.
DATE 2-9-82
PAGE 13-11-016
BY T. McNair
VOID
AFTER

13-11-016