PLAT OF SURVEY FOR GORDON GROOT

ORIGINAL LOT 13 – TRACT II – CAMDEN TWP.
LORAIN COUNTY OHIO
SCALE: 1" = 60' FEBRUARY 16, 1974
Gary E. Penfound Reg. Surveyor No. 4457
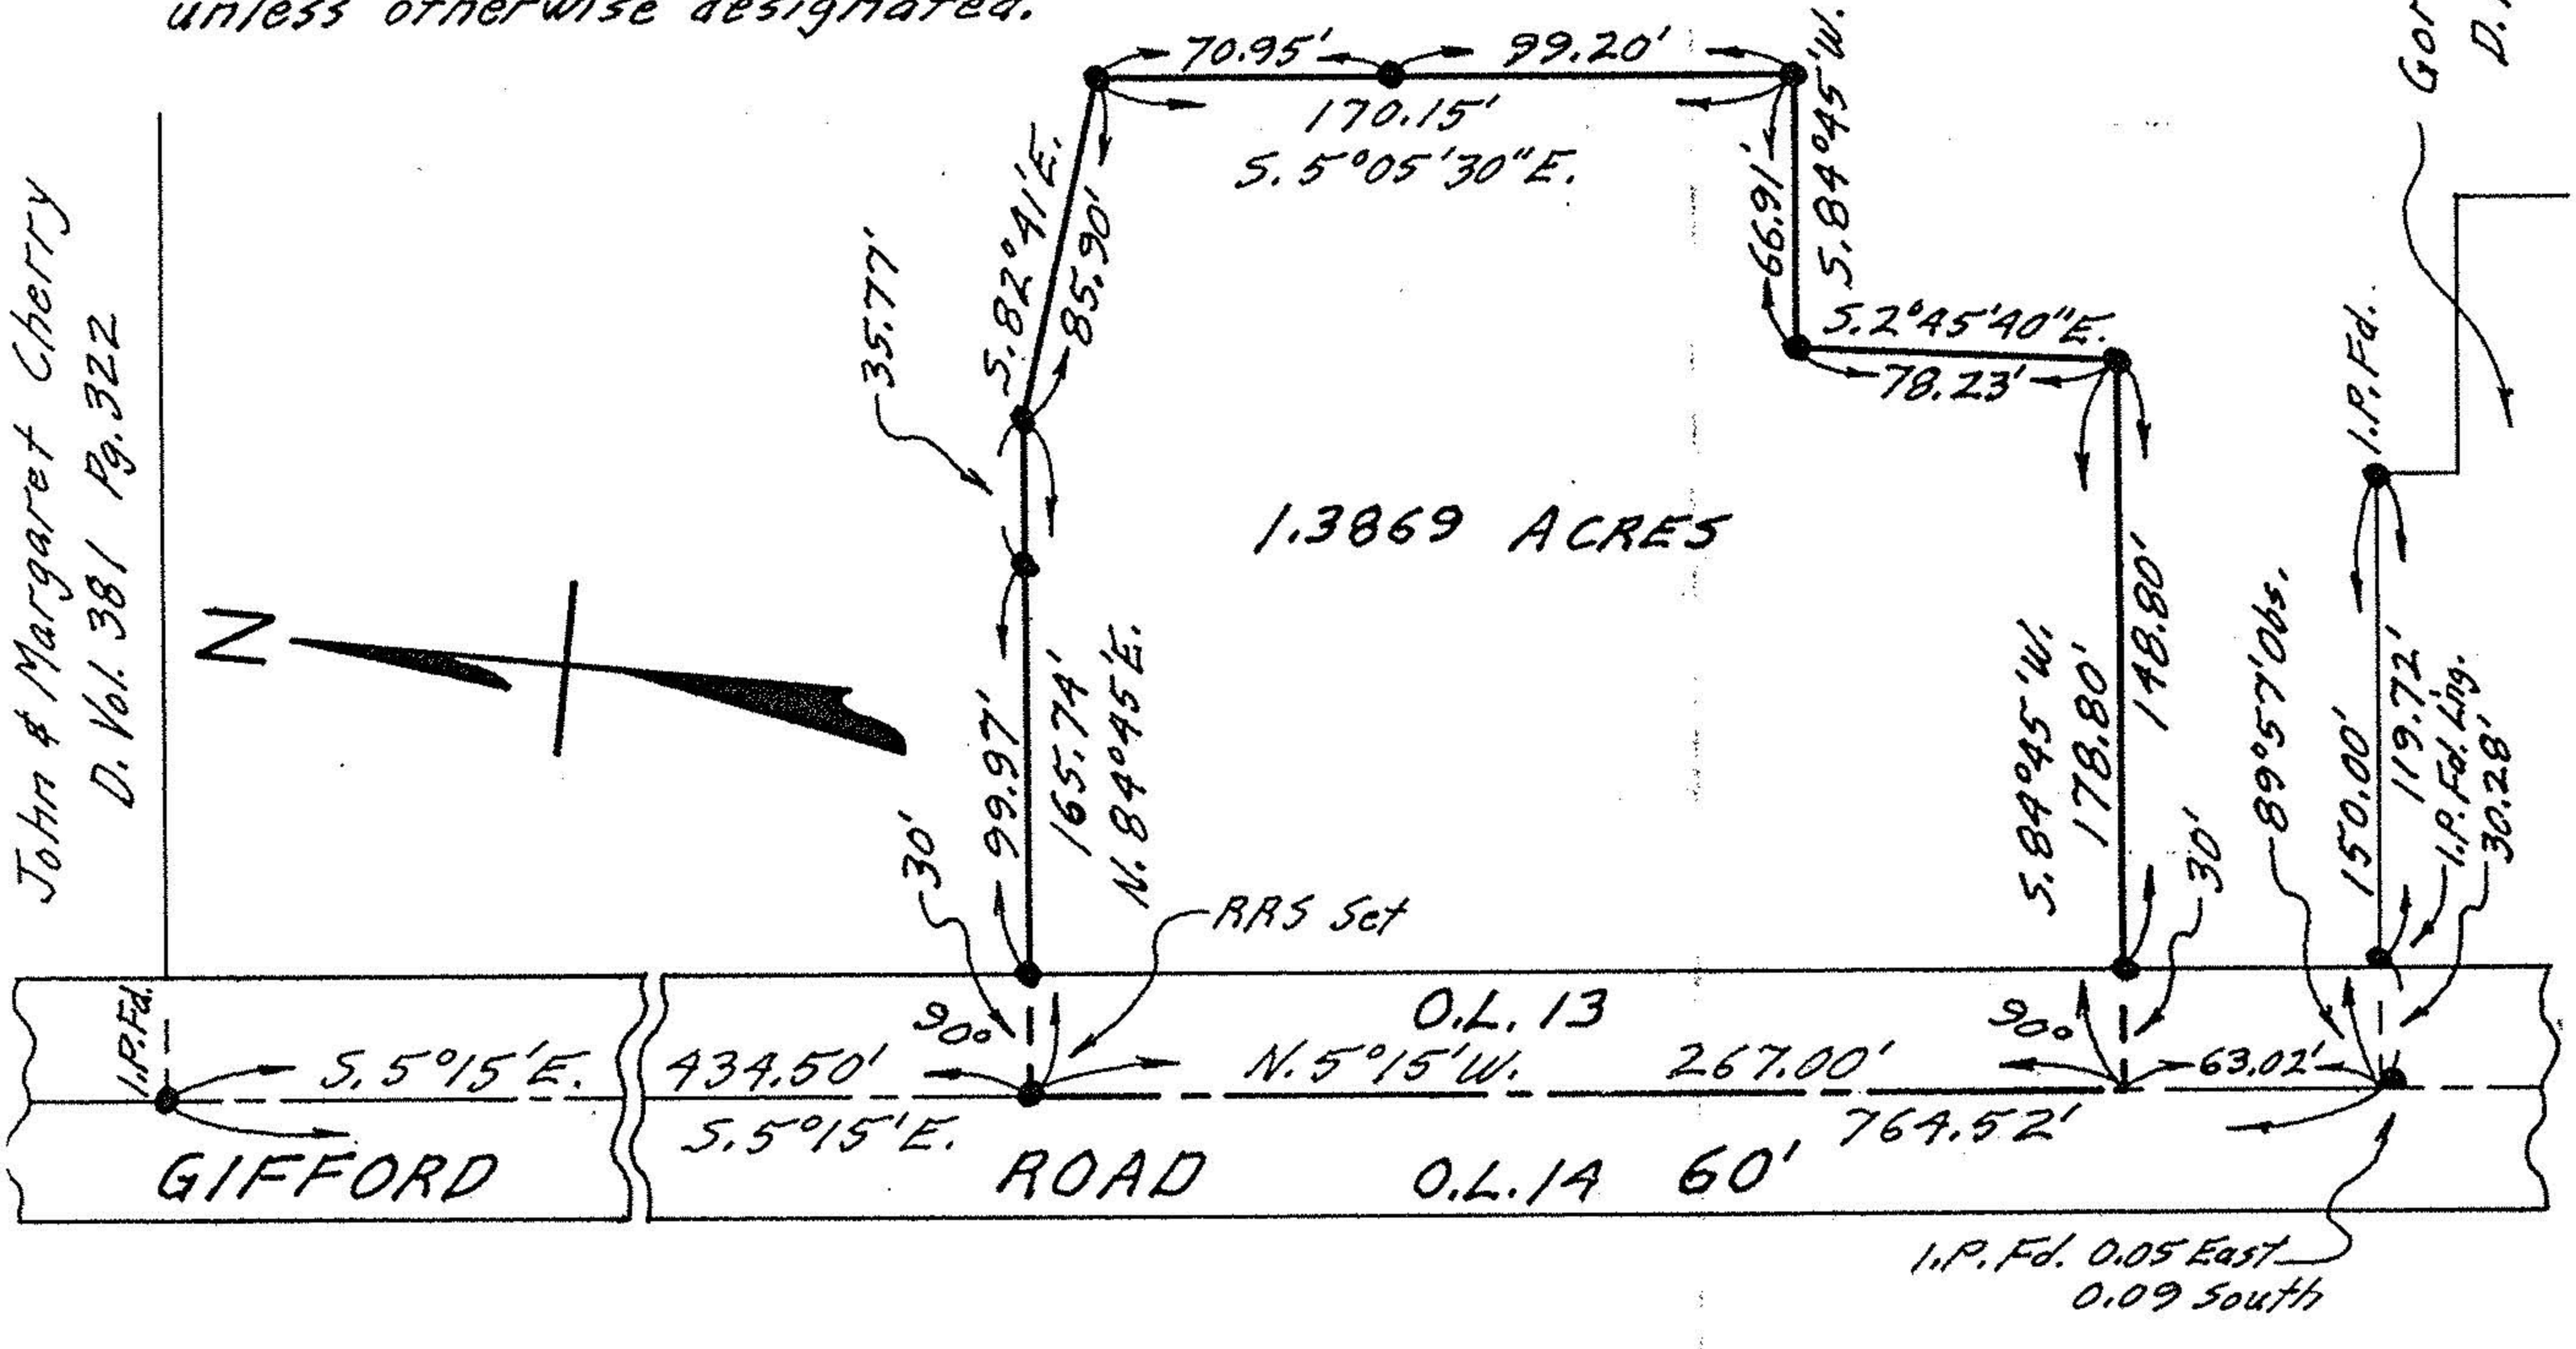
NOTE: ● indicates iron pin set unless otherwise designated.