PREPARED BY: CARL R. ANDERSON
CAMDEN TOWNSHIP ORIGINAL LOT NUMBER 30
TRACT NUMBER 10
LORAIN COUNTY
STATE OF OHIO

Carl R. Anderson
CARL R. ANDERSON P.S.

STATE OF OHIO
CARL R. ANDERSON
6582
REGISTERED SURVEYOR

00662
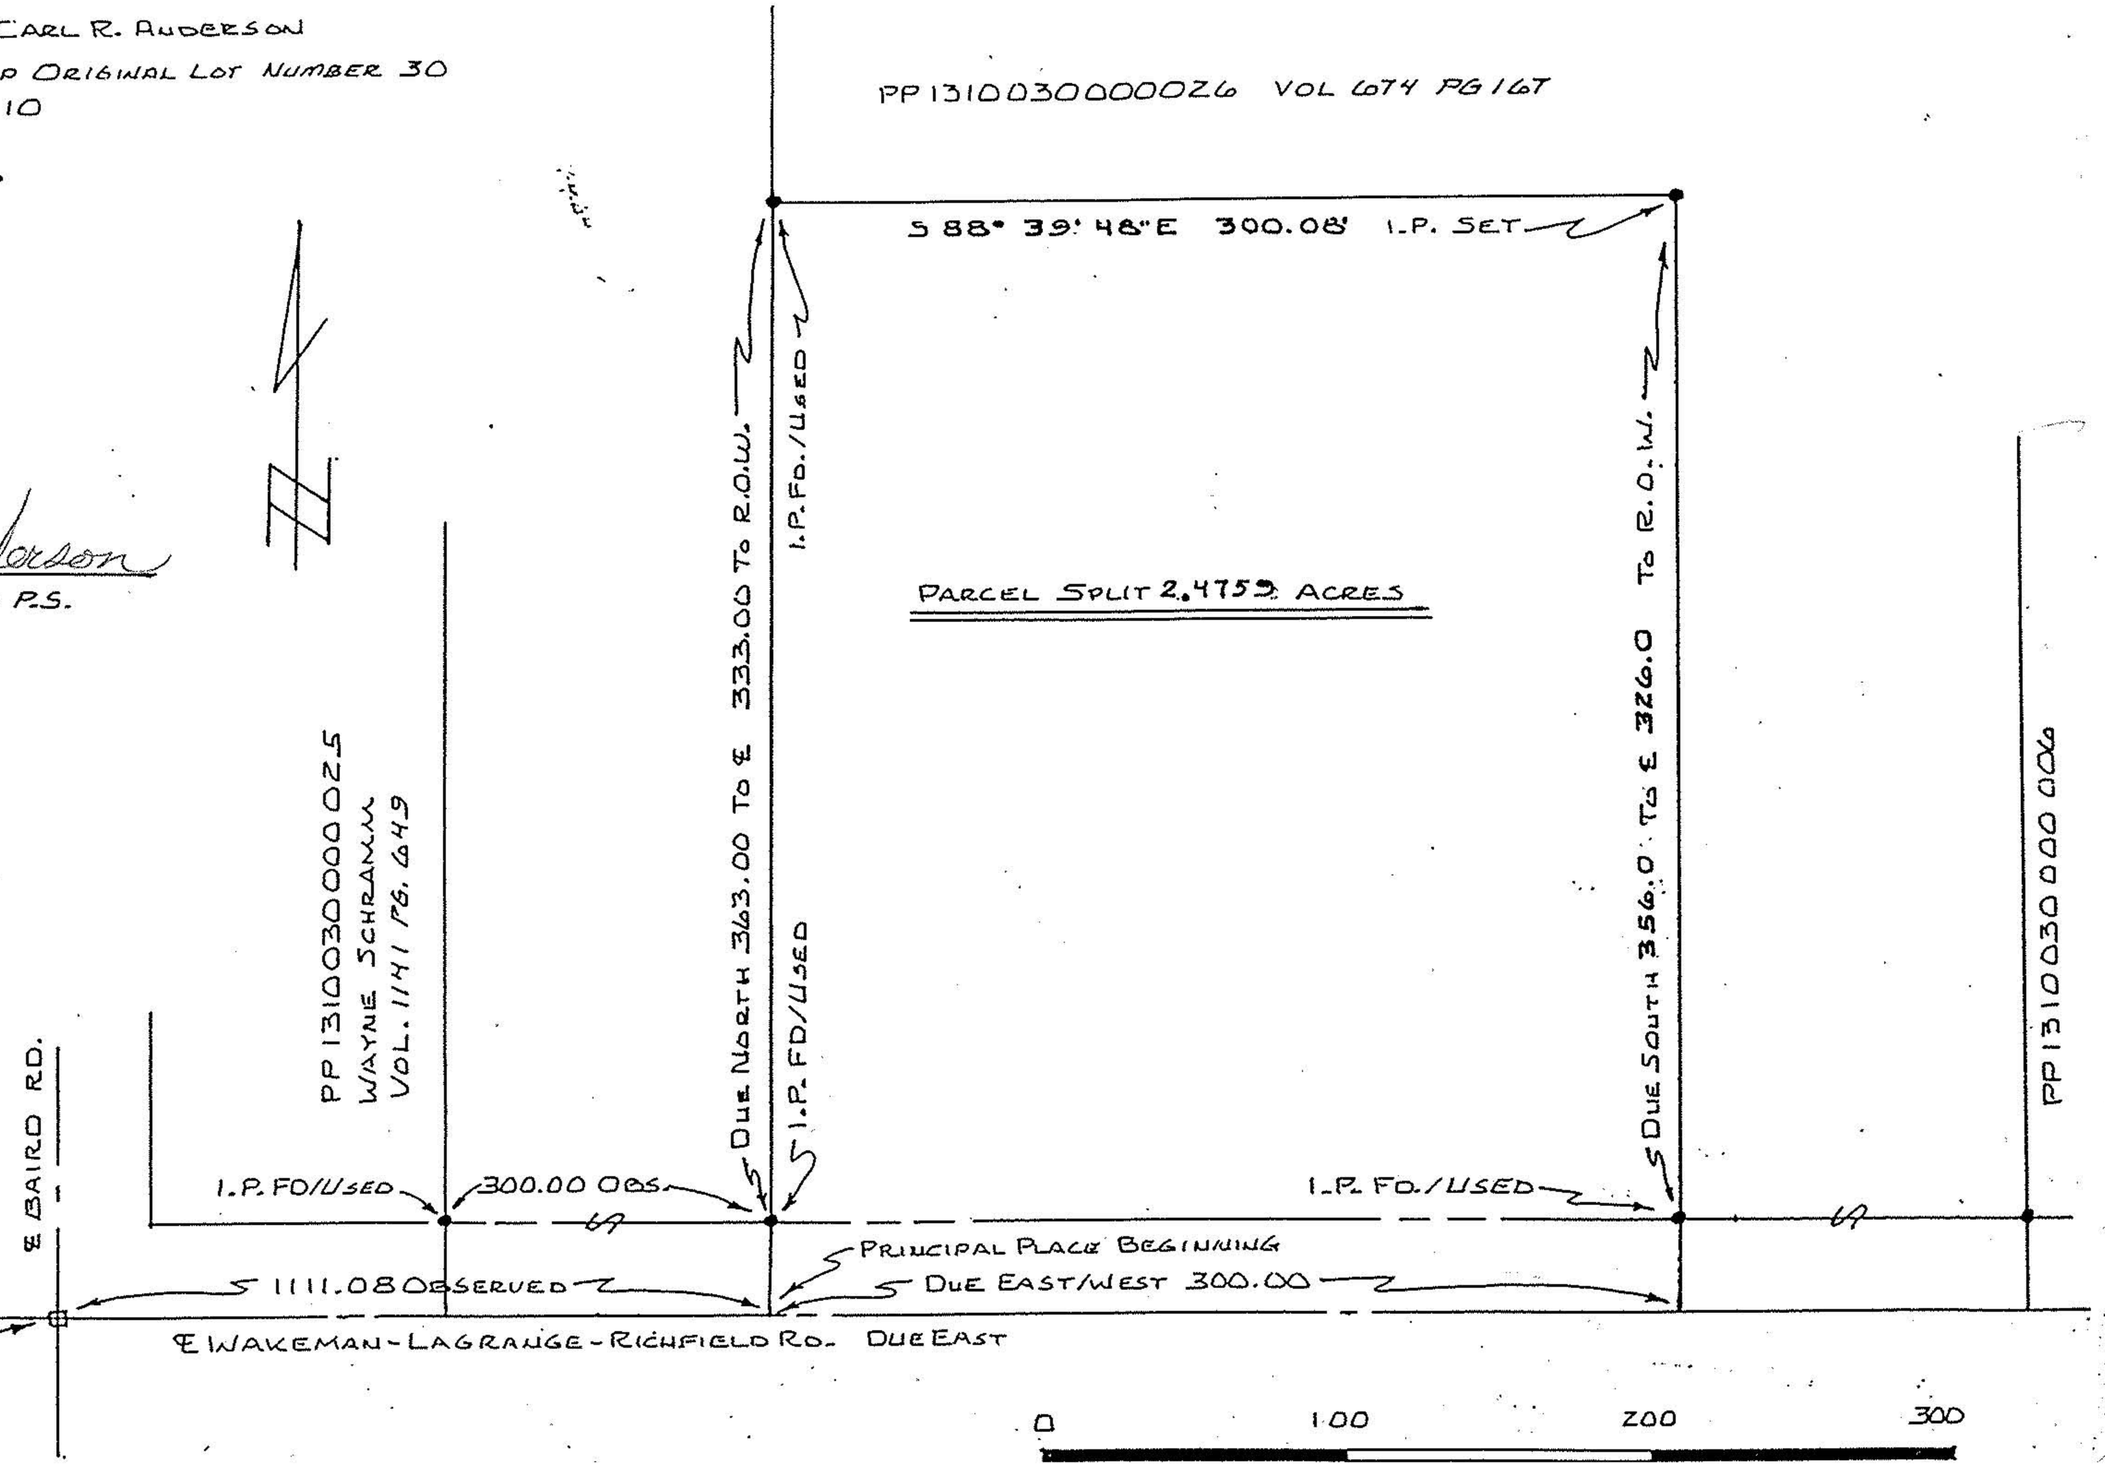
APPROVED
LORAIN CO.
MAP DEPT
DATE 2-8-01
PAGE 13-B
BY J Hatfield
#01-00662