

ERRY W. & DARLENE E. TRIMBLE  
D.V. 1368, Pg. 928

S 87° 55' E 410.72' rec. & meas.

I.P. fd  
(w/ 1/2" GALV.  
Pipe)

I.P. fd.

25'

N 00° 26' 56" E 527.91' calc.  
00 27' 30" W 527.91' rec.

4.9905 AC.

DANIEL & CHRISTINA M. BRASSE  
D.V. 1366, Pg. 470

I.P. fd.  
(bent)


N 87° 55' W 413.17' rec.  
(413.40' meas.)

I.P. Set

30'

S 00° 11' W 528.00'

GORE-ORPHANAGE ROAD - 60'

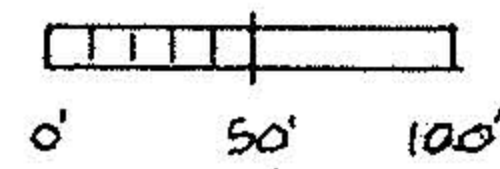

SCALE: 1" = 100'

DECEMBER 1991  
JULY 1991  
1077  
1077  
1077

MAP of BOUNDARY SURVEY

PREPARED FOR: BERNARD D. HOLCOMB

P.P. No 13-11-020-000-012

PART of ORIG. CAMDEN

LORAIN COUNTY

TWP. LOT 20, TRACT II

OHIO

K. E. McCARTNEY & ASSOCIATES

DECEMBER, 1991

#9137115