


Gloria Davidson
907 - 0073

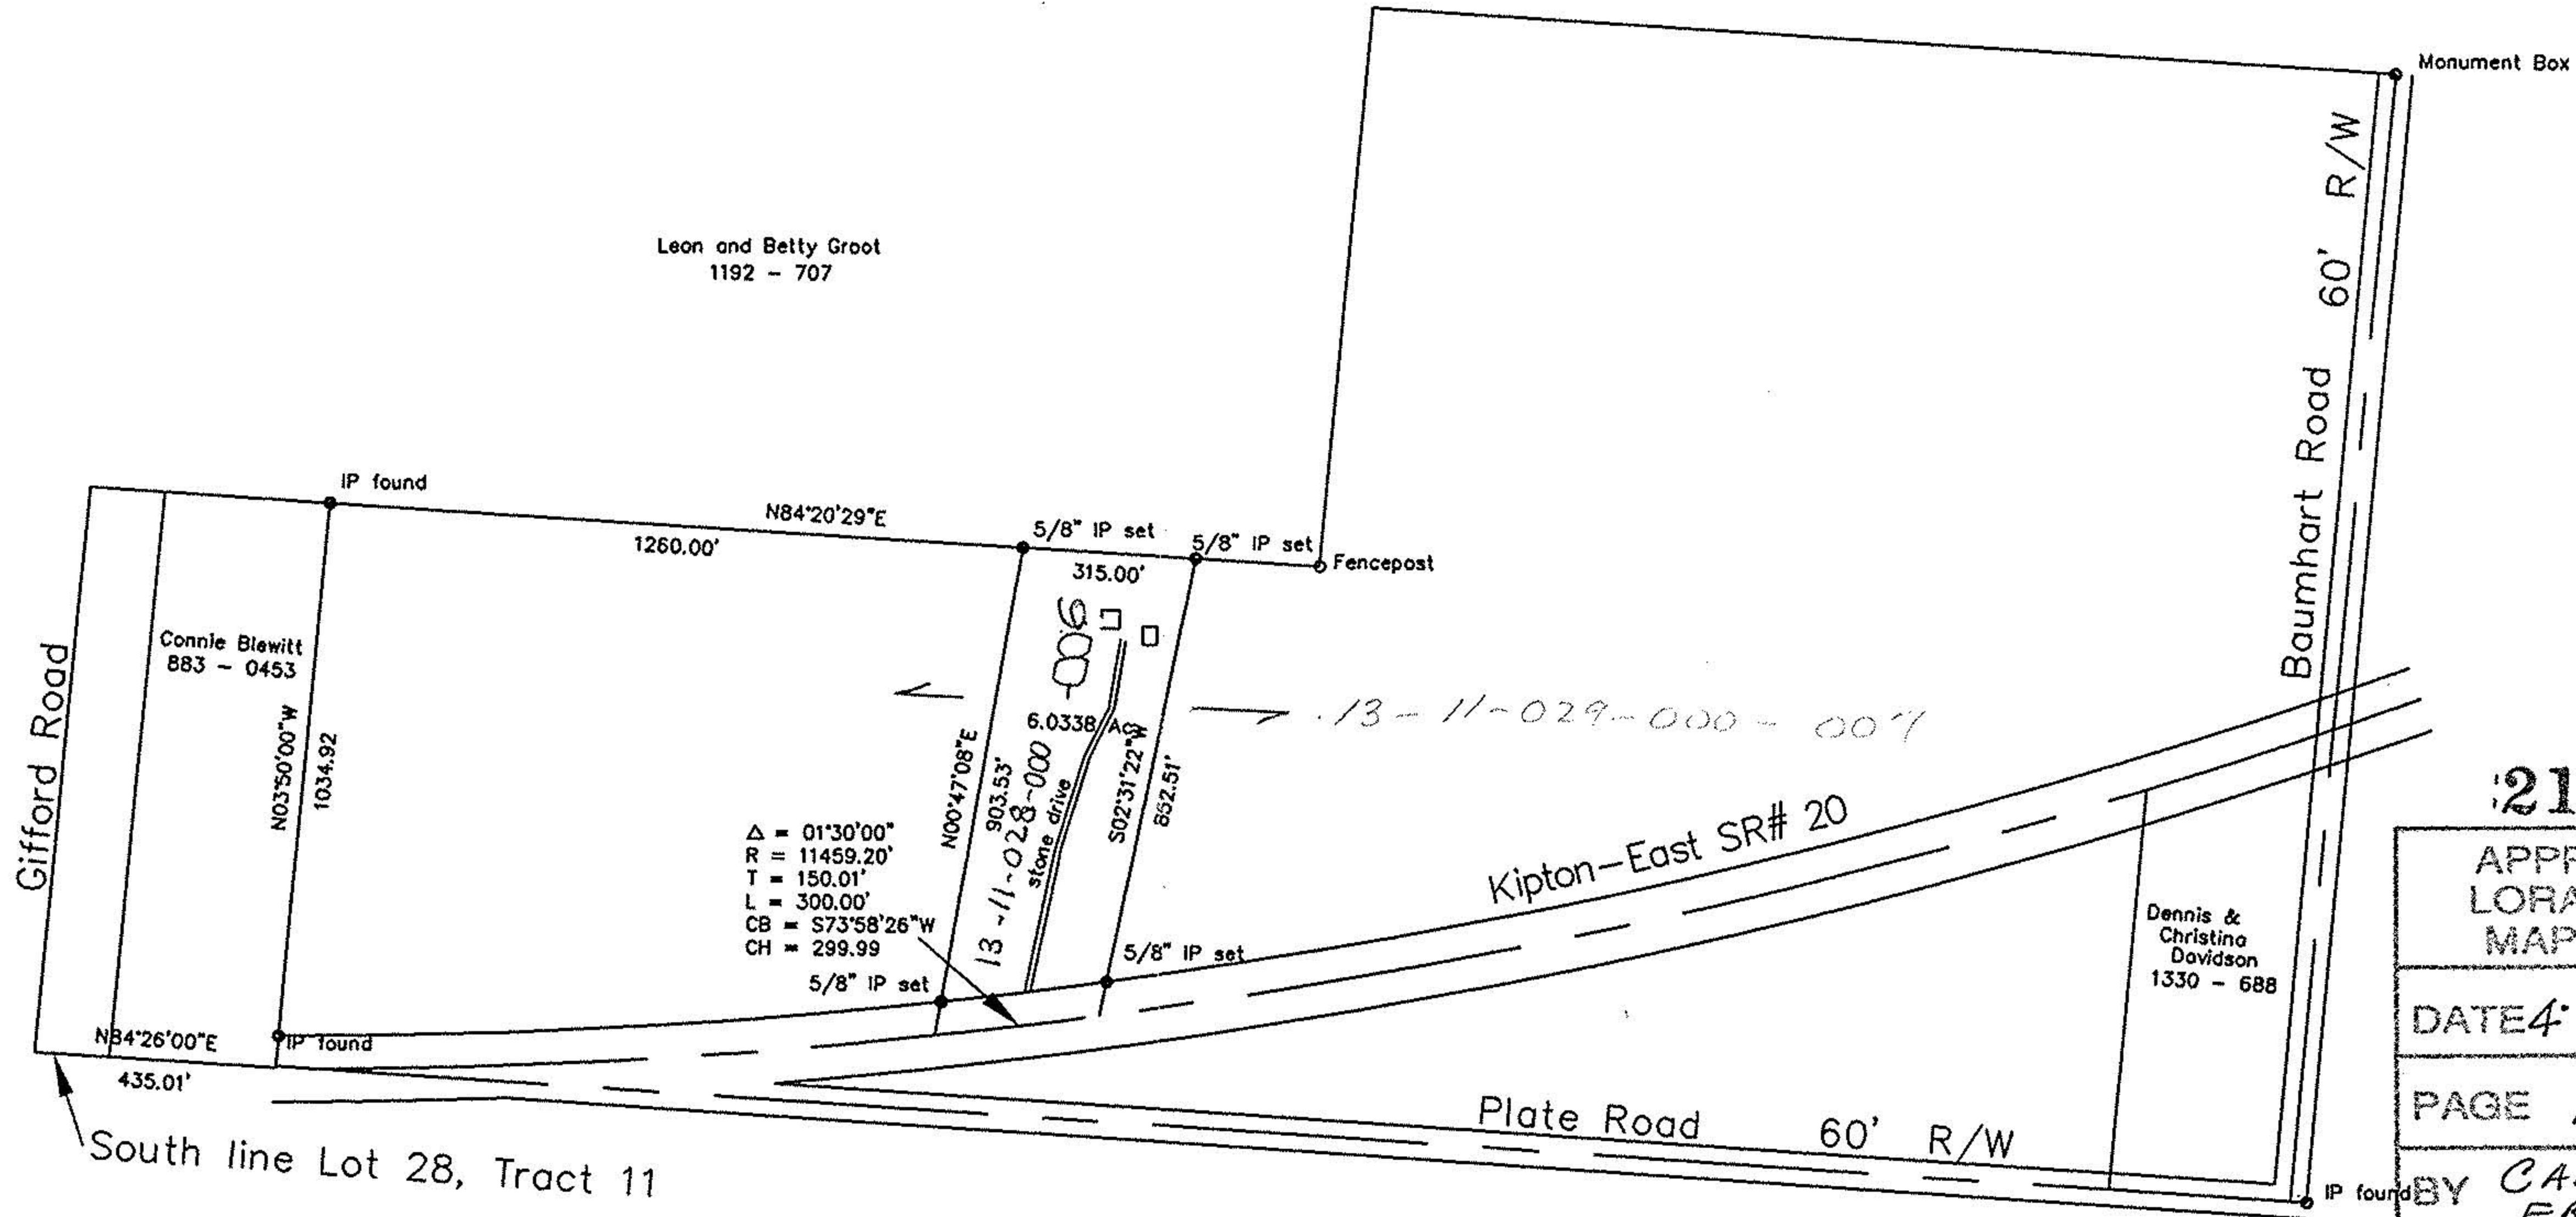

Δ = 01°30'00"
 R = 11459.20'
 T = 150.01'
 L = 300.00'
 CB = S73°58'26"W
 CH = 299.99'

21741


APPROVED
LORAIN CO.
MAP DEPT

DATE 4-18-96

PAGE 13-D

BY CAROLYN
FRANCIS

21741

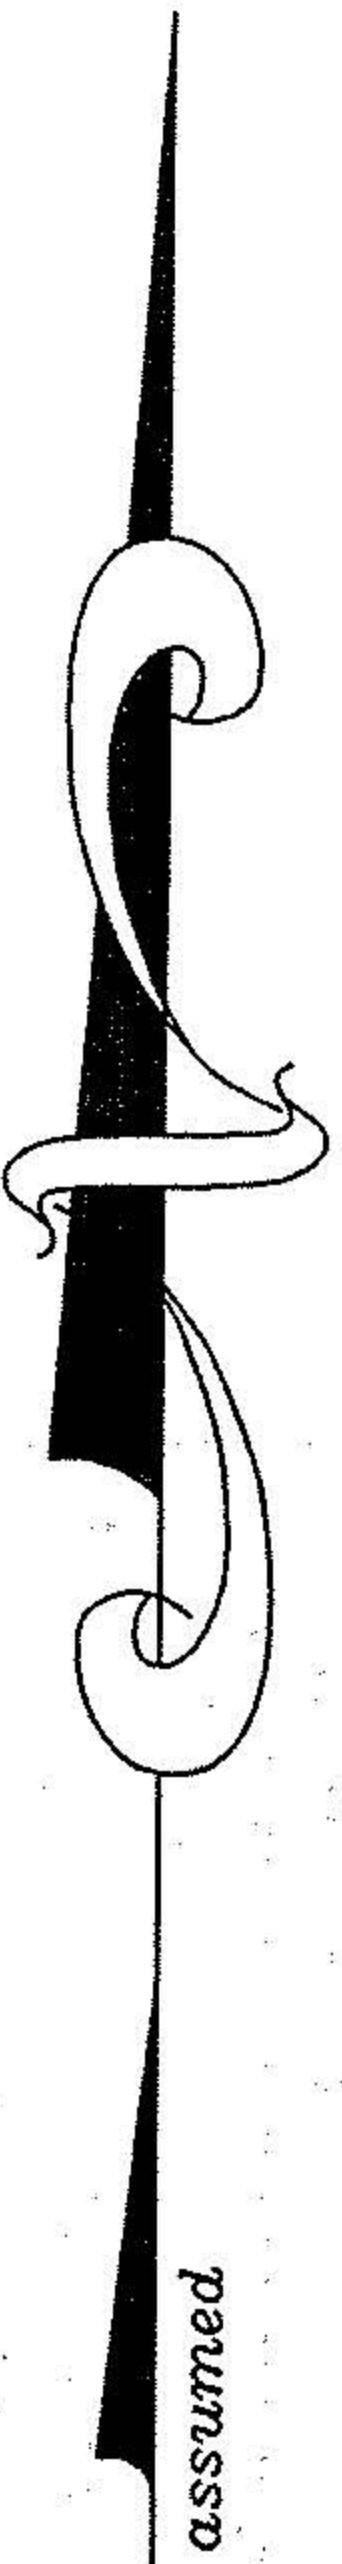

GRAPHIC SCALE



(IN FEET)
1 inch = 400 ft.



Carl Feick
Carl M. Feick P.S. 7035

FEICK SURVEYORS
224 East Water Street, Sandusky, Ohio 44870, 419-625-3241

DRAWN BY: CMF DATE: 10/12/95

JOB NO.: S4737 SHEET 1 OF 1

Plat of Survey

Chuck Davidson

49300 Rt. 20 West
Tract 11, Lots 28 & 29
Camden Twp., Lorain Co. Ohio