


assumed.

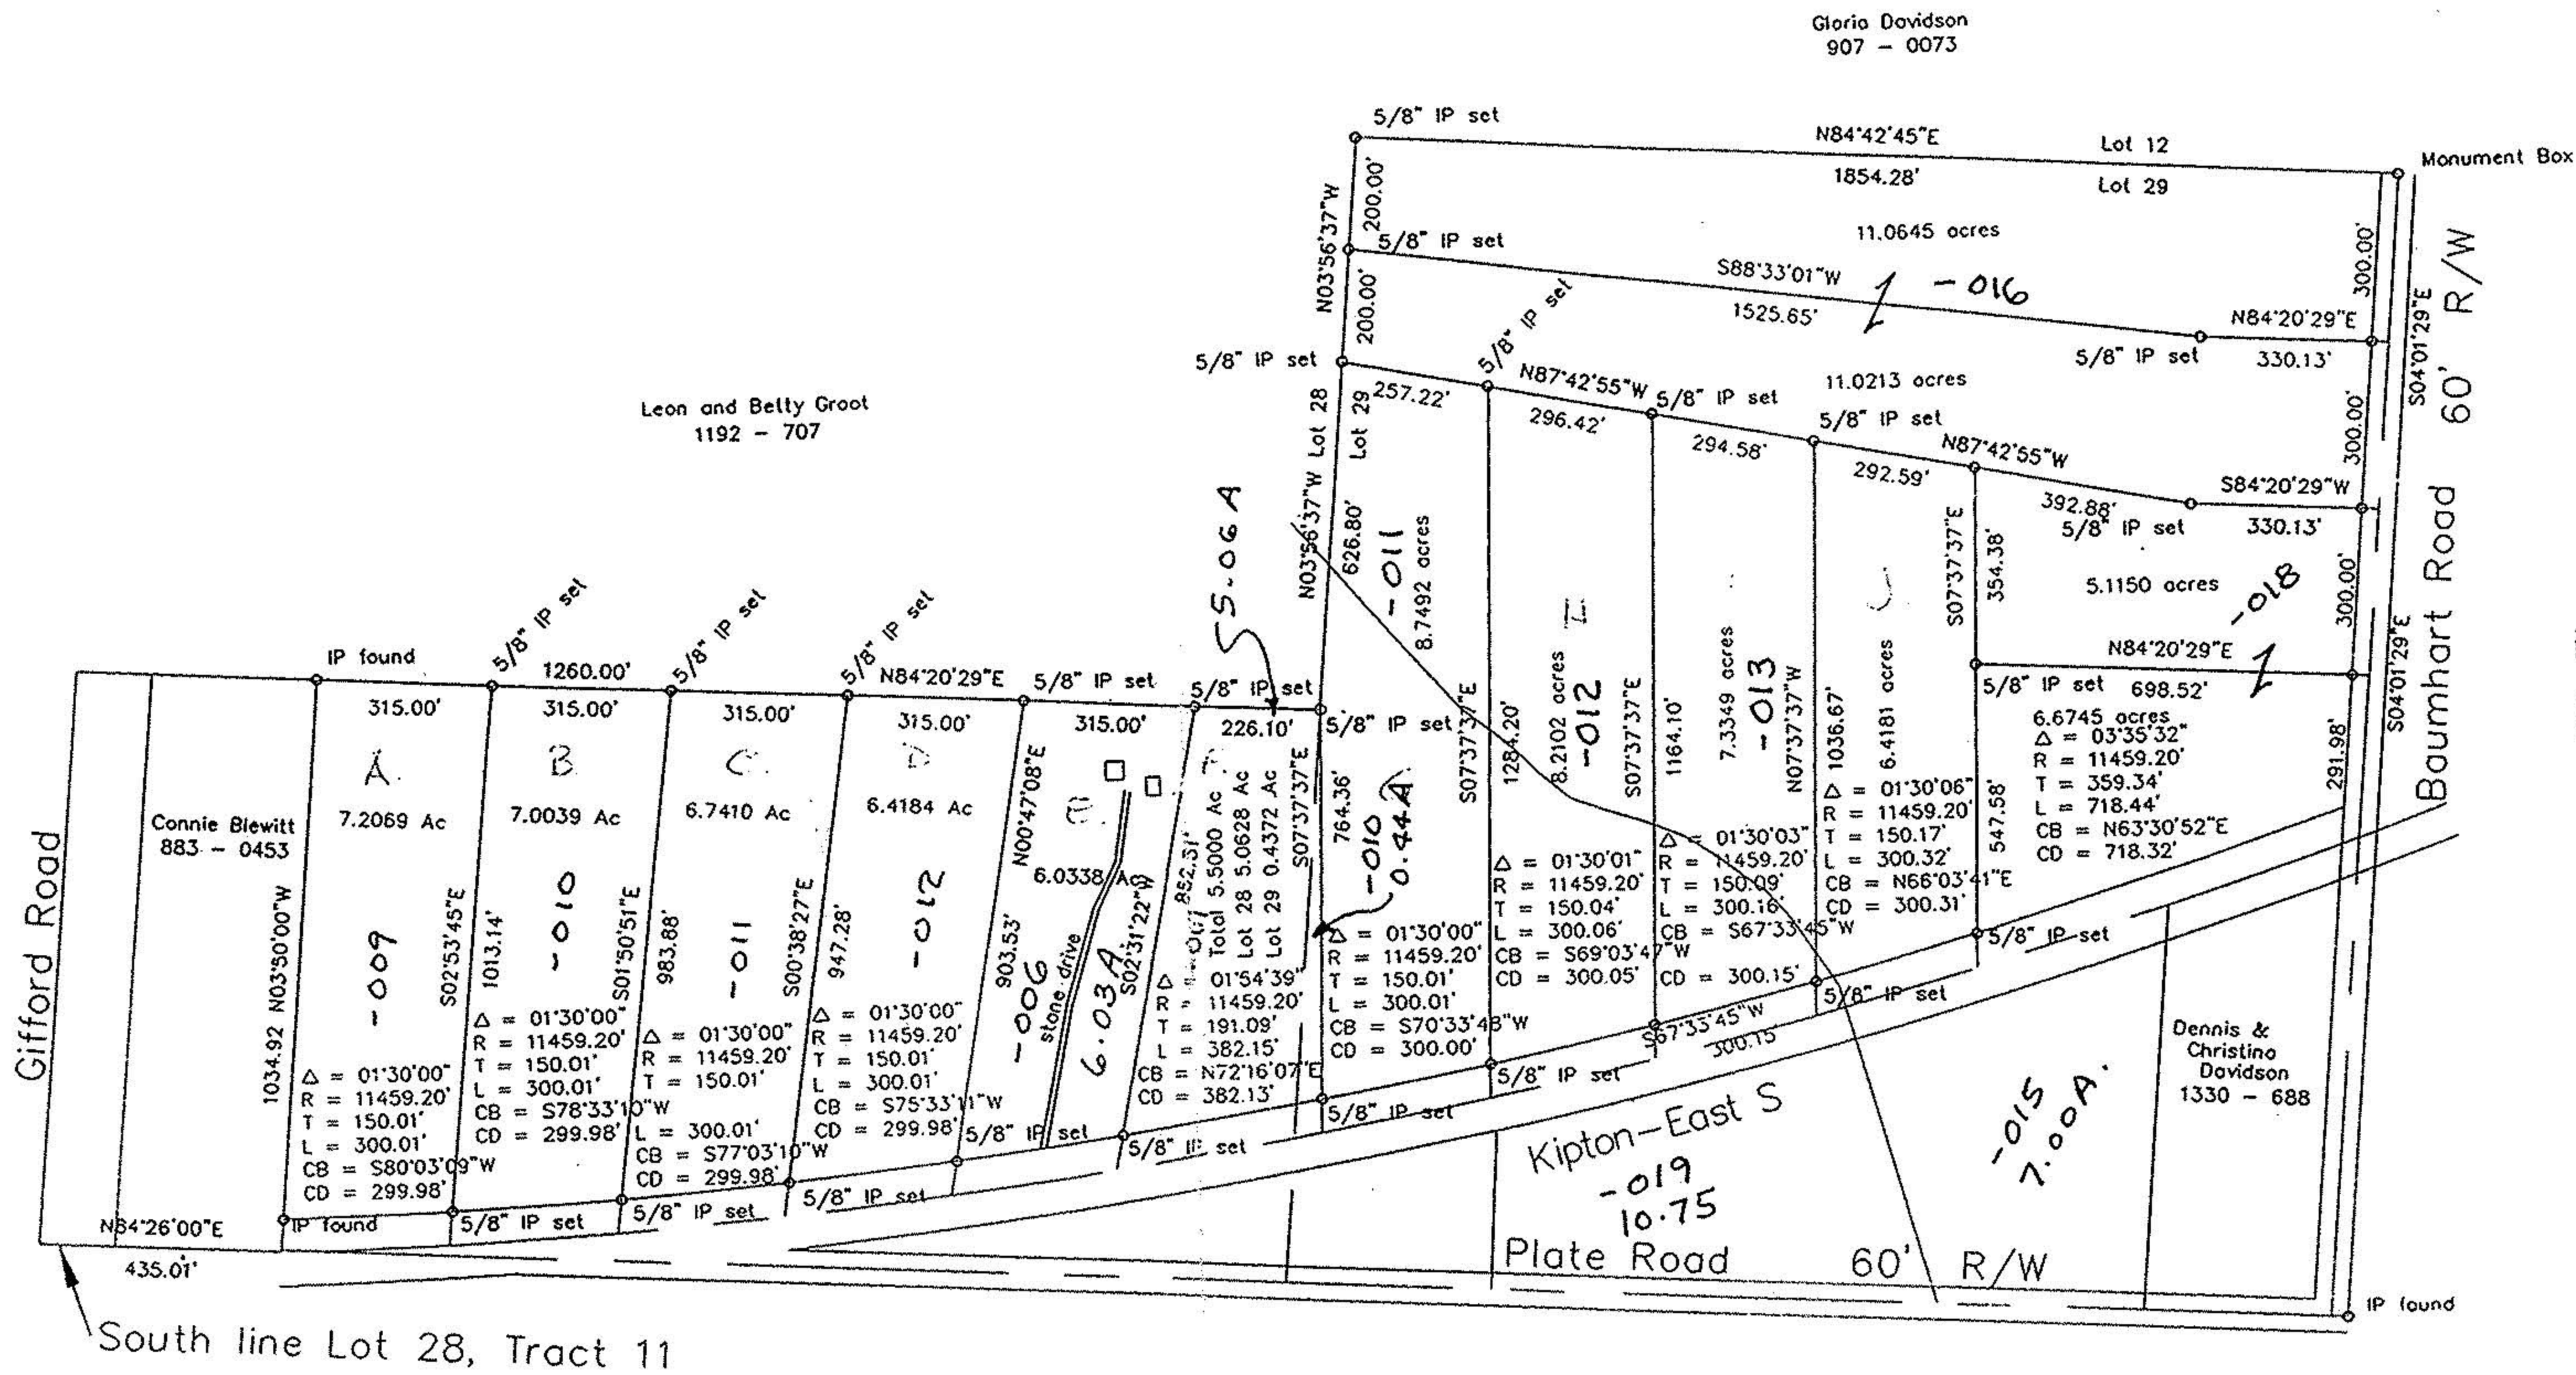

#21058
 11-15-96
 B-D
 11-15-96

GRAPHIC SCALE



(IN FEET)
 1 inch = 400 ft.



Carl Feick
 Carl M. Feick P.S. 7035

FEICK SURVEYORS
 224 East Water Street, Sandusky, Ohio 44870, 419-625-3241

DRAWN BY: CMF DATE: 10/12/95
 JOB NO.: S4737 SHEET 1 OF 1

Plat of Survey
 Chuck Davidson
 49300 Rt. 20 West
 Tract 11, Lots 28 & 29
 Camden Twp., Lorain Co. Ohio