


MAP OF SURVEY, LOT SPLIT AND ASSEMBLY


PREPARED FOR

ANDREW S. AND LINDA M. BISKUP

SITUATED IN THE TOWNSHIP OF CAMDEN, COUNTY OF
LORAIN, STATE OF OHIO AND BEING KNOWN AS PART
OF TRACT 8, LOT 3 AND TRACT 9, LOT 39.

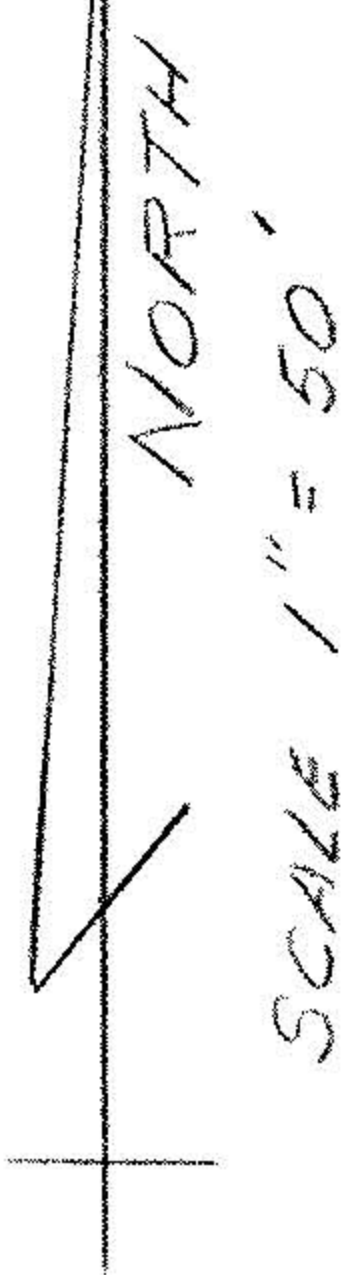

USE
SOUTH
PIPER
IRON
PIN
052220

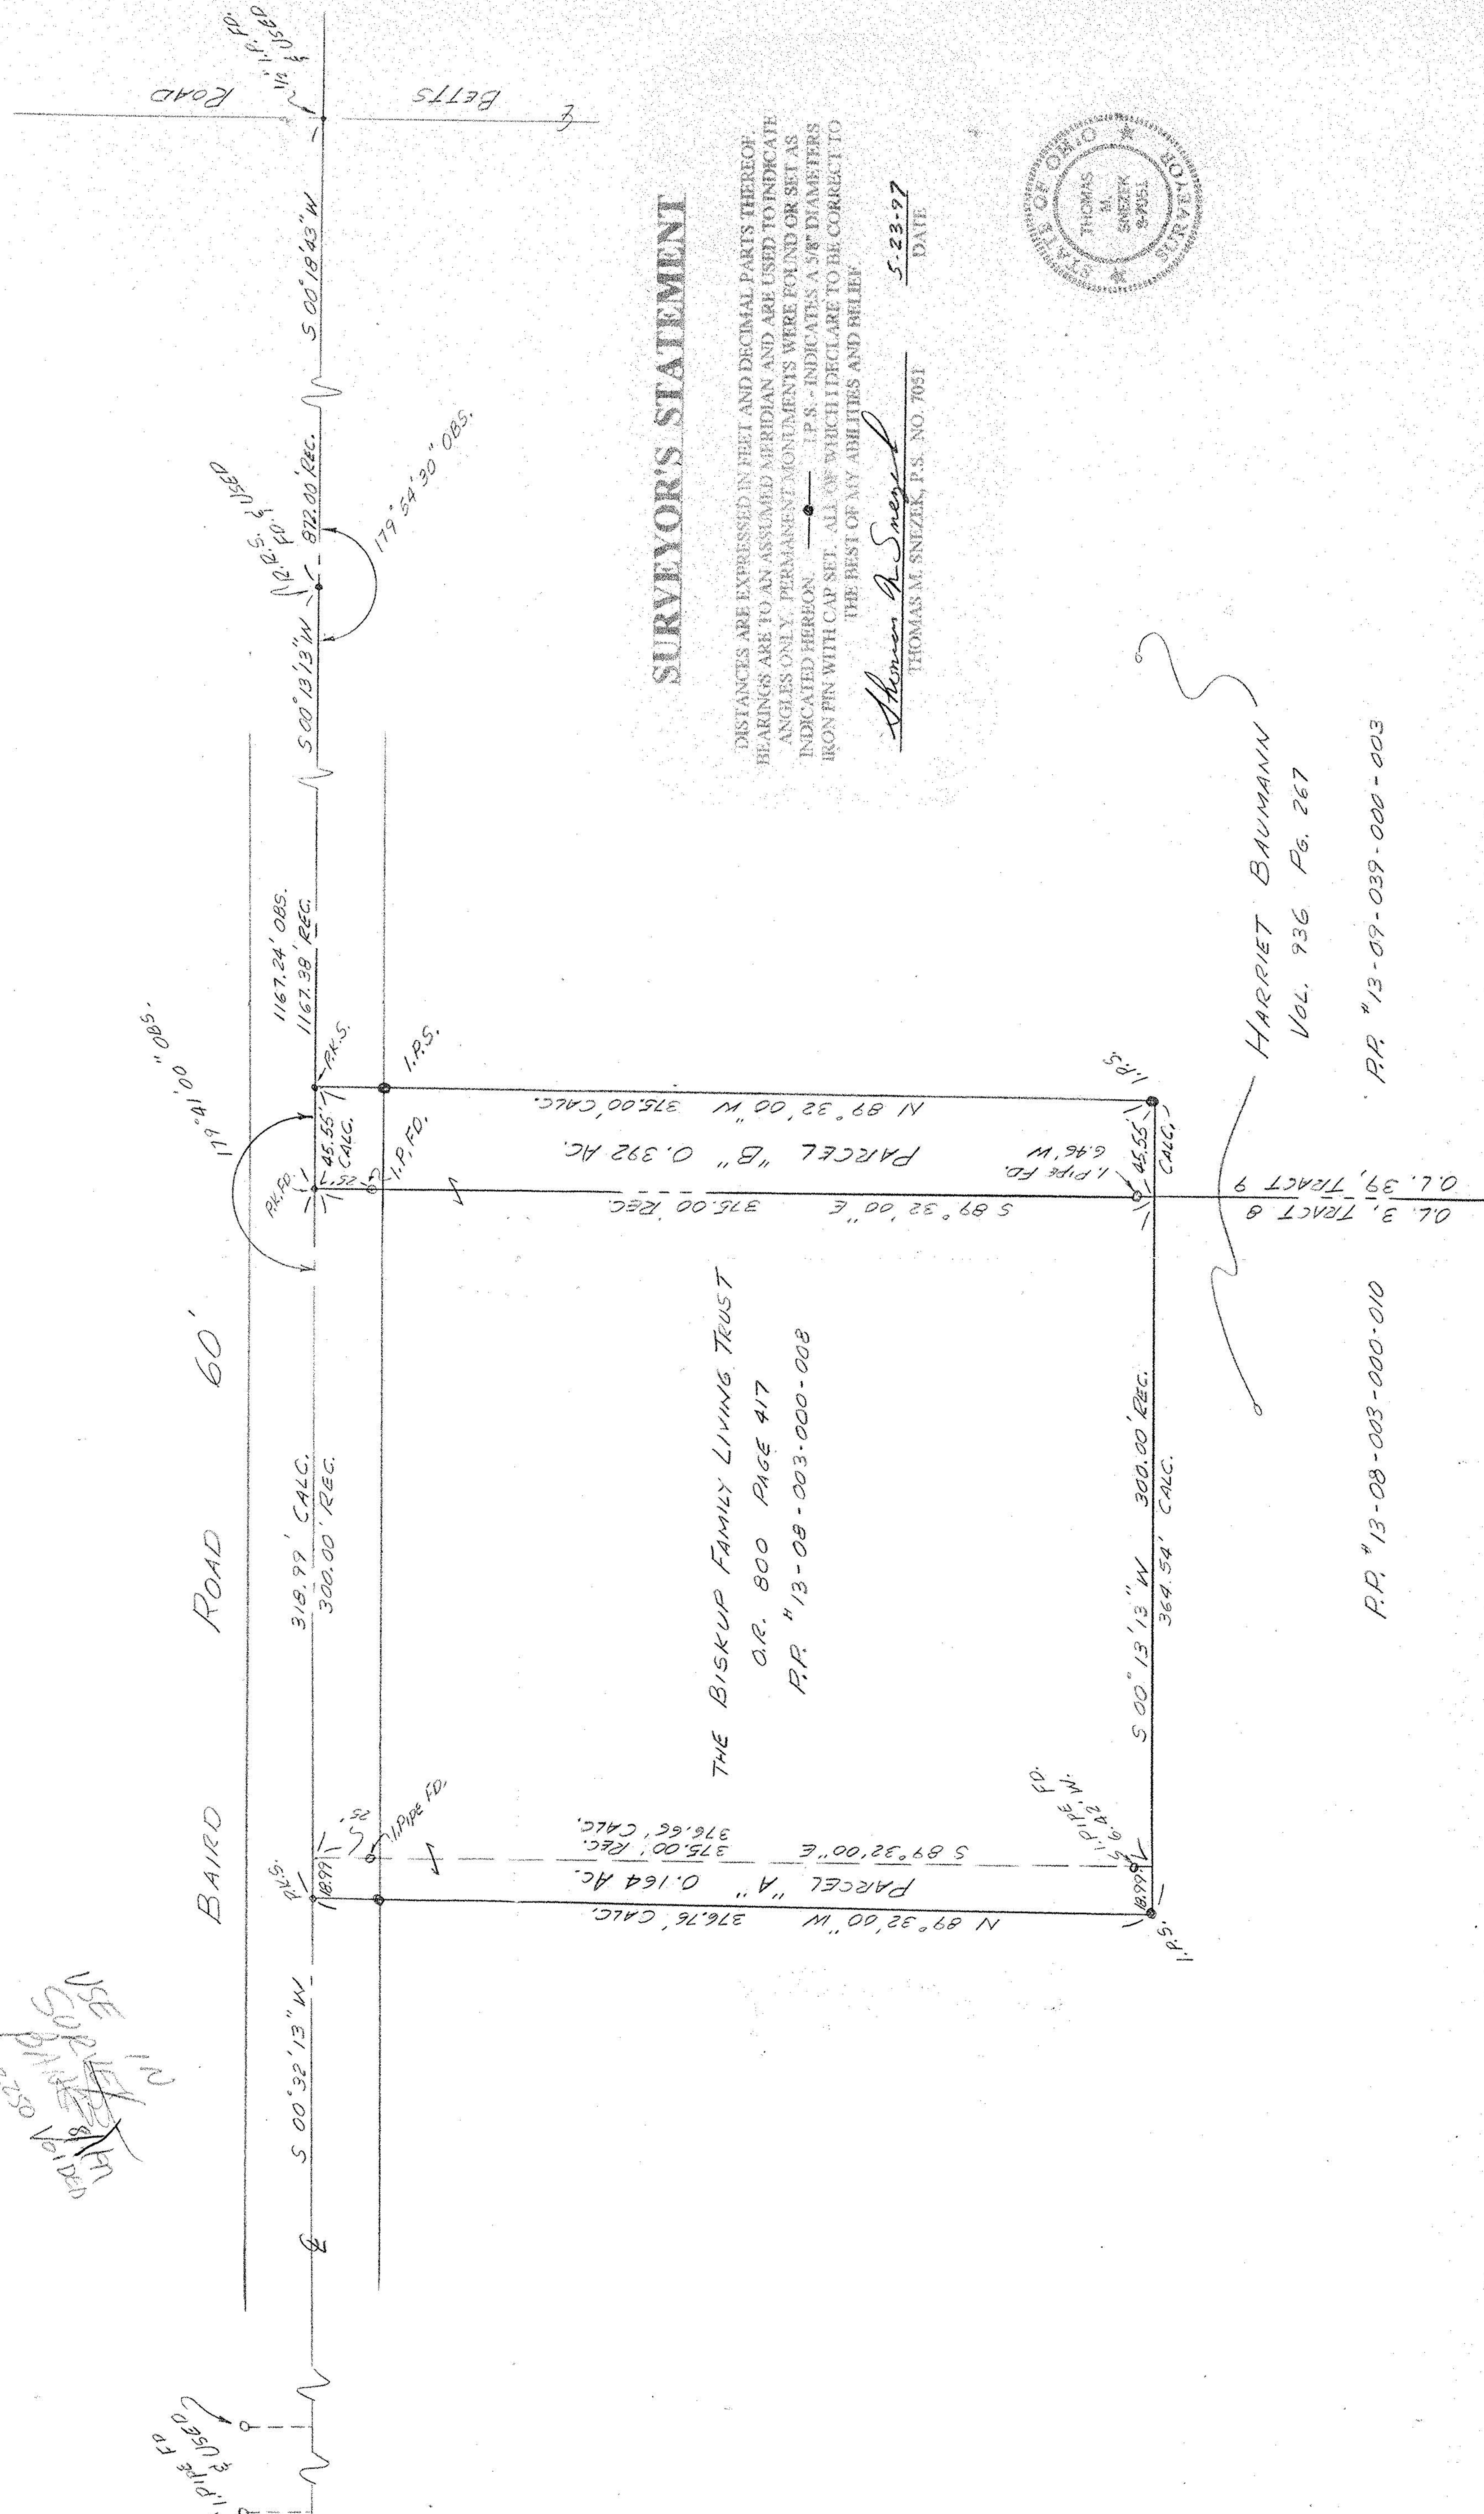


SURVEYOR'S STATEMENT

DISTANCES ARE EXPRESSED IN FEET AND DECIMAL PARTS THEREOF.
BEARINGS ARE TO AN ASSUMED MERIDIAN AND ARE USED TO INDICATE
ANGLES ONLY. PERMANENT MONUMENTS WERE FOUND OR SET AS
INDICATED HEREON. I.P.S. INDICATES A 5/8" DIAMETER
IRON PIN WITH CAP SET. ALL OF WHICH I DECLARE TO BE CORRECT TO
THE BEST OF MY ABILITIES AND BELIEF

Thomas M. Sneyek
THOMAS M. SNEYEK, P.S. NO. 7051

5.23.97
DATE

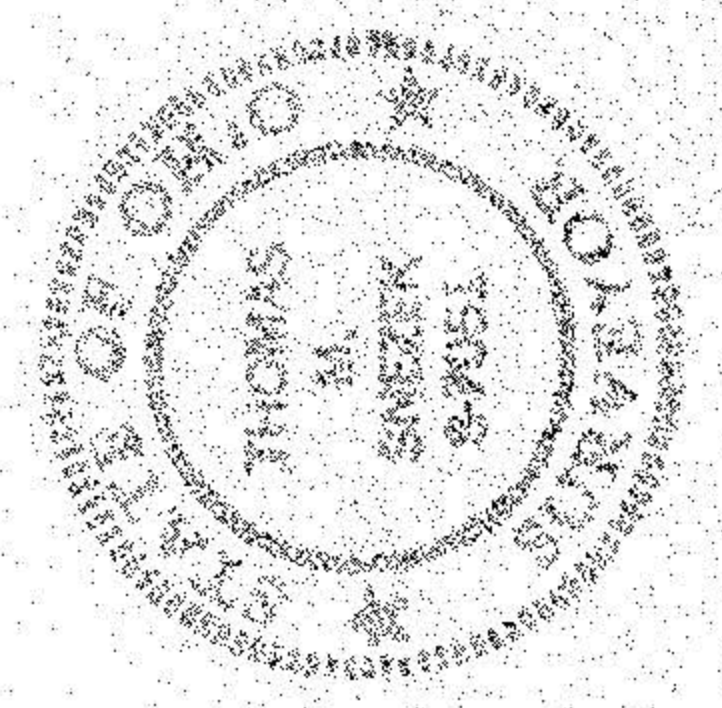

HARRIET BAUMANN
VOL. 936 Pg. 267

P.P. # 13-08-003-000-010

P.P. # 13-09-039-000-003