

OL 44
TR-9

L. 8 TR. 8


13-08-009-000-005

13-08-009

13-08-009

13-4

OL 8 TRACT A. 1. 8

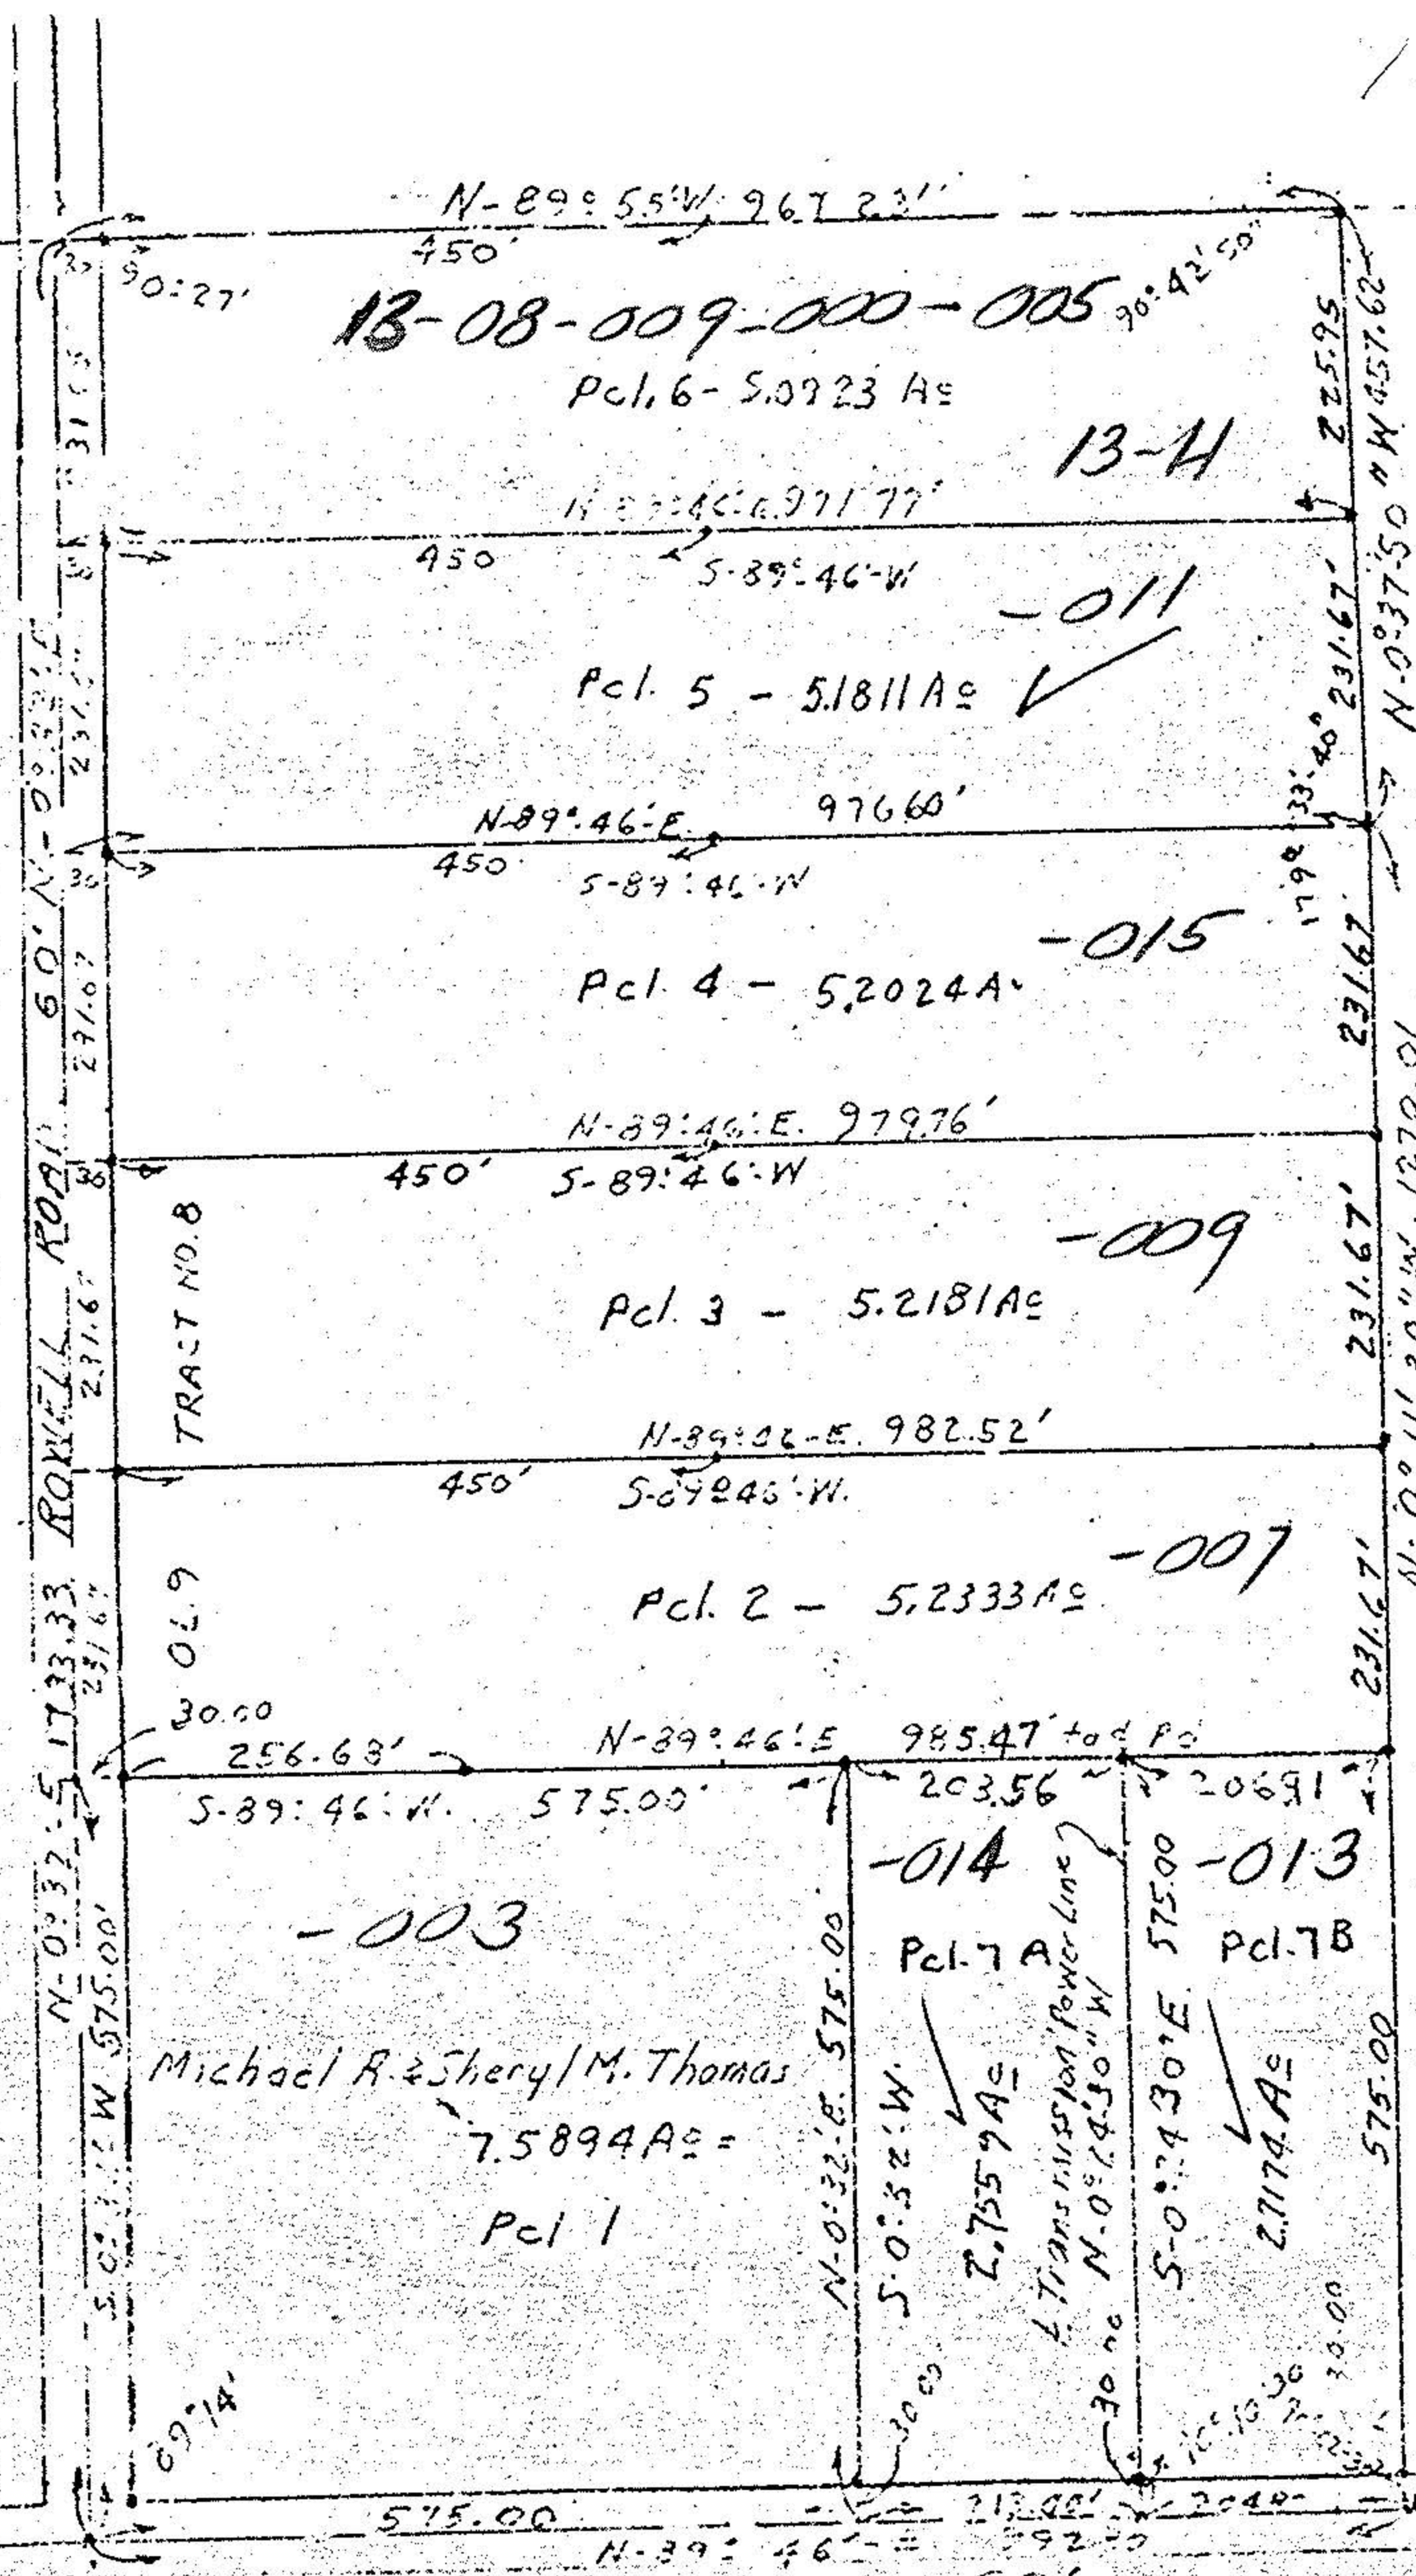

1242
OL 15 TR

13-08-009-000-005
Pct. 6 - 5.0923 Ac

13-4

Pct. 5 - 5.1811 Ac

-011

Pct. 4 - 5.2024 Ac

-015

Pct. 3 - 5.2181 Ac

-009

Pct. 2 - 5.2333 Ac

-007

Michael R. & Sheryl M. Thomas
7.5894 Ac =
Pct. 1

Pct. 7A

2.7559 Ac

Pct. 7B

2.7174 Ac

Lewis R. & Jeannette I. Kolb
D. Volume 531 Pg. 81 Nov. 21-1951

OL 9 TRACT B

CAMDEN TWP.

PITTSFIELD TWP.

MAP OF SURVEY OF 75294 ACRES
FOR FRANKLIN B. & ROSS L. McHORE AC.

PART OF ORIGINAL LOT 9 TRACT NO. 8

CAMDEN TOWNSHIP - LORAIN COUNTY OHIO

Scale 1" = 200' MAY-10-1972


REAR