




LAUNDON . SIMON . CAHL & ASSOC. INC.
 CONSULTING ENGINEERS & SURVEYORS
 ELYRIA, OHIO 44035

SURVEY FOR:

JAMES E. & ELLEN A.
 PATTERSON

Orig. Lot 37	City of	Date 12-17-90 Scale 1"=100'
Orig. Sec	Village of	Dwn. by R.G.S. Chkd. by K.B.
Tract 9	County of LORAIN	Job No. 90-1991 F.B. 218/6
Township of CAMDEN	State of OHIO	Printed

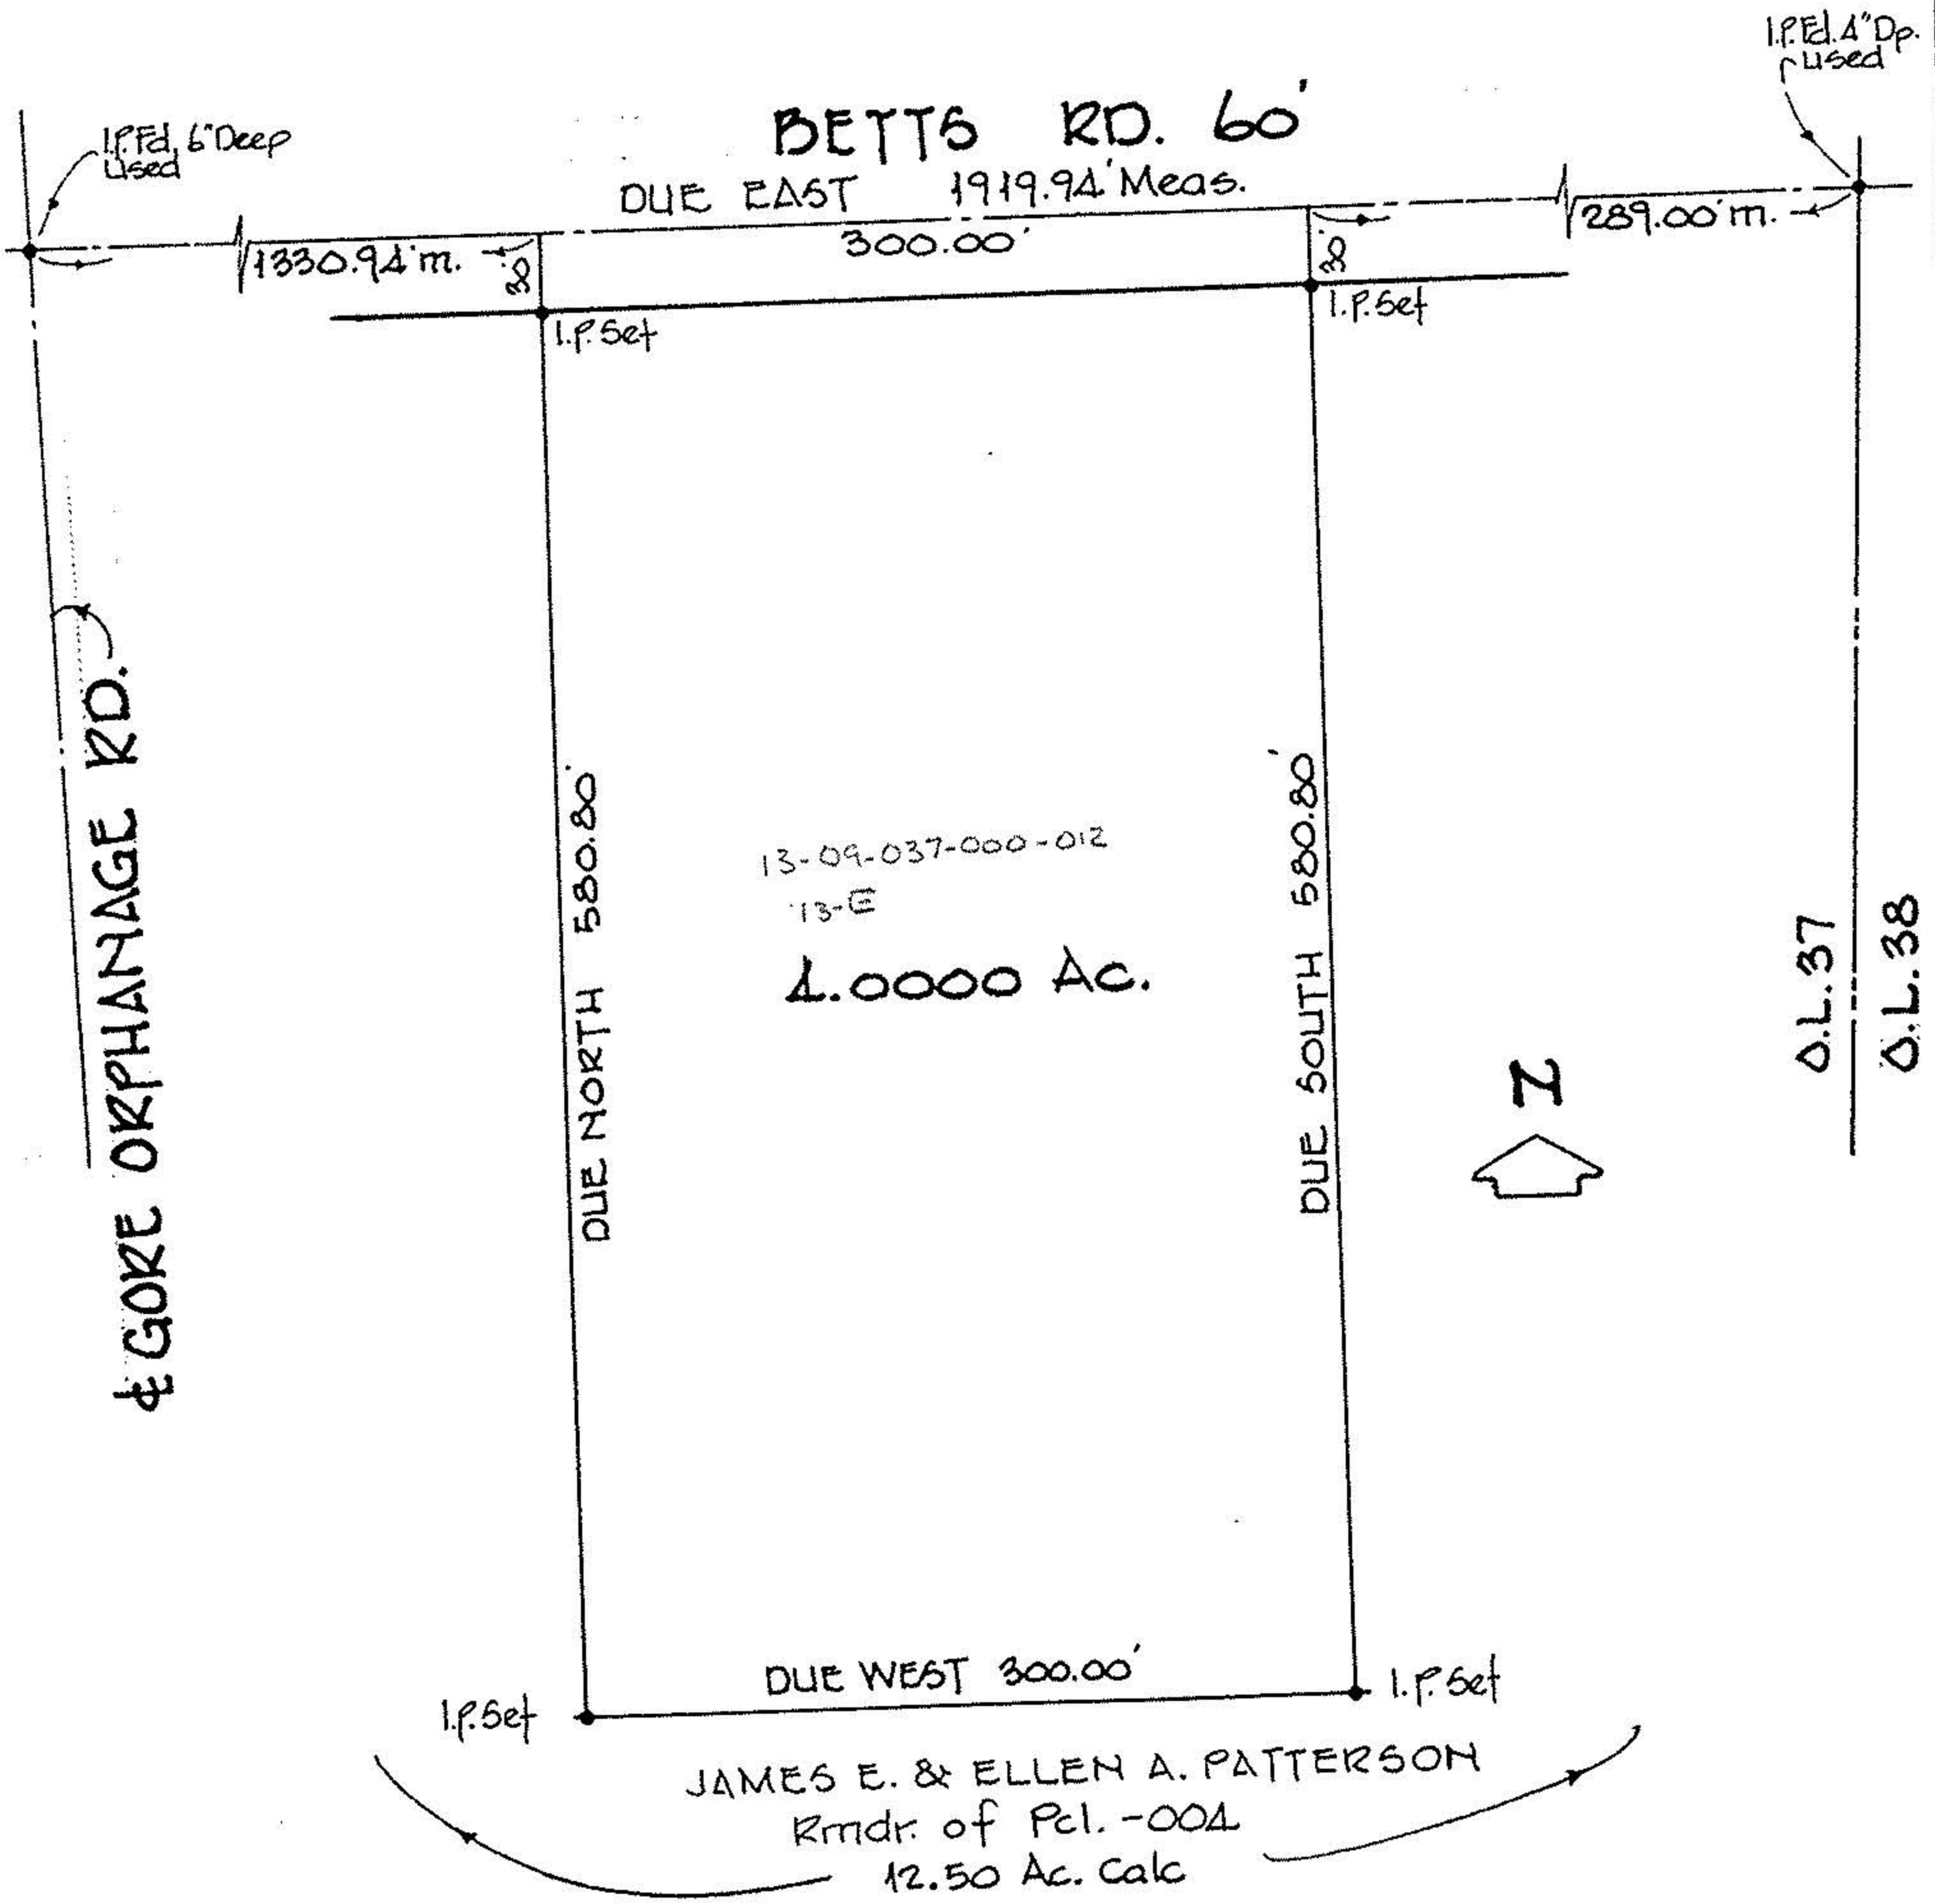


BETTS RD. 60'

DUE EAST 1919.94' Meas.

1330.94'

300.00'

289.00'

I.P. Set

I.P. Set

DUE NORTH 580.80'

DUE SOUTH 580.80'

13-09-037-000-012
13-E

4.0000 Ac.



D.L. 37

D.L. 38

DUE WEST 300.00'

I.P. Set

I.P. Set

JAMES E. & ELLEN A. PATTERSON
 Rmldr. of Pl. -004
 12.50 Ac. Calc