MAP OF SURVEY, LOT SPLIT AND ASSEMBLY

PREPARED FOR

CARL E. AND JUDITH ANN SMITH

SITUATED IN THE TOWNSHIP OF CAMDEN, COUNTY OF LORAIN, STATE OF OHIO
AND BEING KNOWN AS PART OF ORIGINAL CAMDEN TOWNSHIP LOT 37, TRACT 9

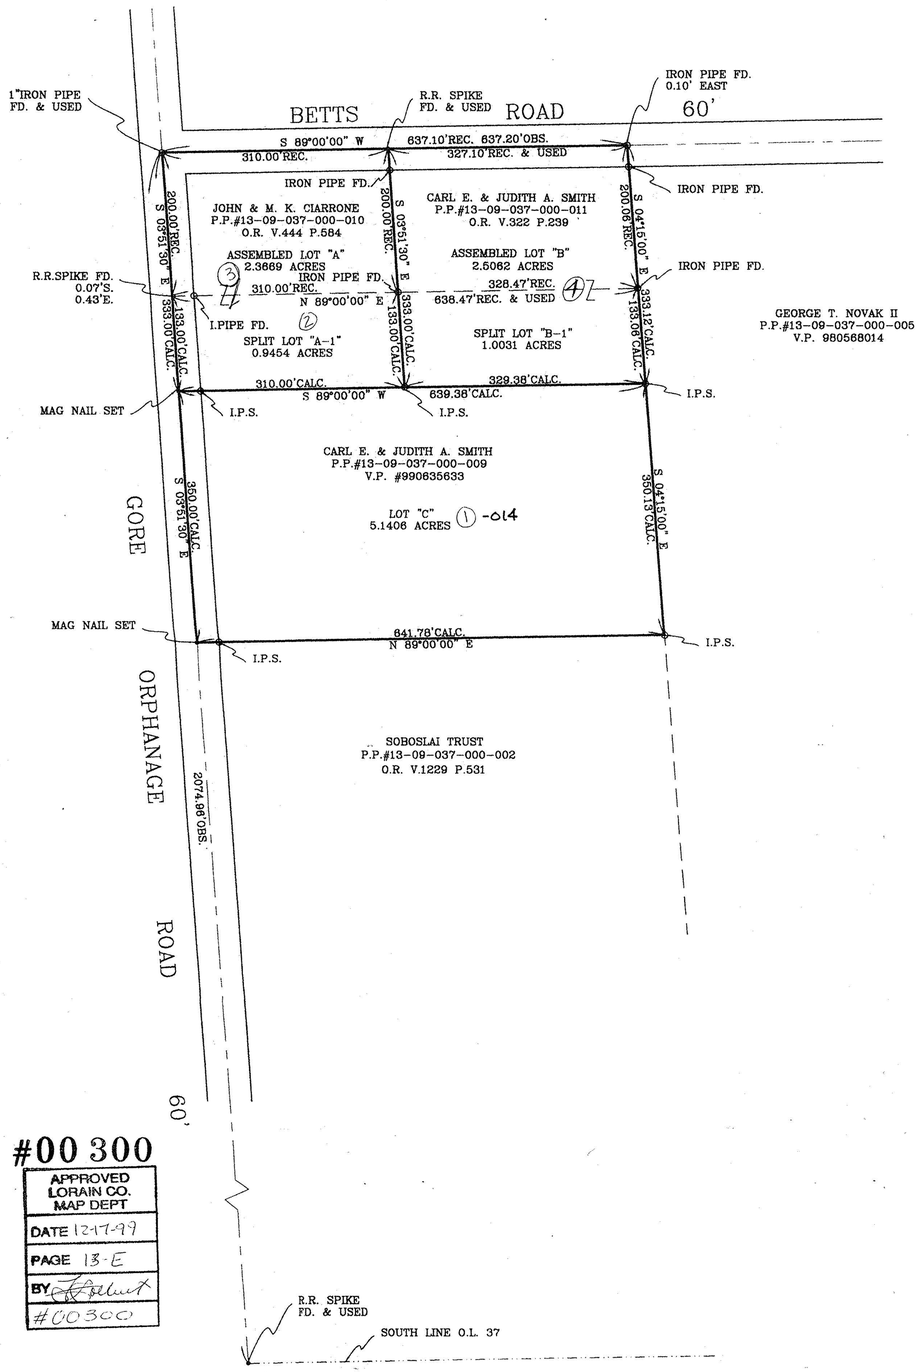

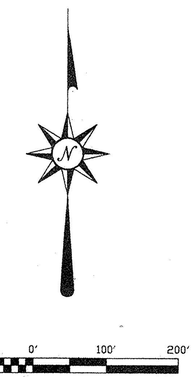

SCALE: 1" = 100'

SURVEYOR'S STATEMENT

DISTANCES ARE EXPRESSED IN FEET AND DECIMAL PARTS THEREOF. BEARINGS ARE TO AN ASSUMED MERIDIAN AND ARE USED TO INDICATE ANGLES ONLY. PERMANENT MONUMENTS WERE FOUND OR SET AS INDICATED HEREON. —o— I.P.S. INDICATES A 5/8" IRON PIN WITH CAP SET. ALL OF WHICH I DECLARE TO BE CORRECT TO THE BEST OF MY ABILITIES AND BELIEFS.

Thomas M. Snezek
THOMAS M. SNEZEK, R.L.S. #7051

11-12-99
DATE

STATE OF OHIO
THOMAS M. SNEZEK
S-7051
SURVEYOR

#00 300

APPROVED LORAIN CO. MAP DEPT
DATE 12-17-99
PAGE 13-E
BY
#00300

PROJECT NO. 9923 11/6/99