LAUNDON • SIMON • CAHL & ASSOC., INC.
CONSULTING ENGINEERS & SURVEYORS
110 MIDDLE AVE., ELYRIA, O. 44035

SURVEY FOR:

WHITE BROS. PARTNERSHIP

Orig. Lot 16	City of	Date 6-3-96 Scale 1"=100'
Orig. Sec	Village of	Dwn. by R.G.S. Chkd. by R.C.
Tract 9	County of LORAIN	Job No. 96-2864 F.B. 239/19
Township of CAMDEN	State of OHIO	Printed

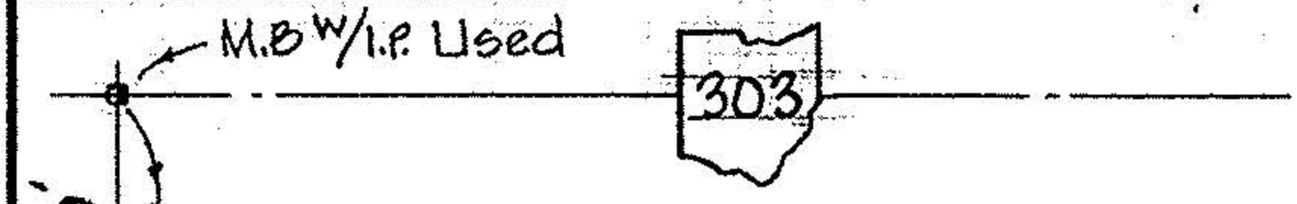

N

RD. 60'

BAIRD

3584.21'M.

HUGH LEONARD & DELORES A. WHITNEY
D.V. 1031 P. 780

30'

S. 89°-18'-30" W.
581.00'

I.P. Set

I.P. Set

DUE SOUTH
300.00'

4.0011 Ac.

300.00
DUE NORTH

ELY. LN. O.L. 16

I.P. Set

N. 89°-18'-30" E. 581.00'

I.P. Set

30'

RMDR. of -003 26.00 Ac. Calc.
WHITE BROTHERS PARTNERSHIP
O.R.V. 975 P. 394

NOTE:
BRGS. ARE ASSUMED AND USED TO DESCRIBE ANGLES ONLY

30'

I.P. Used for ℄

O.L. 16
O.L. 21