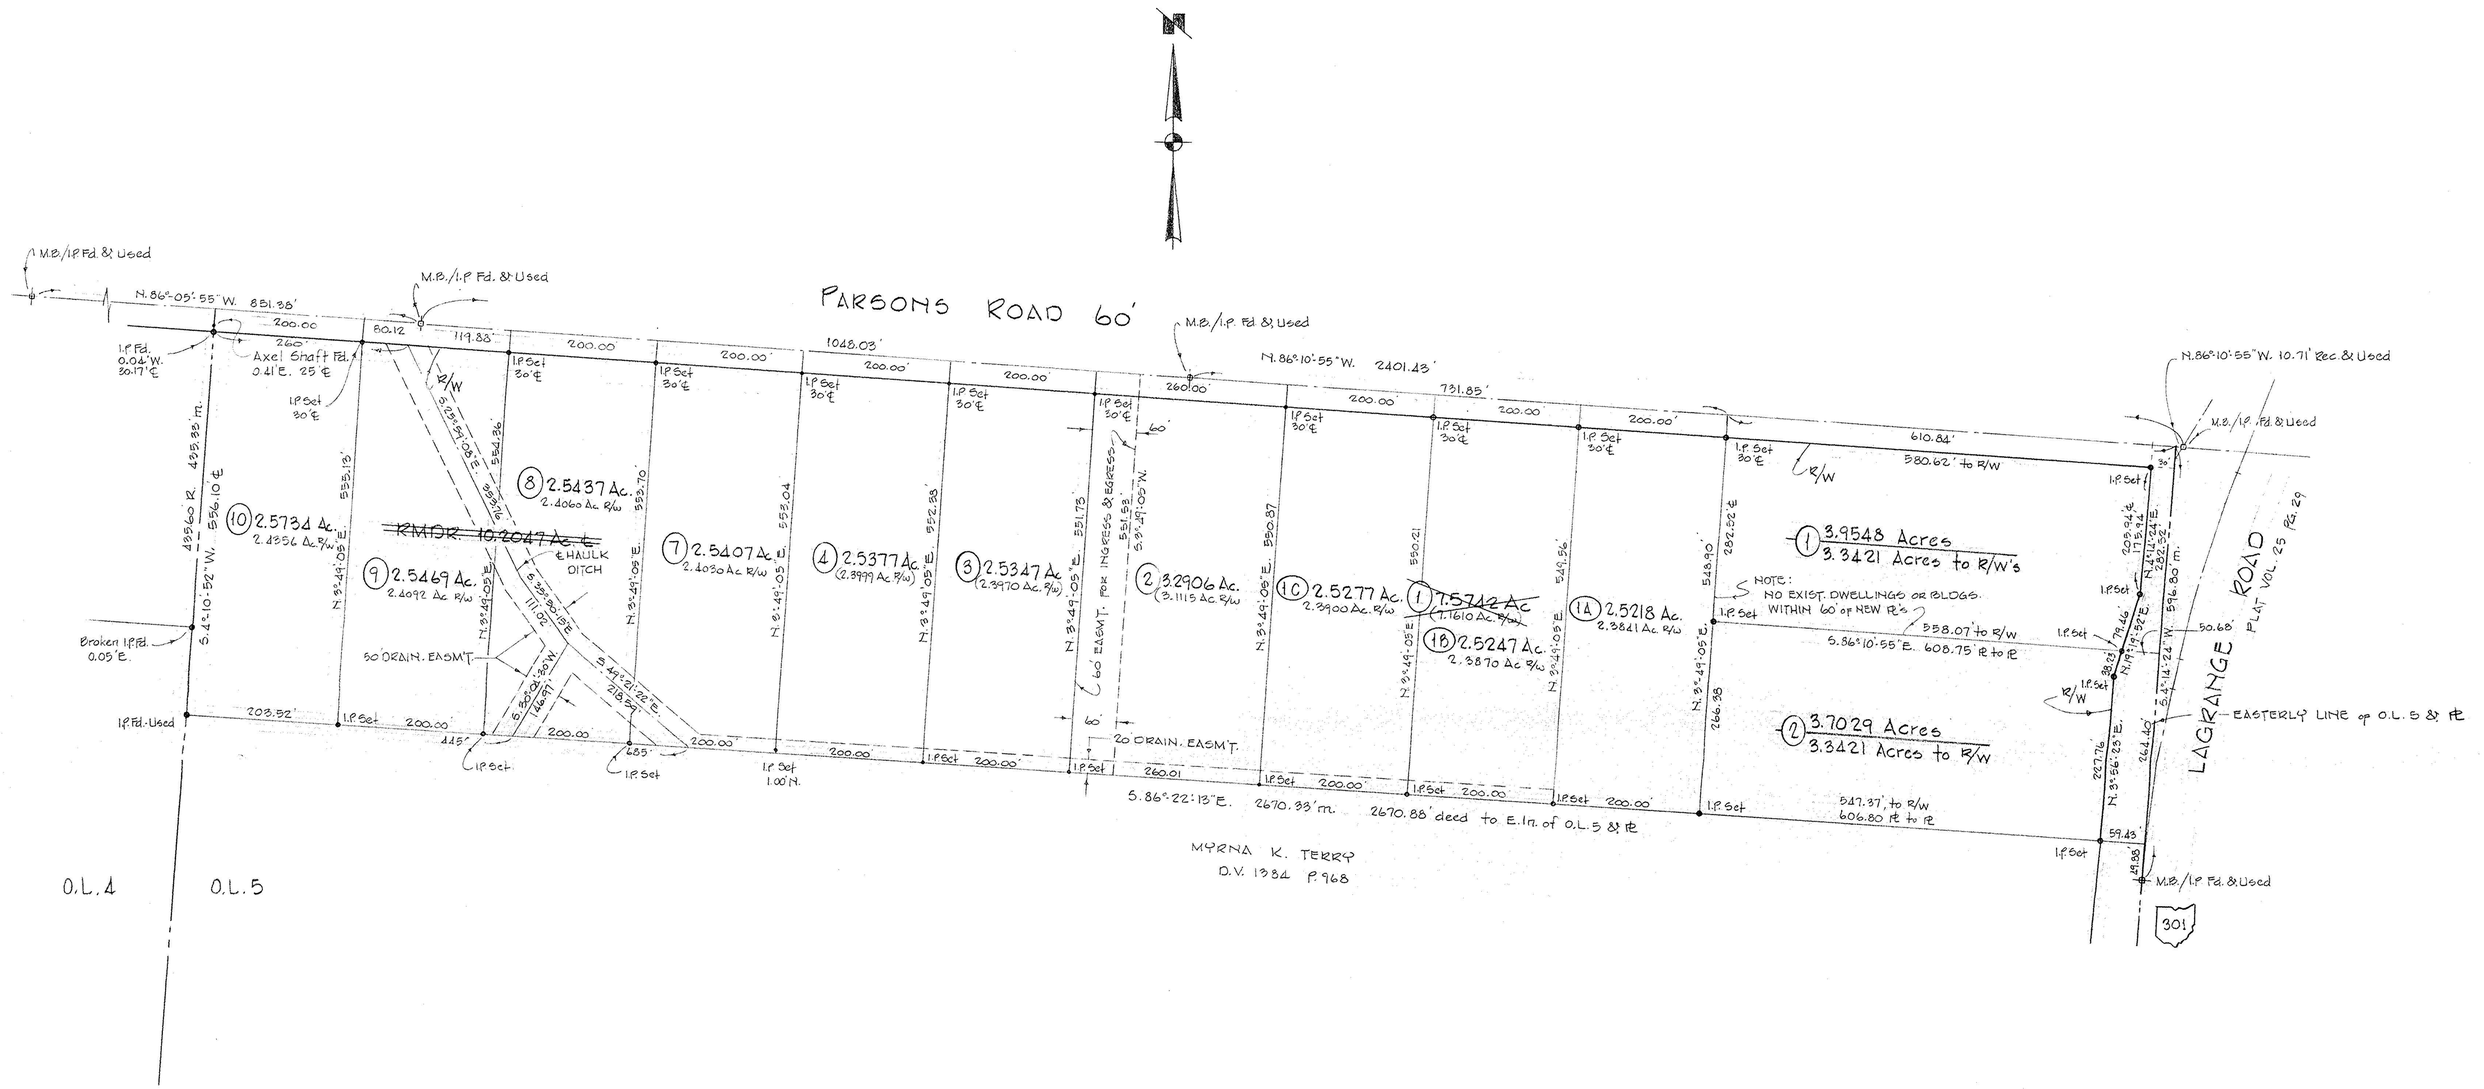

SURVEY & SPLIT FOR

JOSEPH MARUSKIN

PART OF O.L. 5 TOWNSHIP OF LAGRANGE
COUNTY OF LORAIN STATE OF OHIO
SCALE 1" = 100' NOV. 1997

BY

LAUNDON • SIMON • CAHL & ASSOC.
PROFESSIONAL LAND SURVEYORS
JOB Nº 97-3006 FB. 242 P. 43

REVISED FOR

DAVID DEVELOPMENT CO.

APRIL 9, 1998 PCL'S 1, 2, 3, 4 & RMOR

REVISED MAY 13, 1998 PCL'S. 1A, 1B, 1C, 7, 8, 9 & 10
" JULY 6, 1998 ADD 60' EASM'T. TO PCL. 2