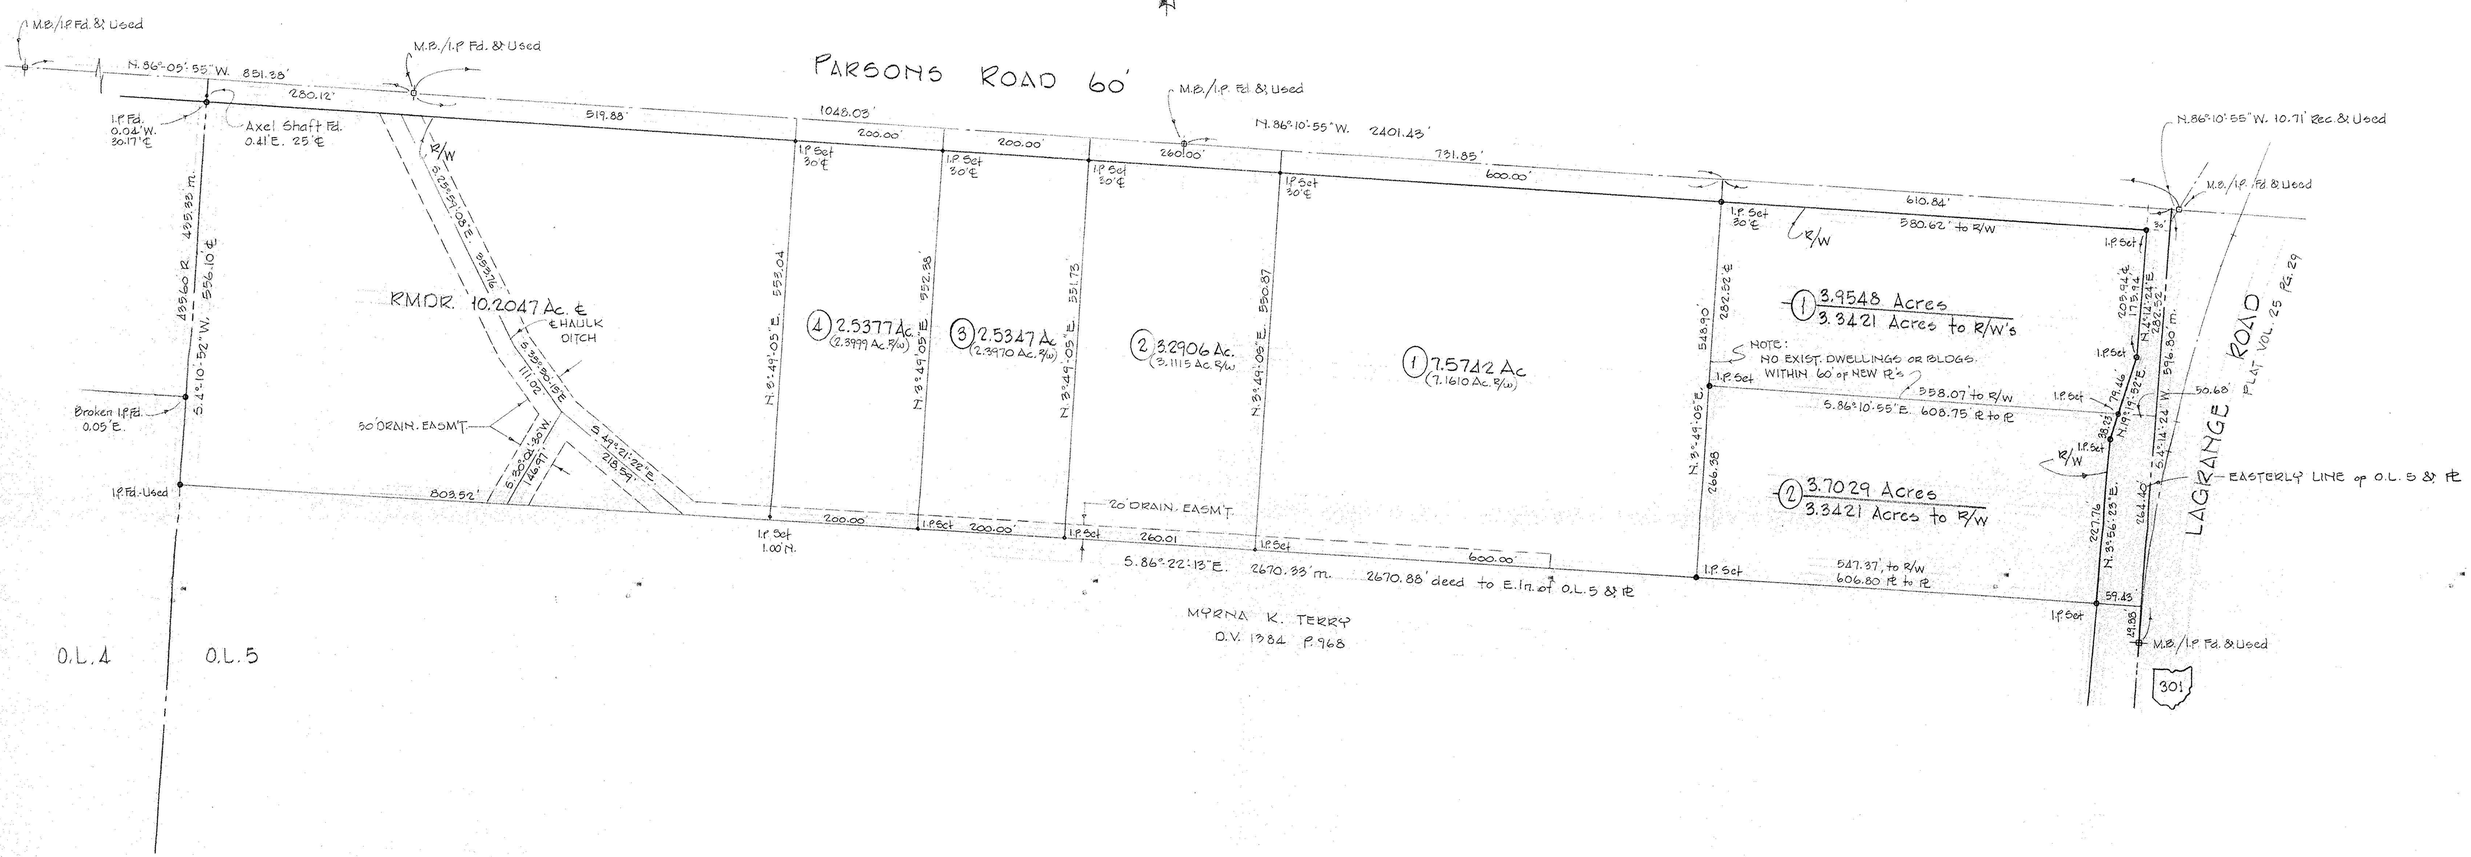

SURVEY & SPLIT FOR

JOSEPH MARUSKIN

PART OF O.L. 5 TOWNSHIP OF LAGRANGE

COUNTY OF LORAIN STATE OF OHIO

SCALE 1" = 100' NOV. 1997

BY

LAUNDON • SIMON • CAHL & ASSOC.

PROFESSIONAL LAND SURVEYORS

JOB No 97-3006 FB. 242 P. 43

STATE OF OHIO RODGER G. SIMON 5101 REGISTERED SURVEYOR

REVISED FOR

DAVID DEVELOPMENT CO.

APRIL 9, 1998 PCL'S 1, 2, 3, 4 & RMOR