PARENT PARCEL: 15-00-005-000-037 & 039

CHILD PARCEL: 15-00-005-000-044 THRU 050

STARTING POINT: NW CORNER OF O. L. 5

NO. 22572

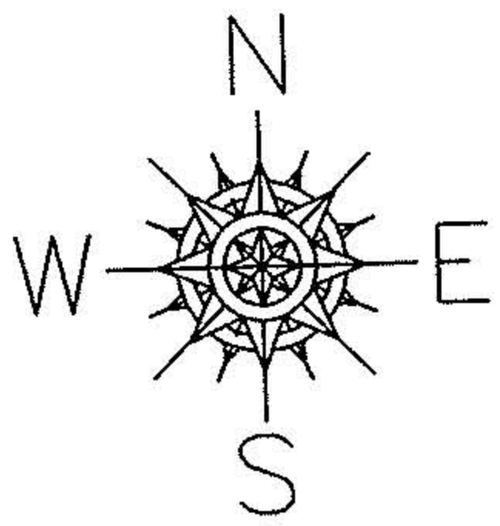

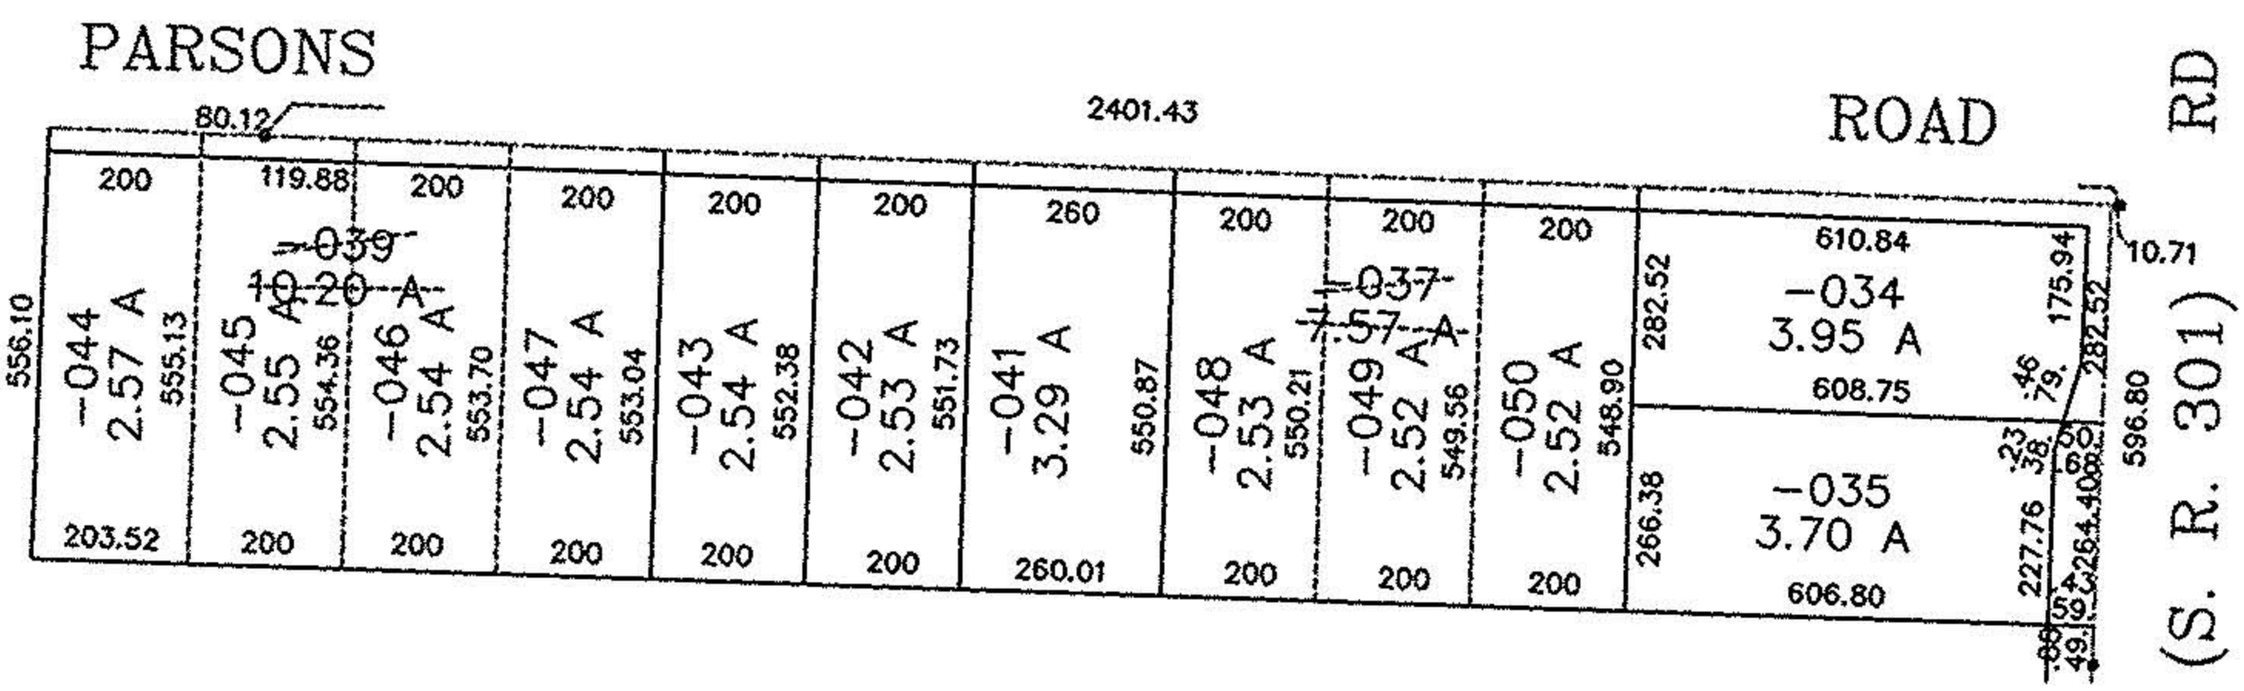

SPLITS/DEEDS PROCESSED

LORAIN COUNTY TAX MAP DEPARTMENT
226 MIDDLE AVE. ELYRIA, OHIO

SURVEYED BY: RODGER G SIMON

CLOSURE: 0.014 PER 10,000

MAP PAGE(S): 15-00-005-B

APPROVED BY: F. COLBERT DATE: 6/30/98

SCALE: 1"= 400 PRIOR INSTRUMENT: DV XXXX/XXX