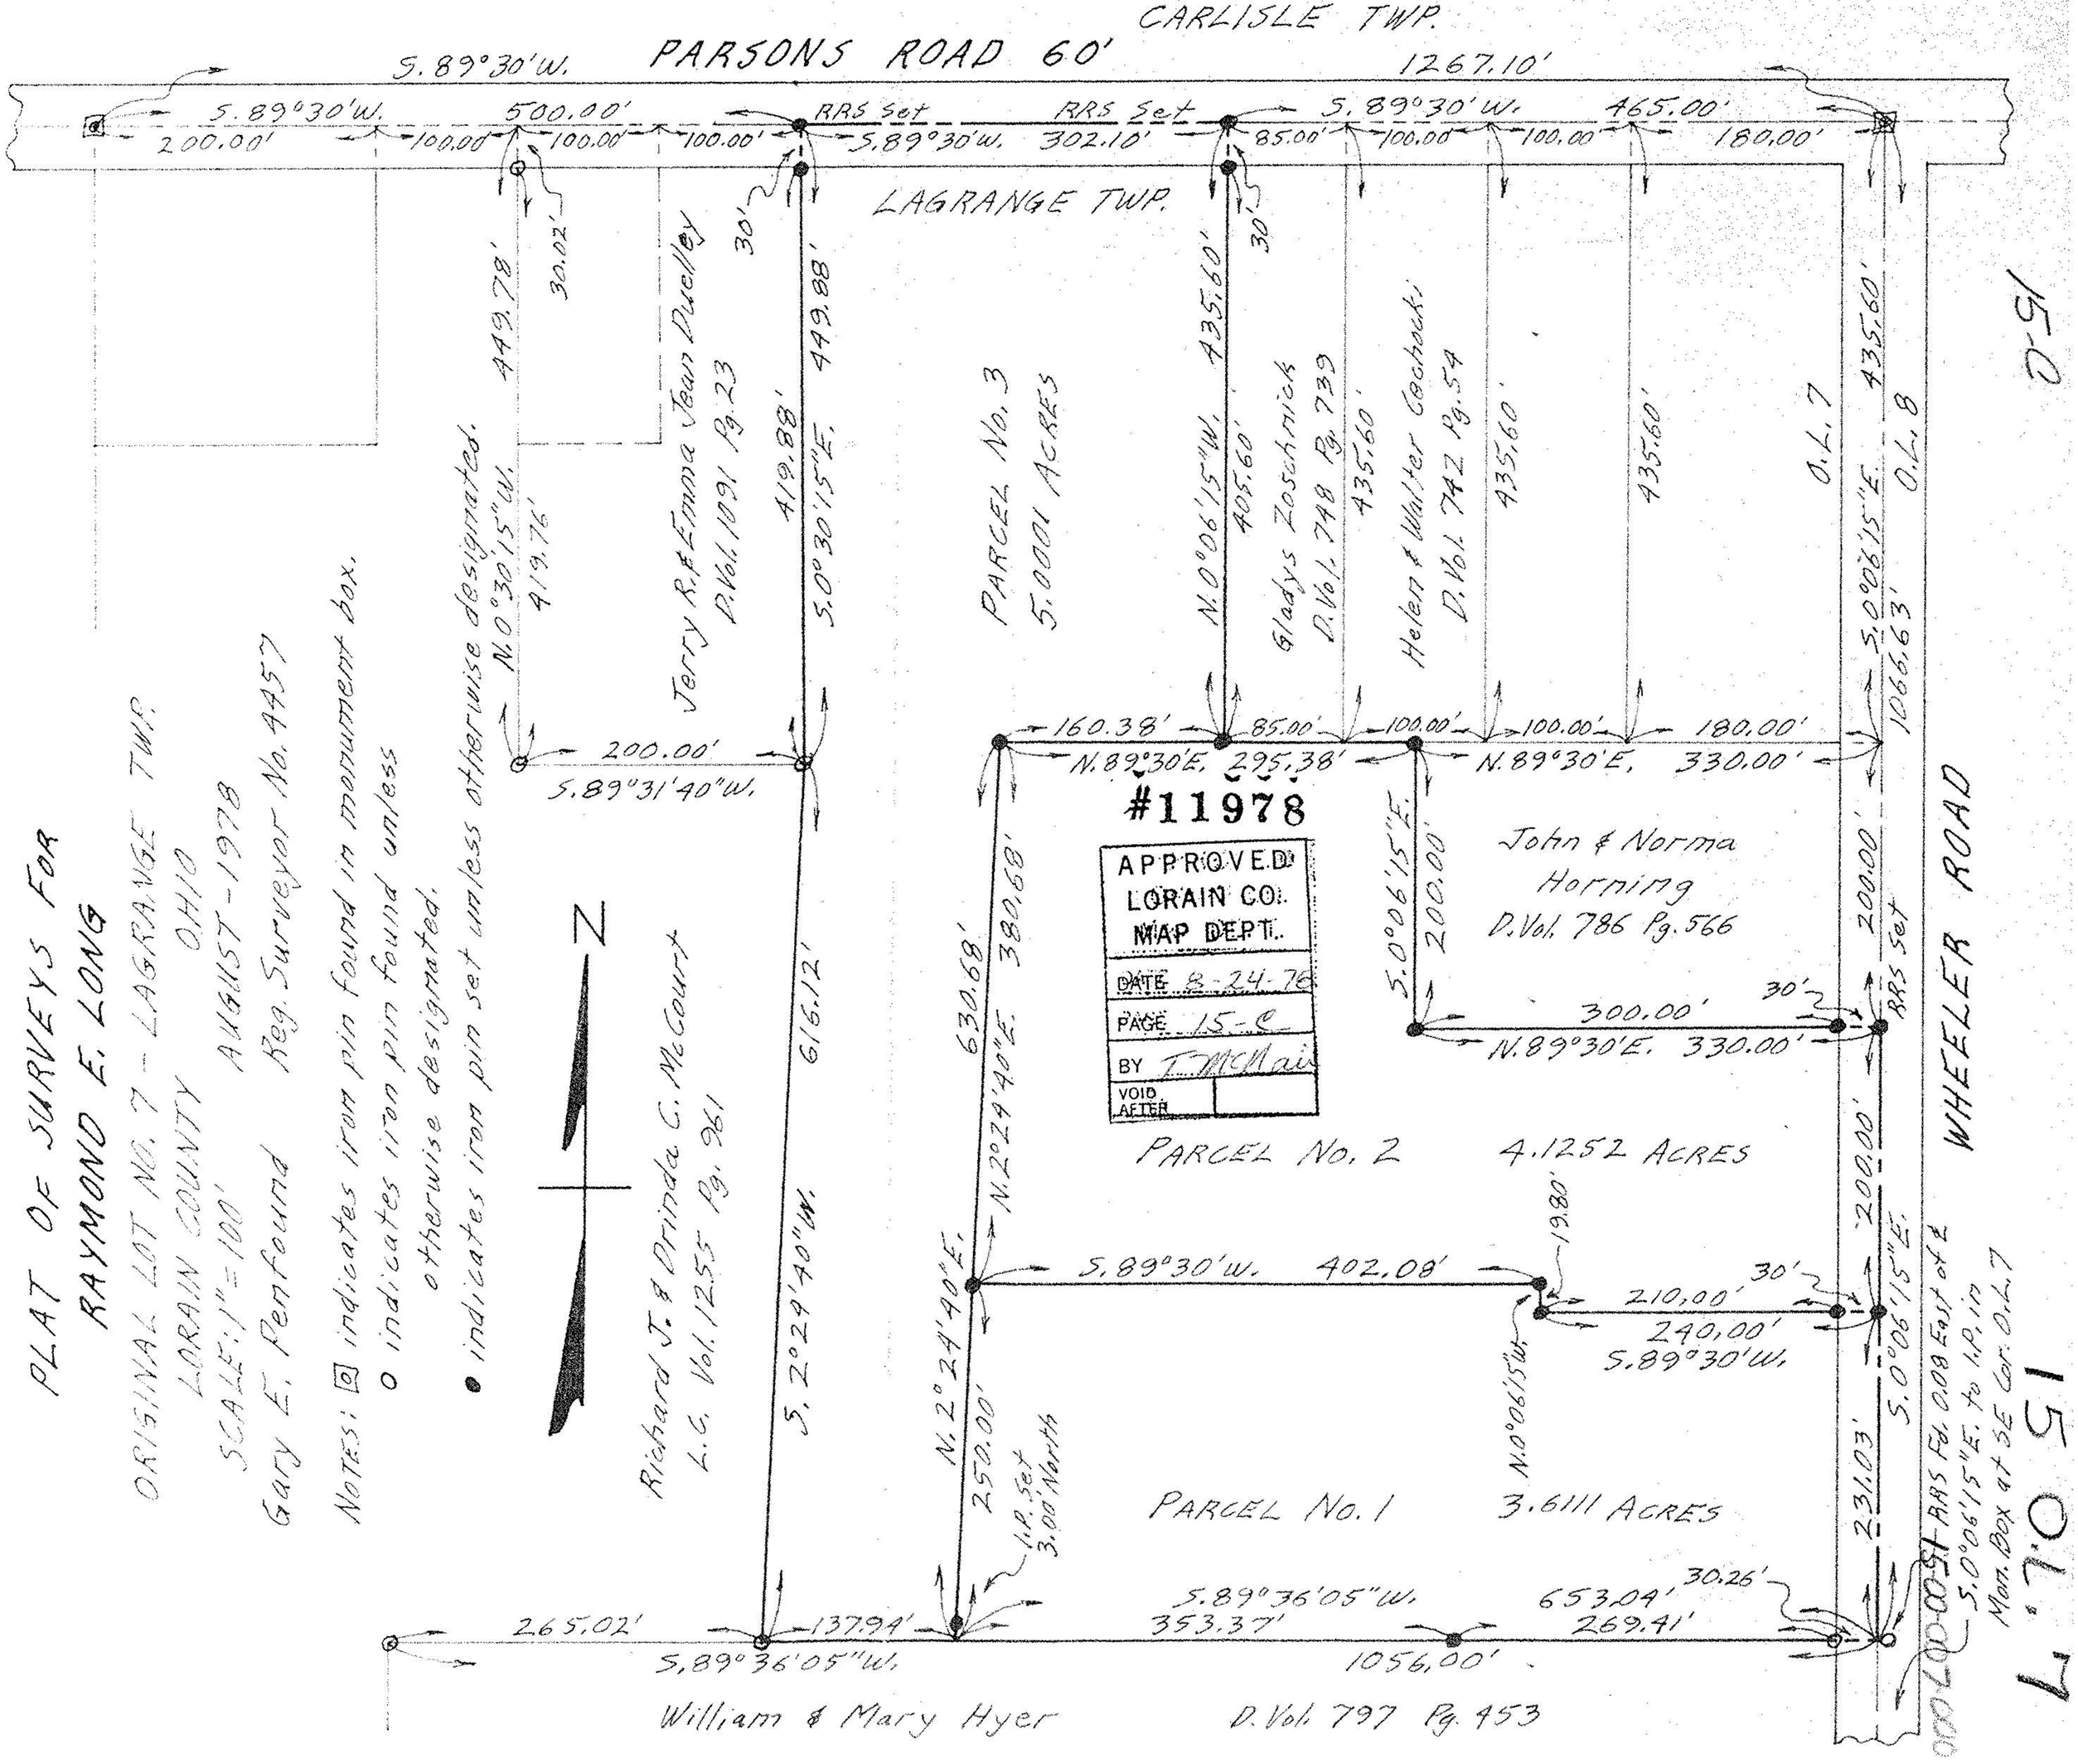

CARLISLE TWP.
PARSONS ROAD 60'
S.89°30'W.
1267.10'
S.89°30'W.
500.00'
RRS Set
RRS Set
S.89°30'W.
465.00'
200.00'
100.00'
100.00'
100.00'
S.89°30'W.
302.10'
85.00'
100.00'
100.00'
180.00'
LAGRANGE TWP.
30'
30'
449.78'
30.02'
449.88'
419.88'
S.0°30'15"E.
N.0°30'15"W.
419.76'
Jerry R. & Emma Jean Duelley
D.Vol. 1091 Pg. 23
PARCEL No. 3
5.0001 ACRES
N.0°06'15"W.
435.60'
405.60'
Gladys Zoschnick
D.Vol. 748 Pg. 739
435.60'
Helen & Walter Cechocki
D.Vol. 742 Pg. 54
435.60'
435.60'
O.L. 7
O.L. 8
435.60'
S.0°06'15"E.
1066.63'
160.38'
85.00'
100.00'
100.00'
180.00'
N.89°30'E.
295.38'
N.89°30'E.
330.00'
200.00'
S.89°31'40"W.
#11978
APPROVED
LORAIN CO.
MAP DEPT.
DATE 8-24-76
PAGE 15-C
BY T. McMain
VOID AFTER
John & Norma
Horning
D.Vol. 786 Pg. 566
S.0°06'15"E.
200.00'
200.00'
RRS Set
300.00'
30'
N.89°30'E.
330.00'
WHEELER ROAD
630.68'
380.68'
N.2°24'40"E.
616.12'
S.2°24'40"W.
PARCEL No. 2
4.1252 ACRES
200.00'
19.80'
S.89°30'W.
402.08'
210.00'
30'
240.00'
S.89°30'W.
S.0°06'15"E.
N.0°06'15"W.
N.2°24'40"E.
250.00'
I.P. Set
3.00' North
PARCEL No. 1
3.6111 ACRES
231.03'
S.0°06'15"E.
RRS Fd. 0.08 East of ℄
S.0°06'15"E. to I.P. in
Mon. Box at SE Cor. O.L. 7
15-C
15 O.L. 7
S.89°36'05"W.
353.37'
653.04'
30.26'
269.41'
265.02'
137.94'
S.89°36'05"W.
1056.00'
William & Mary Hyer
D.Vol. 797 Pg. 453
PLAT OF SURVEYS FOR
RAYMOND E. LONG
ORIGINAL LOT NO. 7 - LAGRANGE TWP.
LORAIN COUNTY OHIO
SCALE: 1" = 100'
AUGUST - 1978
Gary E. Penfound Reg. Surveyor No. 4457
NOTES: ⊡ indicates iron pin found in monument box.
○ indicates iron pin found unless otherwise designated.
● indicates iron pin set unless otherwise designated.
Richard J. & Drinda C. McCourt
L.C. Vol. 1255 Pg. 961
N