LORAIN COUNTY OHIO

SCALE: 1" = 100' AUGUST - 1978

Gary E. Penfound Reg. Surveyor No. 4457
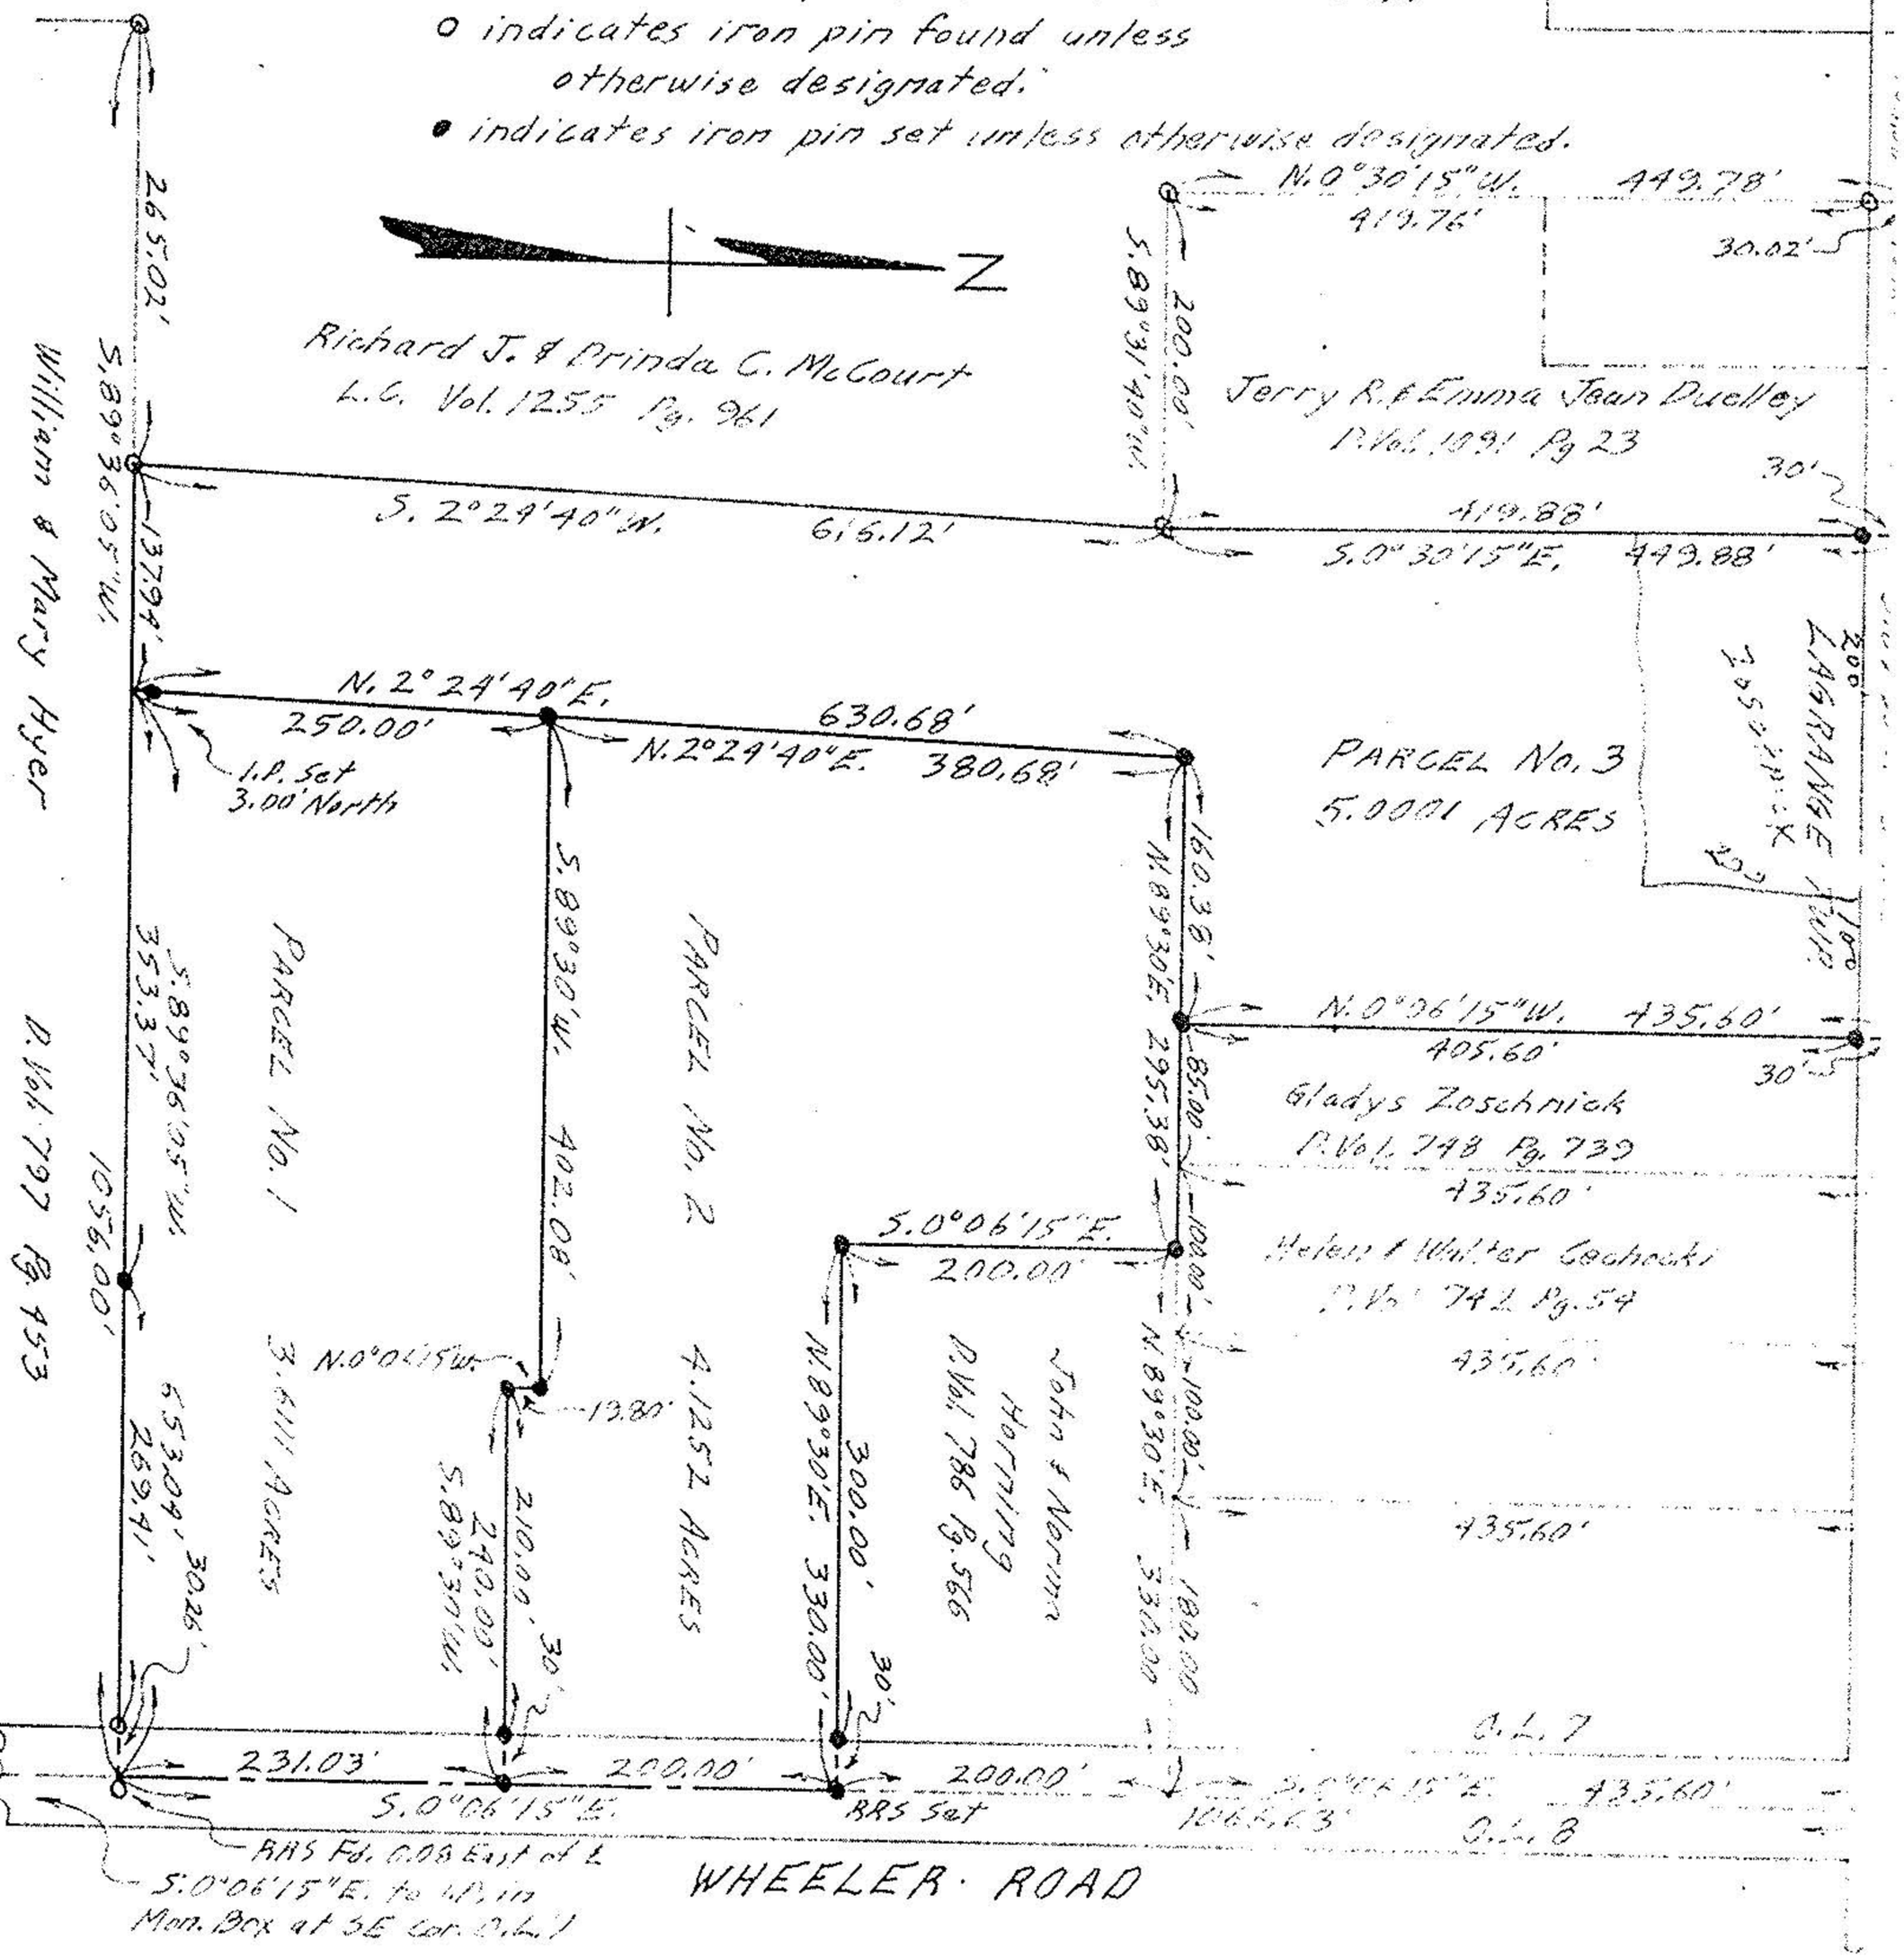
NOTES: ⊡ indicates iron pin found in monument box.
o indicates iron pin found unless otherwise designated.
• indicates iron pin set unless otherwise designated.