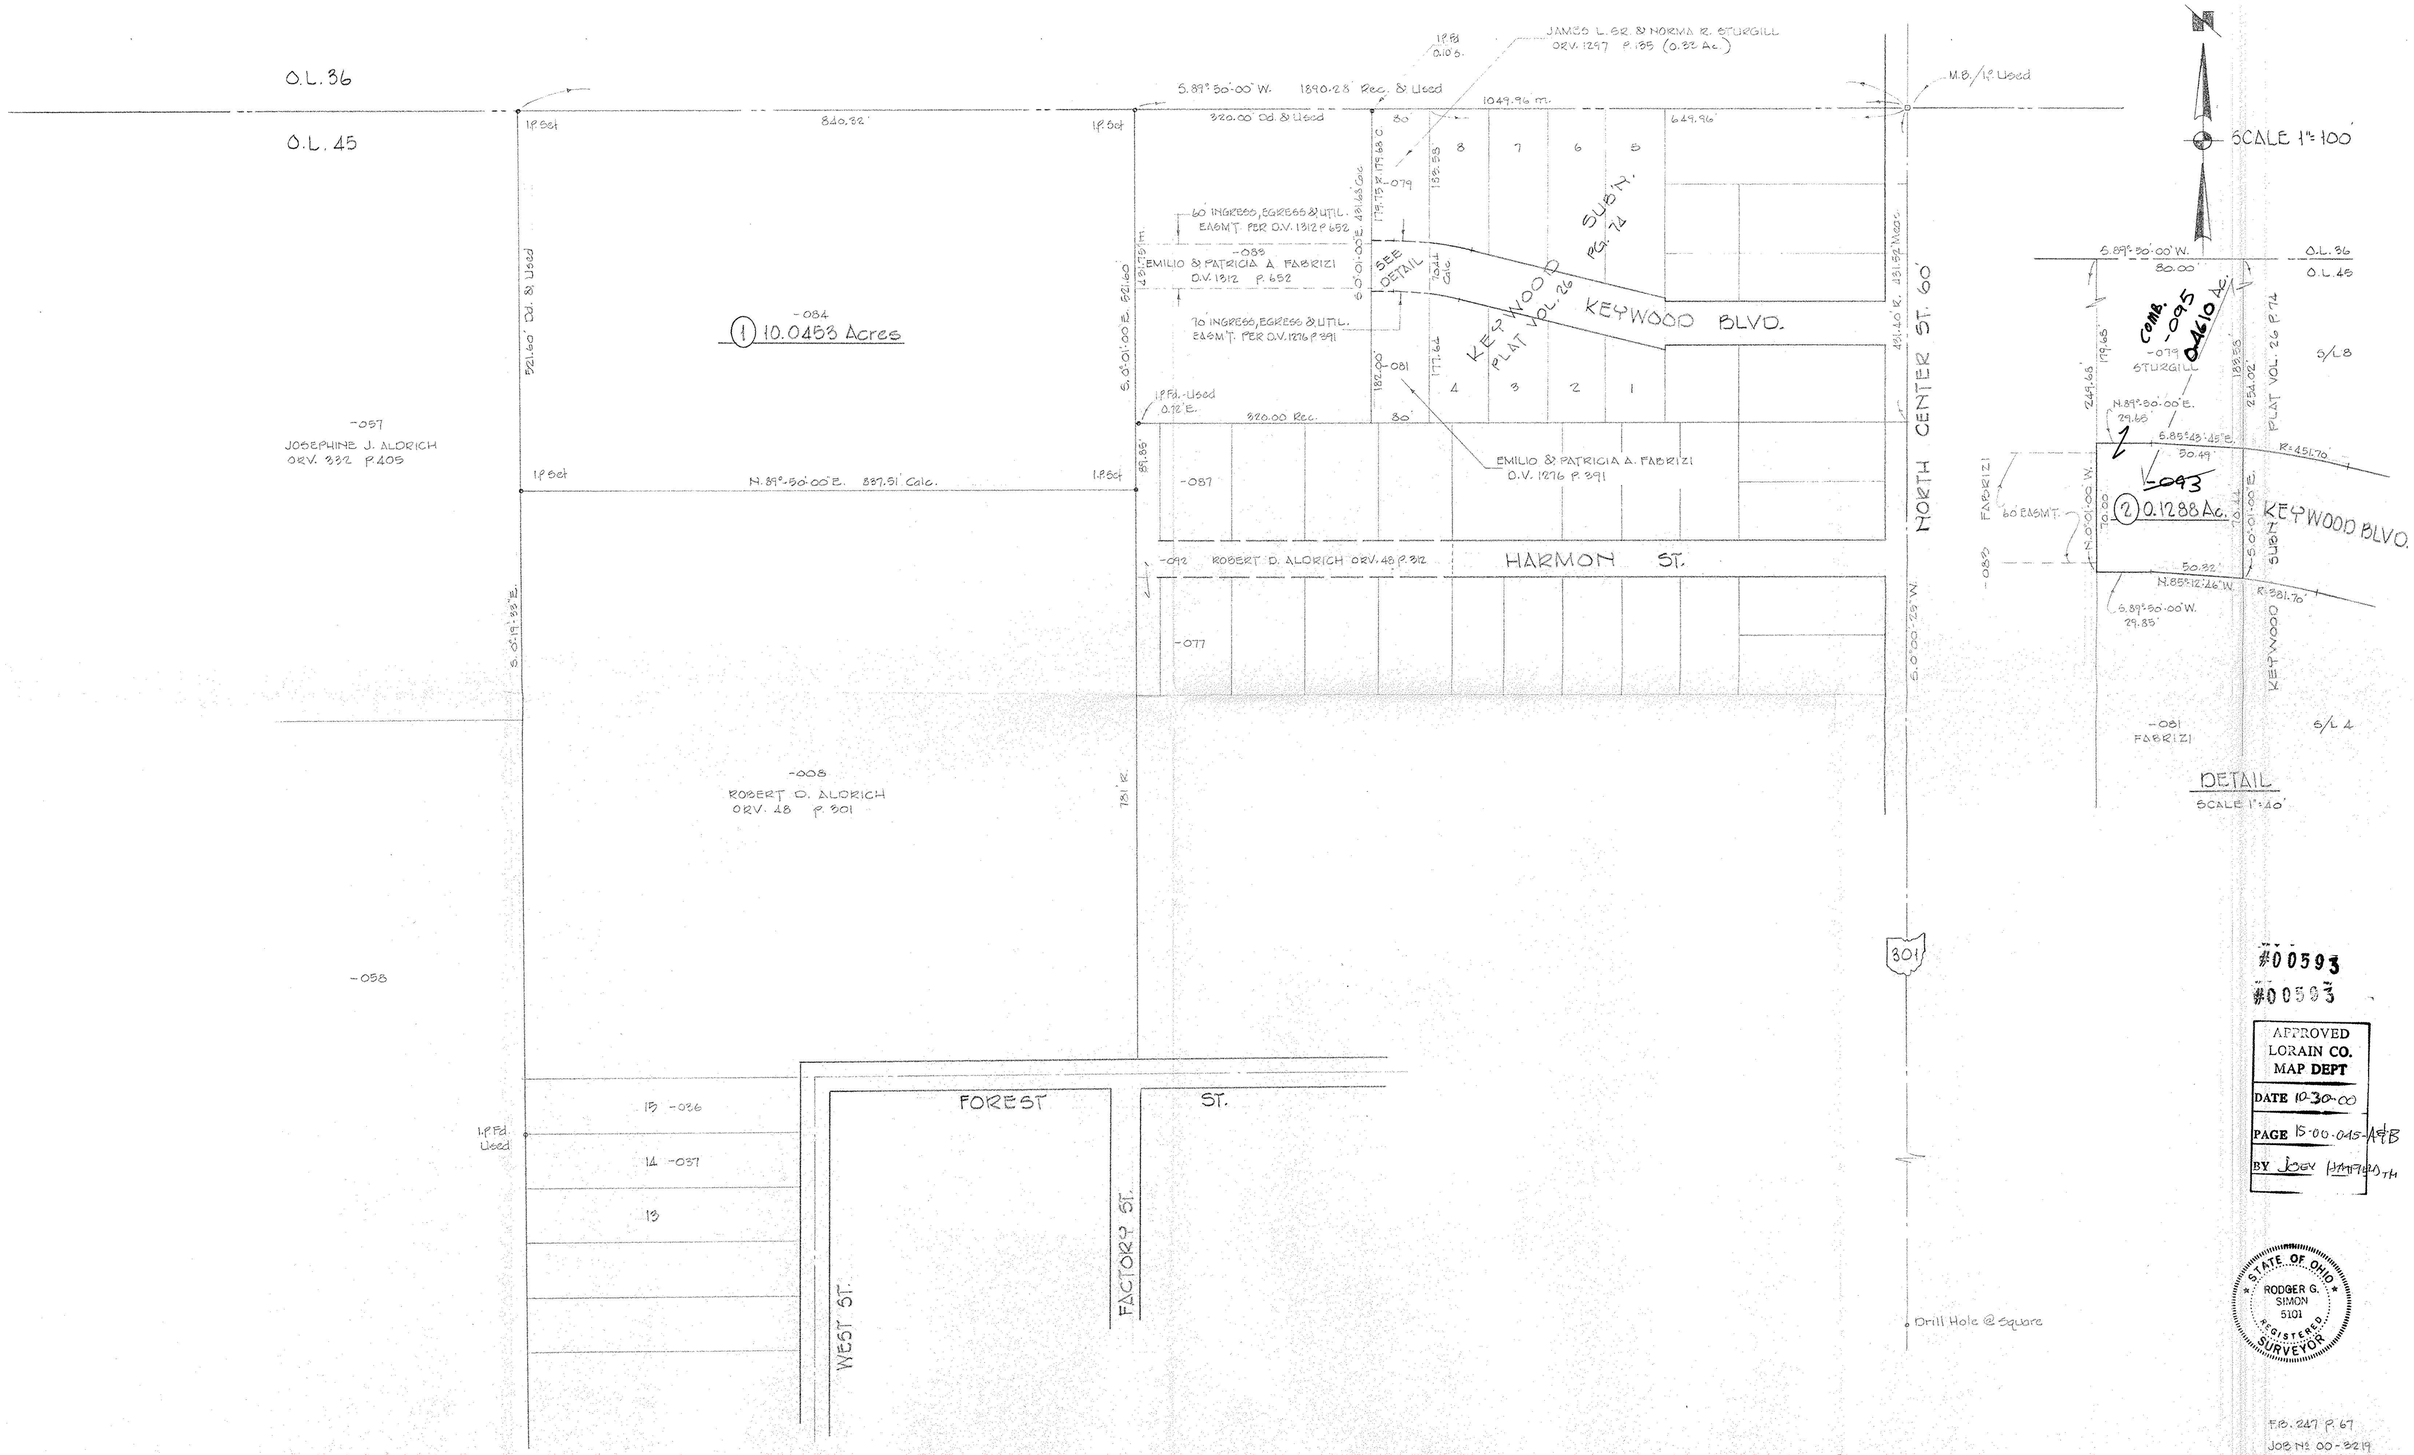

#00593

#00593

APPROVED
LORAIN CO.
MAP DEPT
DATE 10-30-00
PAGE 15-00-045-A & B
BY JOEY

STATE OF OHIO
RODGER G. SIMON
5101
REGISTERED SURVEYOR

REV. 8/31/00 Combine Pcl. -079 & Pcl. 2 R.G.S.

F.B. 247 P. 67
JOB № 00-3219
SHEET № 2 OF 2