


15-00-045-104-003

E. D. MERRIAN'S ADDITION  
VOL. 3 PG. 16 LORAIN CO. RECORD OF MAPS

40 FT.

PROSPECT STREET 40 FT.

Lagrange Veterans Association 5/14/09

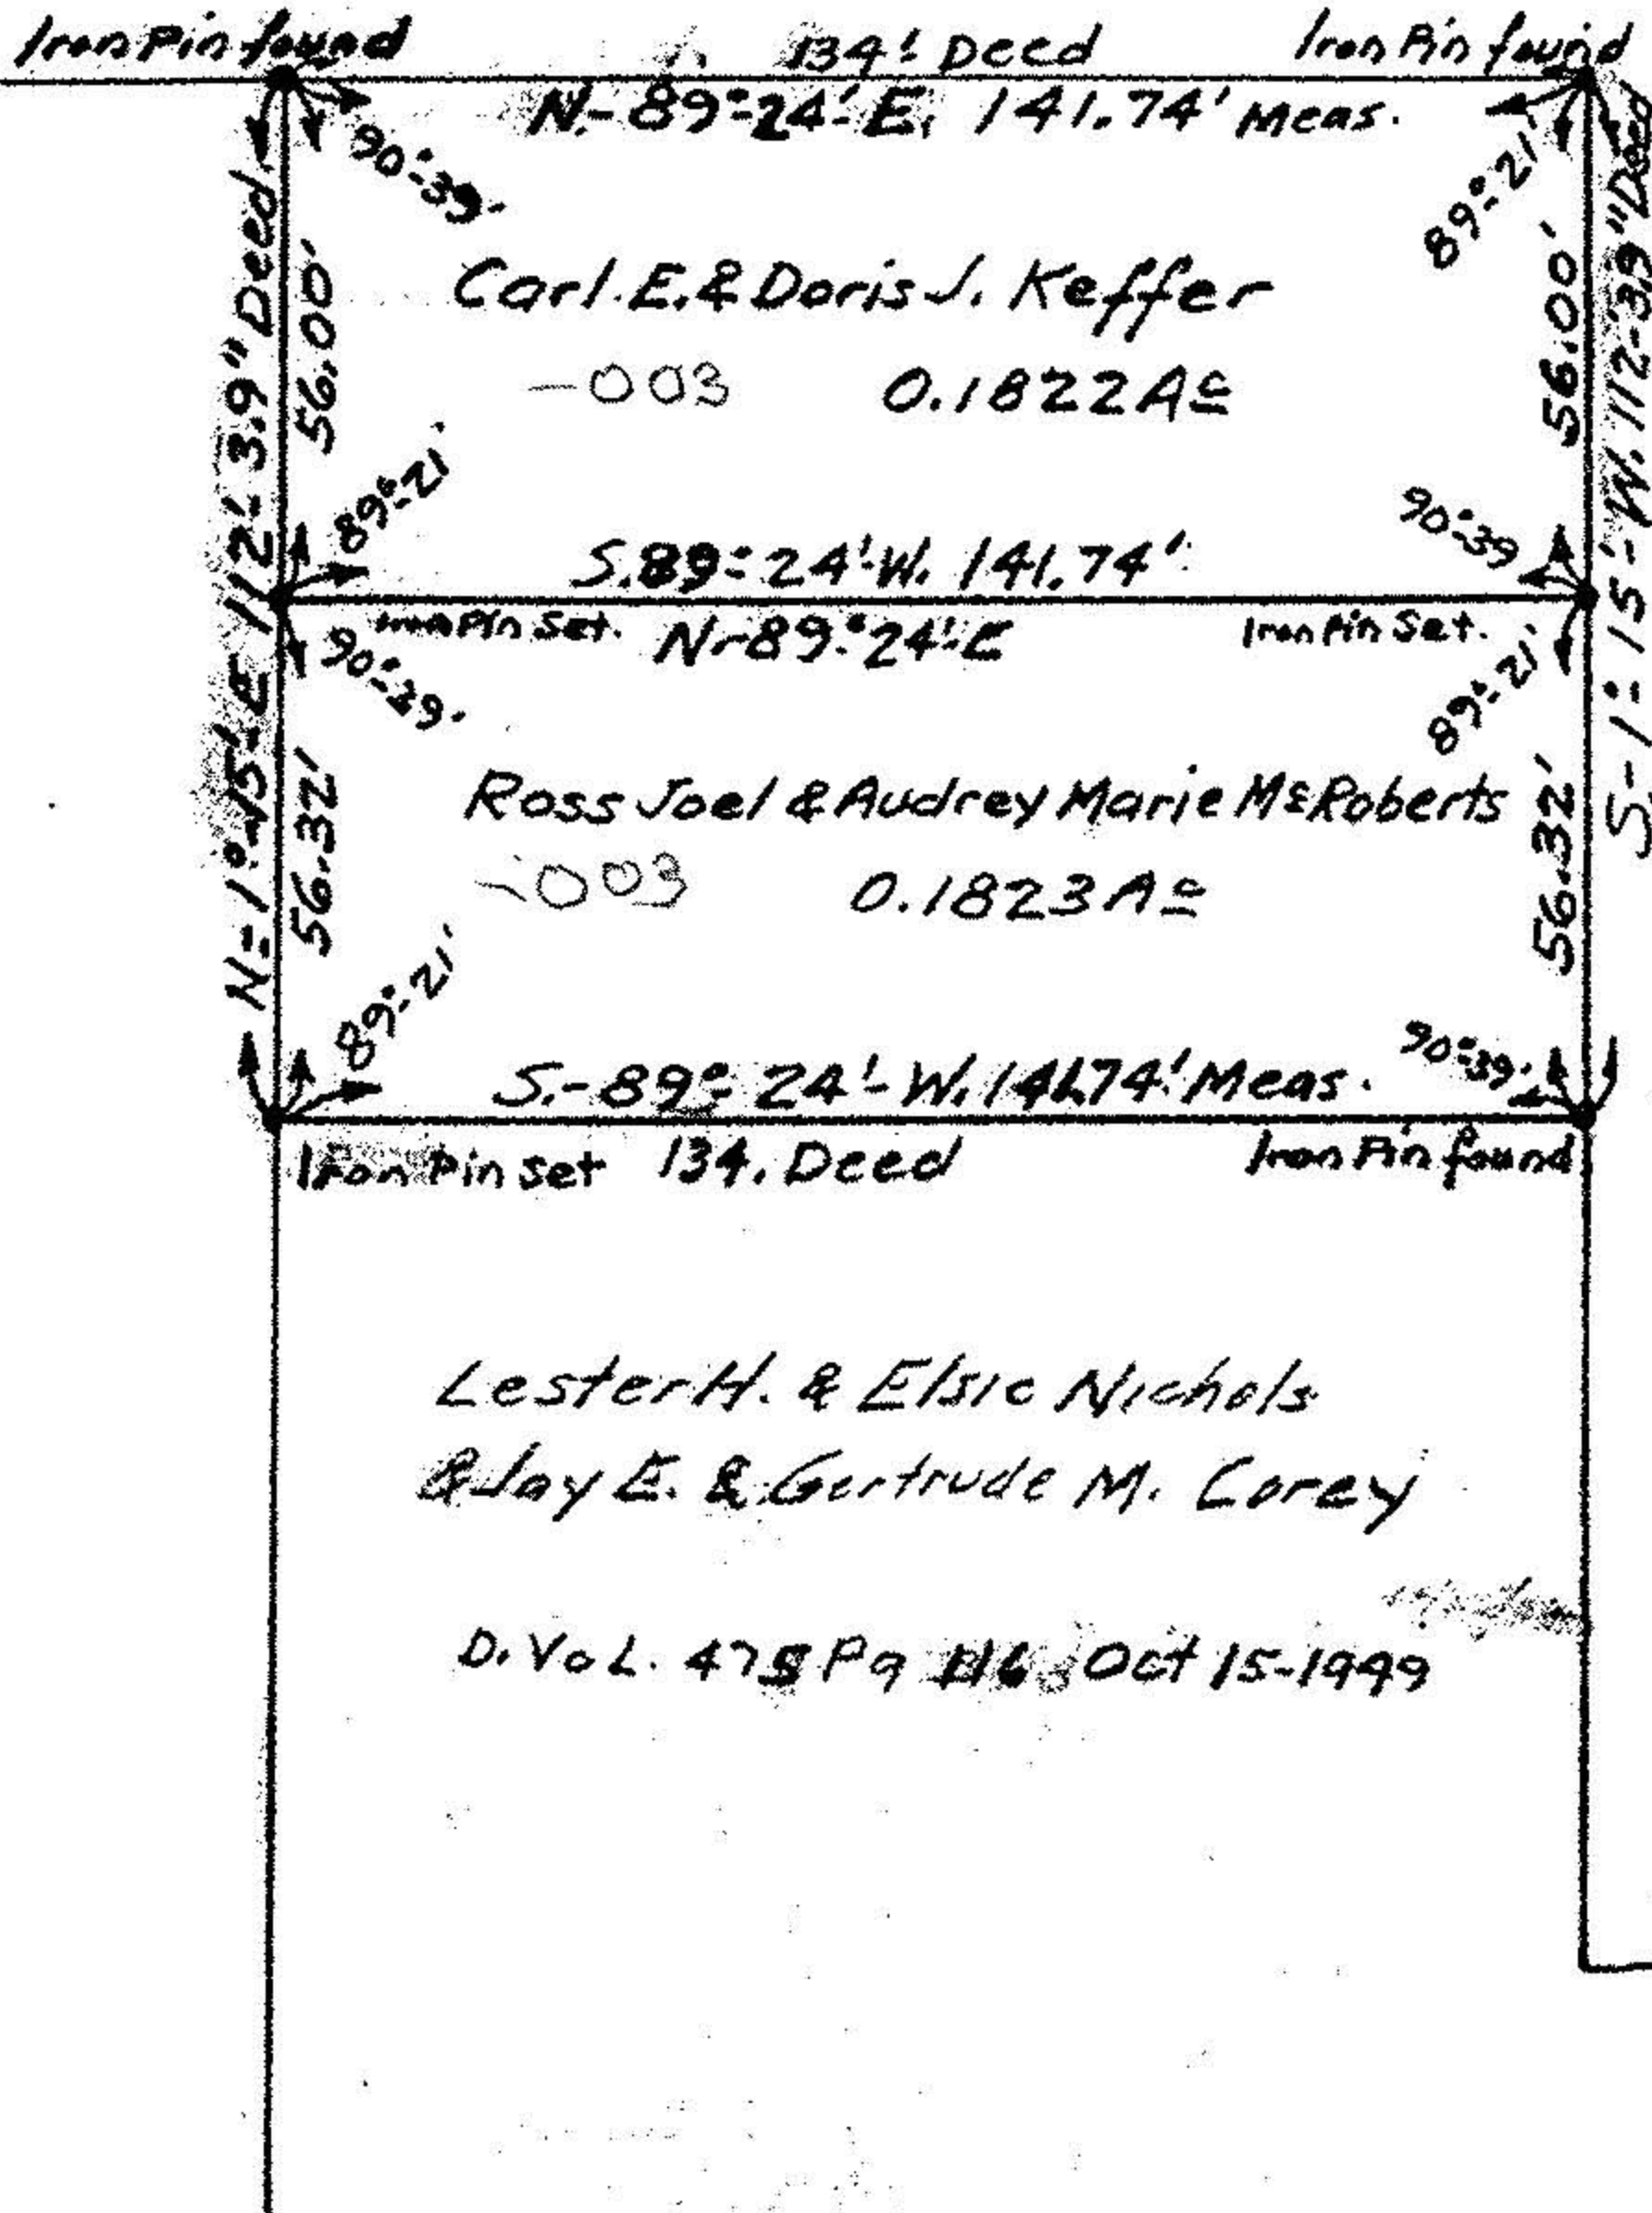

FACTORY STREET



MAP OF SURVEY FOR  
 ROSS JOEL & AUDREY MARIE McROBERTS.  
 ORIGINAL LOT 45 LAGRANGE TOWNSHIP  
 LORAIN COUNTY OHIO  
 SCALE 1" = 40' NOV. 24-1951  
 C. E. PENFOUND Registered Surveyor.  
 Nov. 24-1951