PARENT PARCEL: 15-00-047-000-057

CHILD PARCEL: 15-00-047-000-061, -062

STARTING POINT: cL of Wakeman Belden Rd. & cL of Wheeler Rd.

NO. 22340

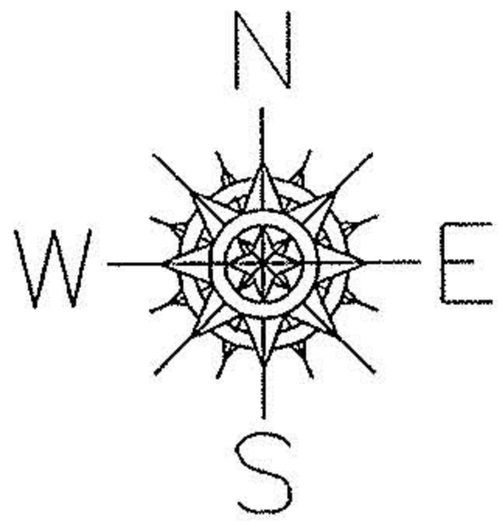

~~-057~~
~~125.12 A.~~

-062
122.42 A.

FIX P.P.NO. -061 IS CORRECT

S 89-30-00 E
521.04

-061
-091
2.70 A.

N 00-30-30 E
226

226
N 00-30-30 E

521.04
N 89-30-00 W

90	80	80	80	80	80	320.50	200.54
A.	A.	A.	A.	A.	A.		
0.56	0.50	0.50	0.50	0.50	0.50		
-010	-016	-012	-007	-008	-009	-054	-058
90	80	80	80	80	80	2.00 A.	1.25 A.

272.25 272.25 272.25

N 89-30-00 W

Wheeler Rd.

Wakeman Belden Rd.

SPLITS/DEEDS PROCESSED

LORAIN COUNTY TAX MAP DEPARTMENT
226 MIDDLE AVE. ELYRIA, OHIO

SURVEYED BY: John Pozywak

CLOSURE: 0.00:10,000

MAP PAGE(S): 15-00-047-A, B

APPROVED BY: kac DATE: 11/3/97

SCALE: 1"= 200 PRIOR INSTRUMENT: OR 867/586