


15-00-055-A 20416 15-00-055-101-

Main St SR 303

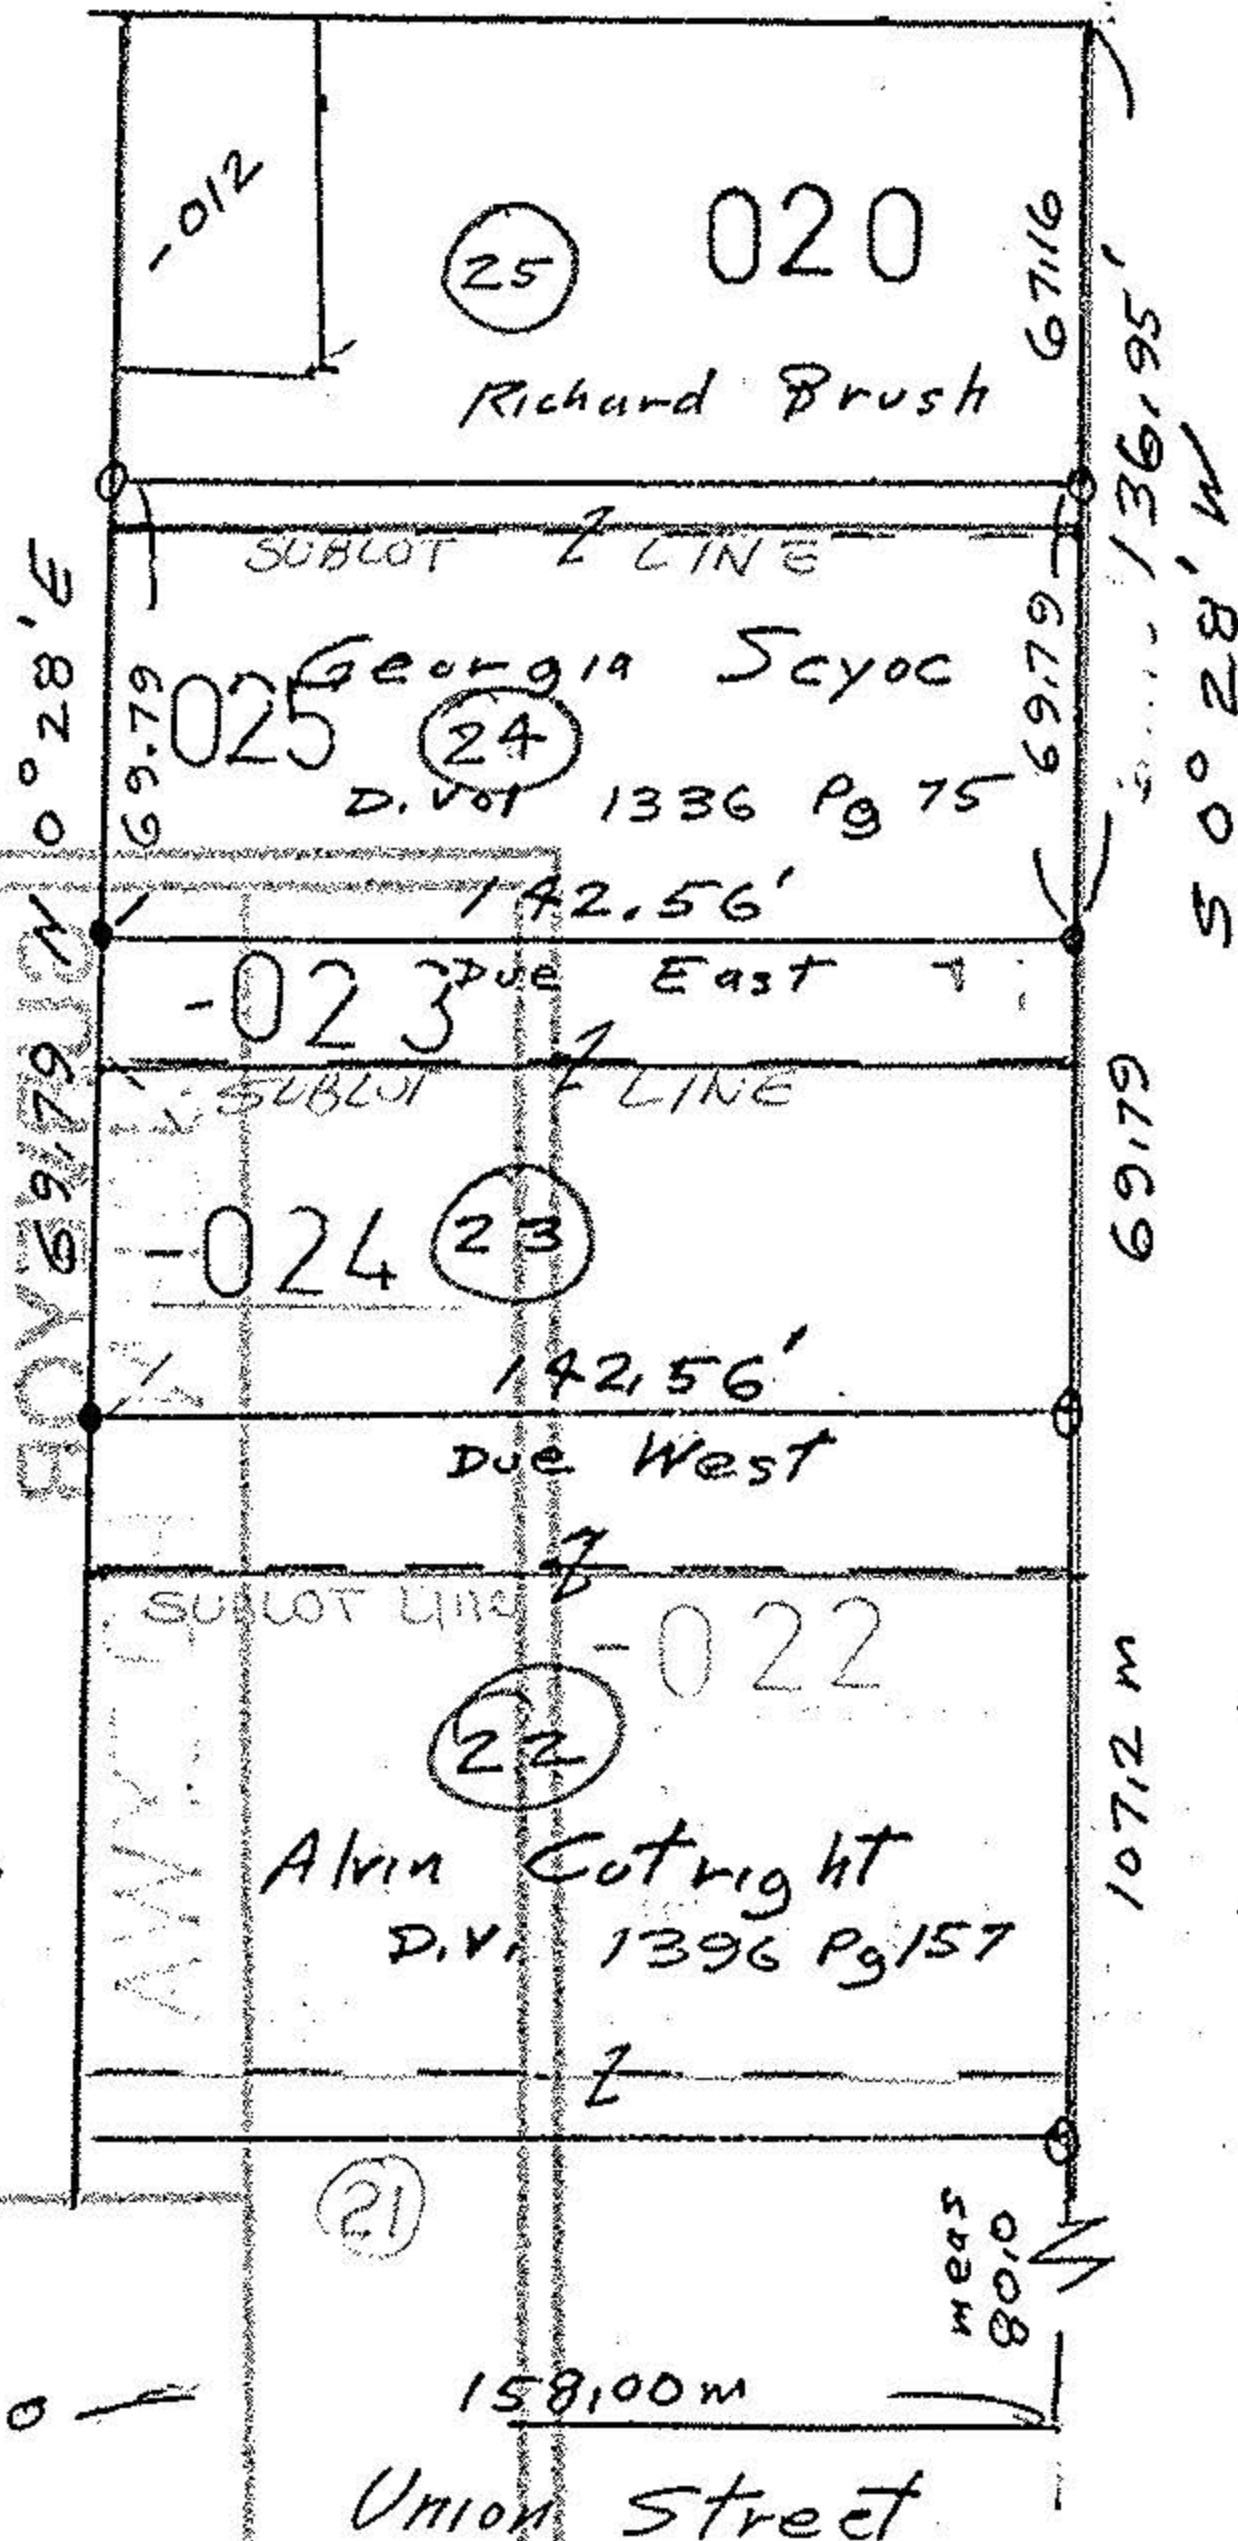

- iron pipes fd.
- iron pipes set
- original subplot lines



20416
 APPROVED
 LORAIN CO.
 MAP DEPT.
 DATE 7-2-93
 PAGE 15-00-055-A
 BY CAROLYN FRONEL
 VOID AFTER # 20416

Survey of
 Part sublots 24 & 23
 La Grange Village Plat
 Plat Vol. 1 Pg 4
 Plat Vol 2 Pg 24

John Poznywak
 Reg. Surveyor
 5292

ORIGINAL LOT 55 DATE May 1993
 TOWNSHIP La Grange SCALE 1"=60'
 CITY OF La Grange Village FIELD BOOK N/A
 COUNTY OF Lorain DRAWN BY _____
 STATE OF OHIO CHECKED BY _____
 W. O. _____ FILE NO. 15-00-055-101