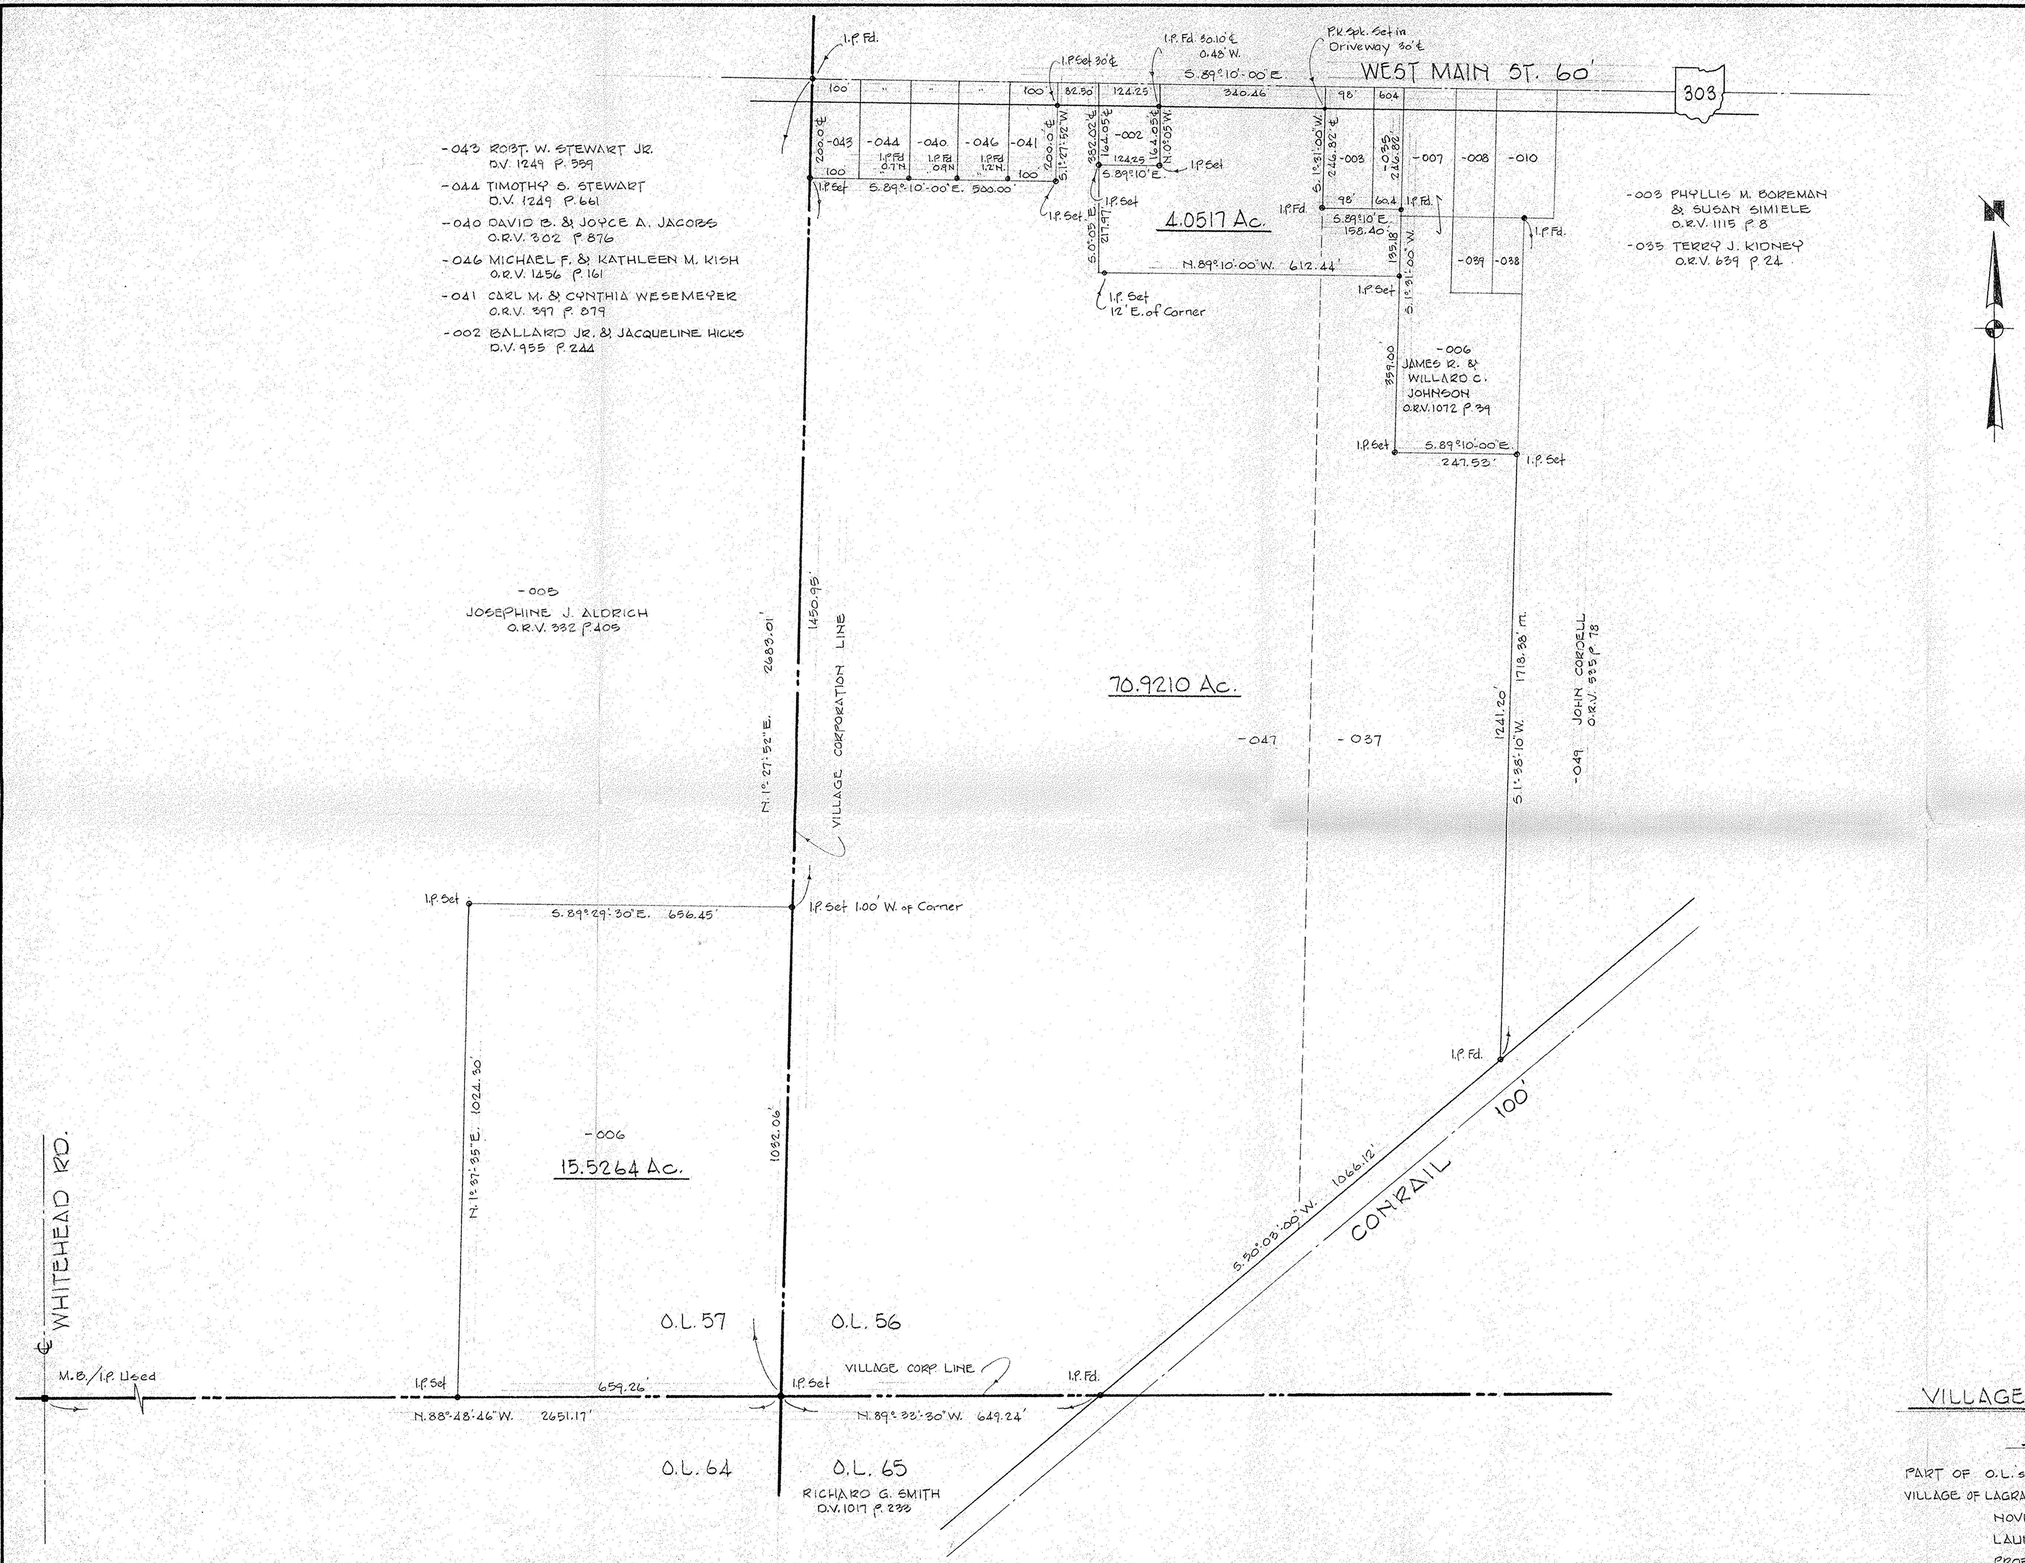


SURVEY FOR

VILLAGE OF LAGRANGE

PUBLIC PARK

PART OF O.L.'s 56 & 57 TOWNSHIP OF LAGRANGE
VILLAGE OF LAGRANGE COUNTY OF LORAIN STATE OF OHIO
NOVEMBER, 1998 SCALE 1"=150'
LAUNDON • SIMON • CAHL & ASSOC.
PROFESSIONAL LAND SURVEYORS
JOB Nº 98-3090 FB. 224 P. 60-61