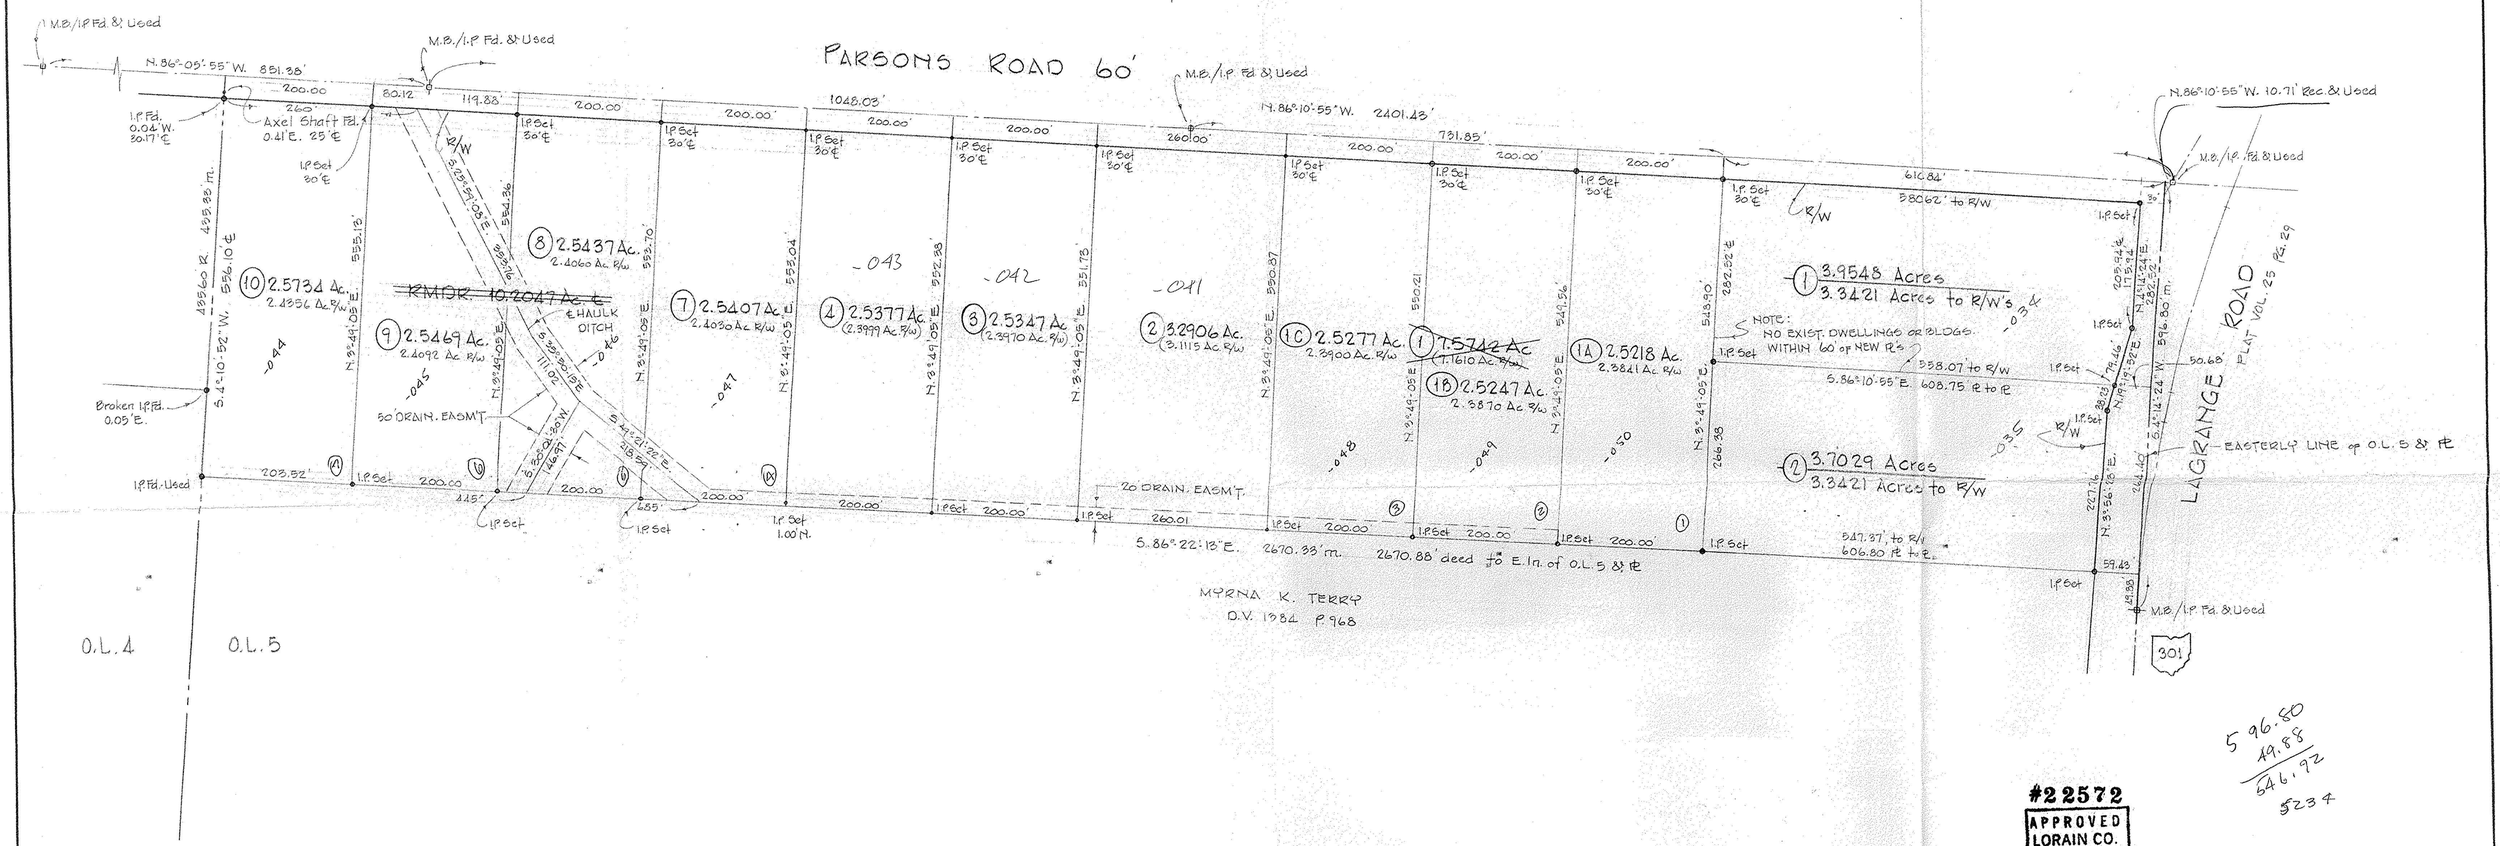

596.80
49.88
646.72
5234

#22572
APPROVED
LORAIN CO.
MAP DEPT.
DATE 6-30-98
PAGE 15-00-005-B
BY
VOID AFTER 98 22572

STATE OF OHIO
RODGER G. SIMON
5101
REGISTERED SURVEYOR

SURVEY & SPLIT FOR
JOSEPH MARUSKIN

PART OF O.L. 5 TOWNSHIP OF LAGRANGE
COUNTY of LORAIN STATE of OHIO
SCALE 1" = 100' NOV. 1997
BY
LAUNDON • SIMON • CAHL & ASSOC.
PROFESSIONAL LAND SURVEYORS
JOB No 97-3006 FB. 242 P. 43

REVISED FOR
DAVID DEVELOPMENT CO.
APRIL 9, 1998 PCL'S 1, 2, 3, 4 & RMOR
REVISED MAY 13, 1998 PCL'S 1A, 1B, 1C, 7, 8, 9 & 10

348