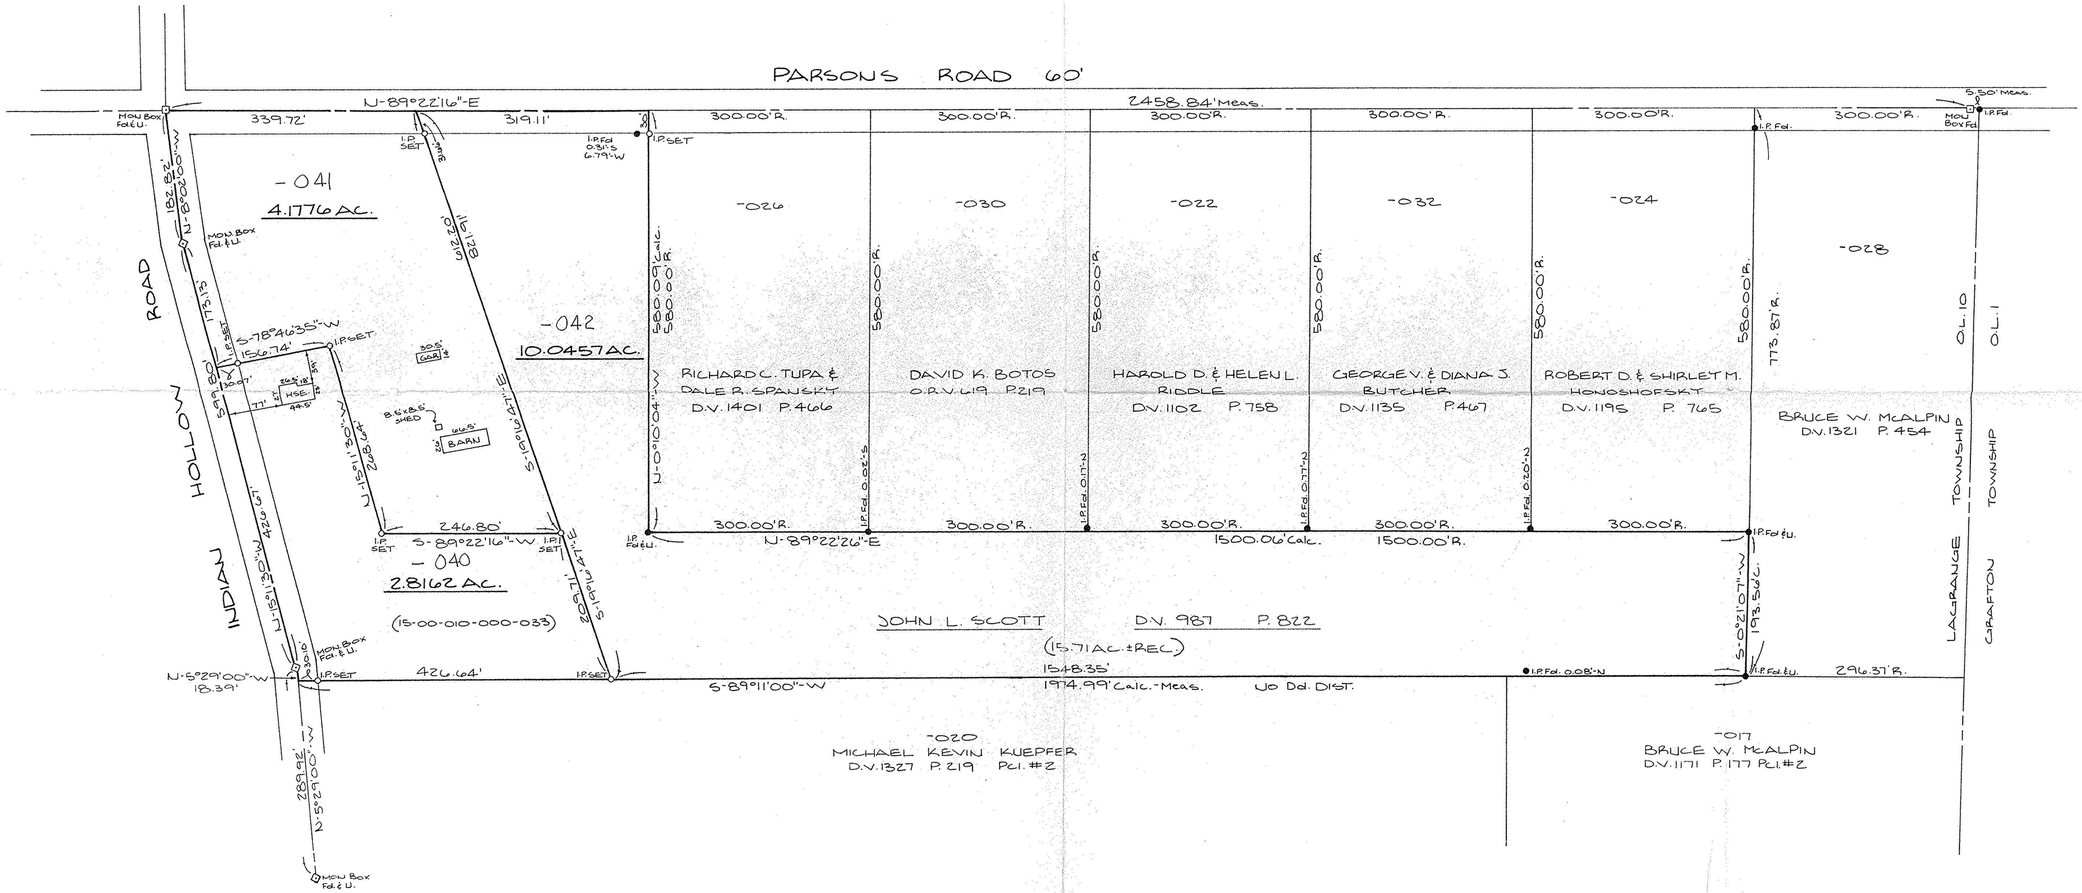

SURVEY MAP

PART OF LAGRANGE TOWNSHIP ORIGINAL LOT NO. 10

TOWNSHIP OF LAGRANGE

COUNTY OF LORAIN

STATE OF OHIO

MARCH 17, 1993

SCALE: 1"=100'

PREPARED BY:

KS ASSOCIATES INC.

ENGINEERS SURVEYORS

PHIL A. ROSEBECK

REG. SURVEYOR NO. 66996

STATE OF OHIO PHILIP A. ROSEBECK 66996 REGISTERED SURVEYOR

93-073