KLEINOEDER · SCHMIDT and ASSOCIATES

ENGINEERS — SURVEYORS — CONSULTANTS in LAND PLANNING

ELYRIA · NORWALK · MEDINA OHIO

SURVEY

Sublot(s) _____

Subd'n _____

Township LAGRANGE Tract _____

Orig. Lot(s) 11 Sec. _____

County of LORAIN State of Ohio

Corporation _____

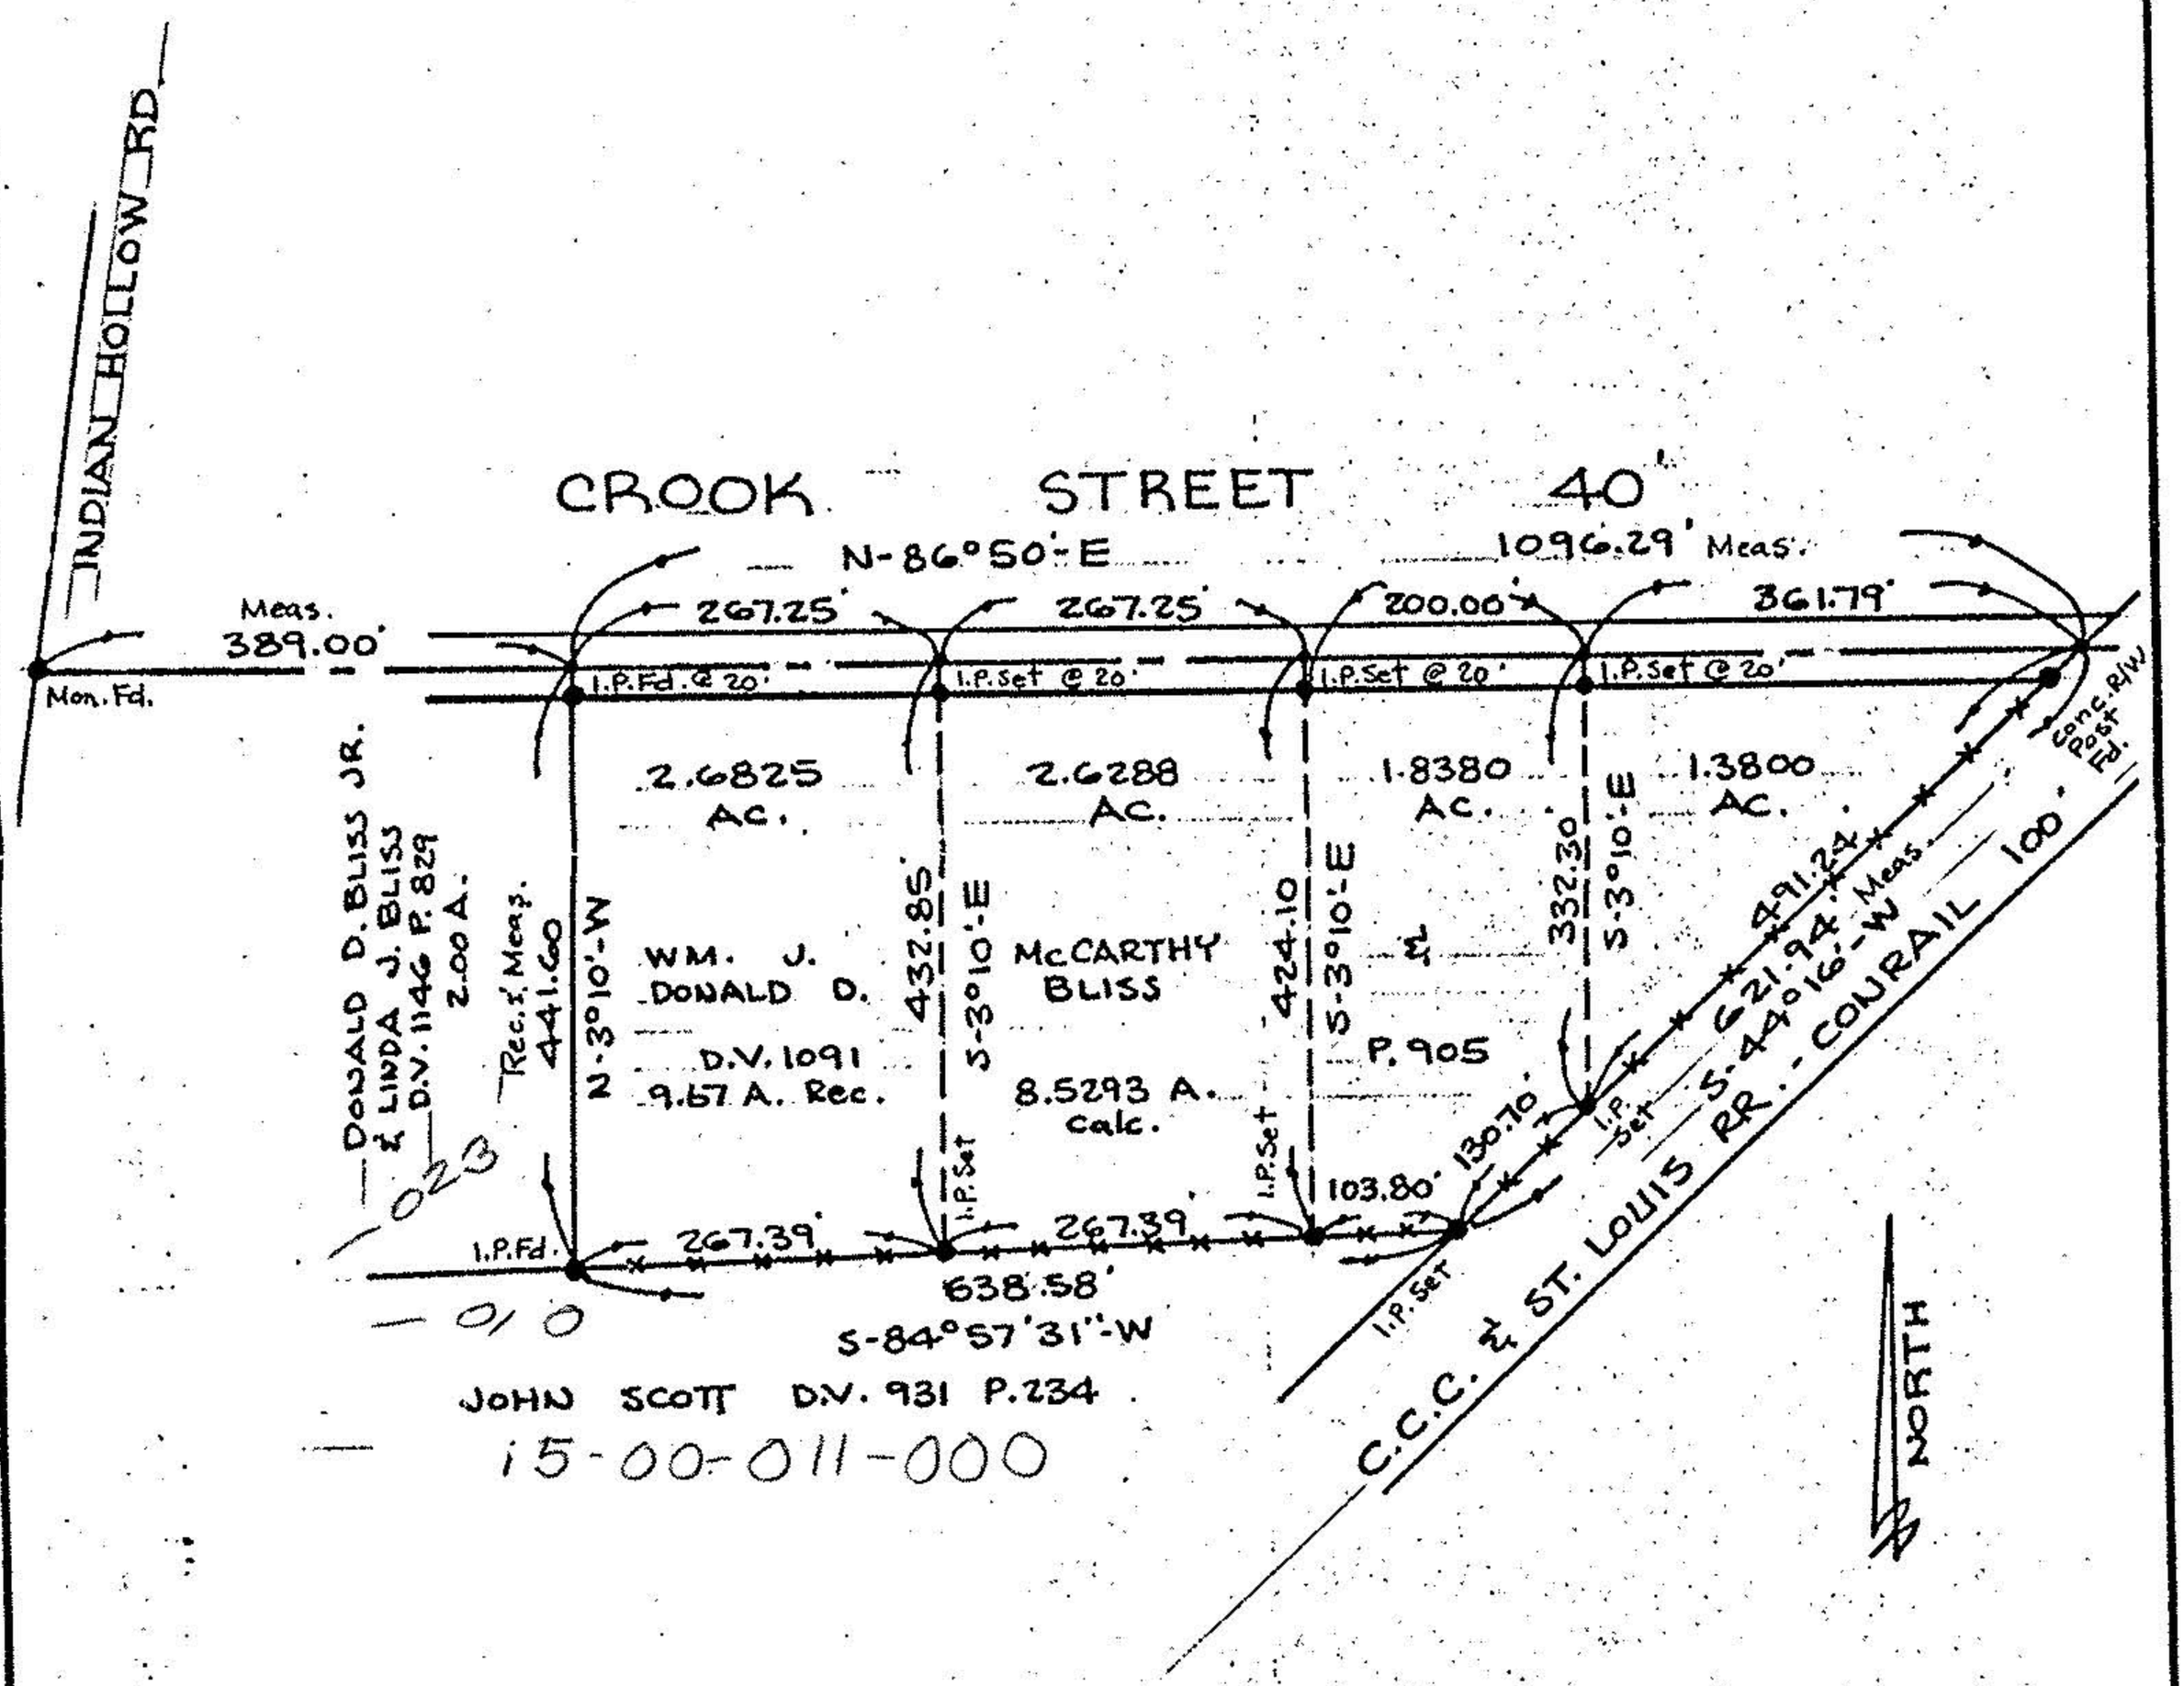

#16644

APPROVED
LORAIN CO.
MAP DEPT.
DATE 3-18-86
15-D
C. FRANCIS
2ND AFTER

Prepared for: ATTORNEY ALAN D. SCHNITKEY
422 E.S.T. BLDG. ELYRIA, OHIO

Scale: 1" = 200'	Date: 2-20-86	Dr. by: DE	Job No. 86-24