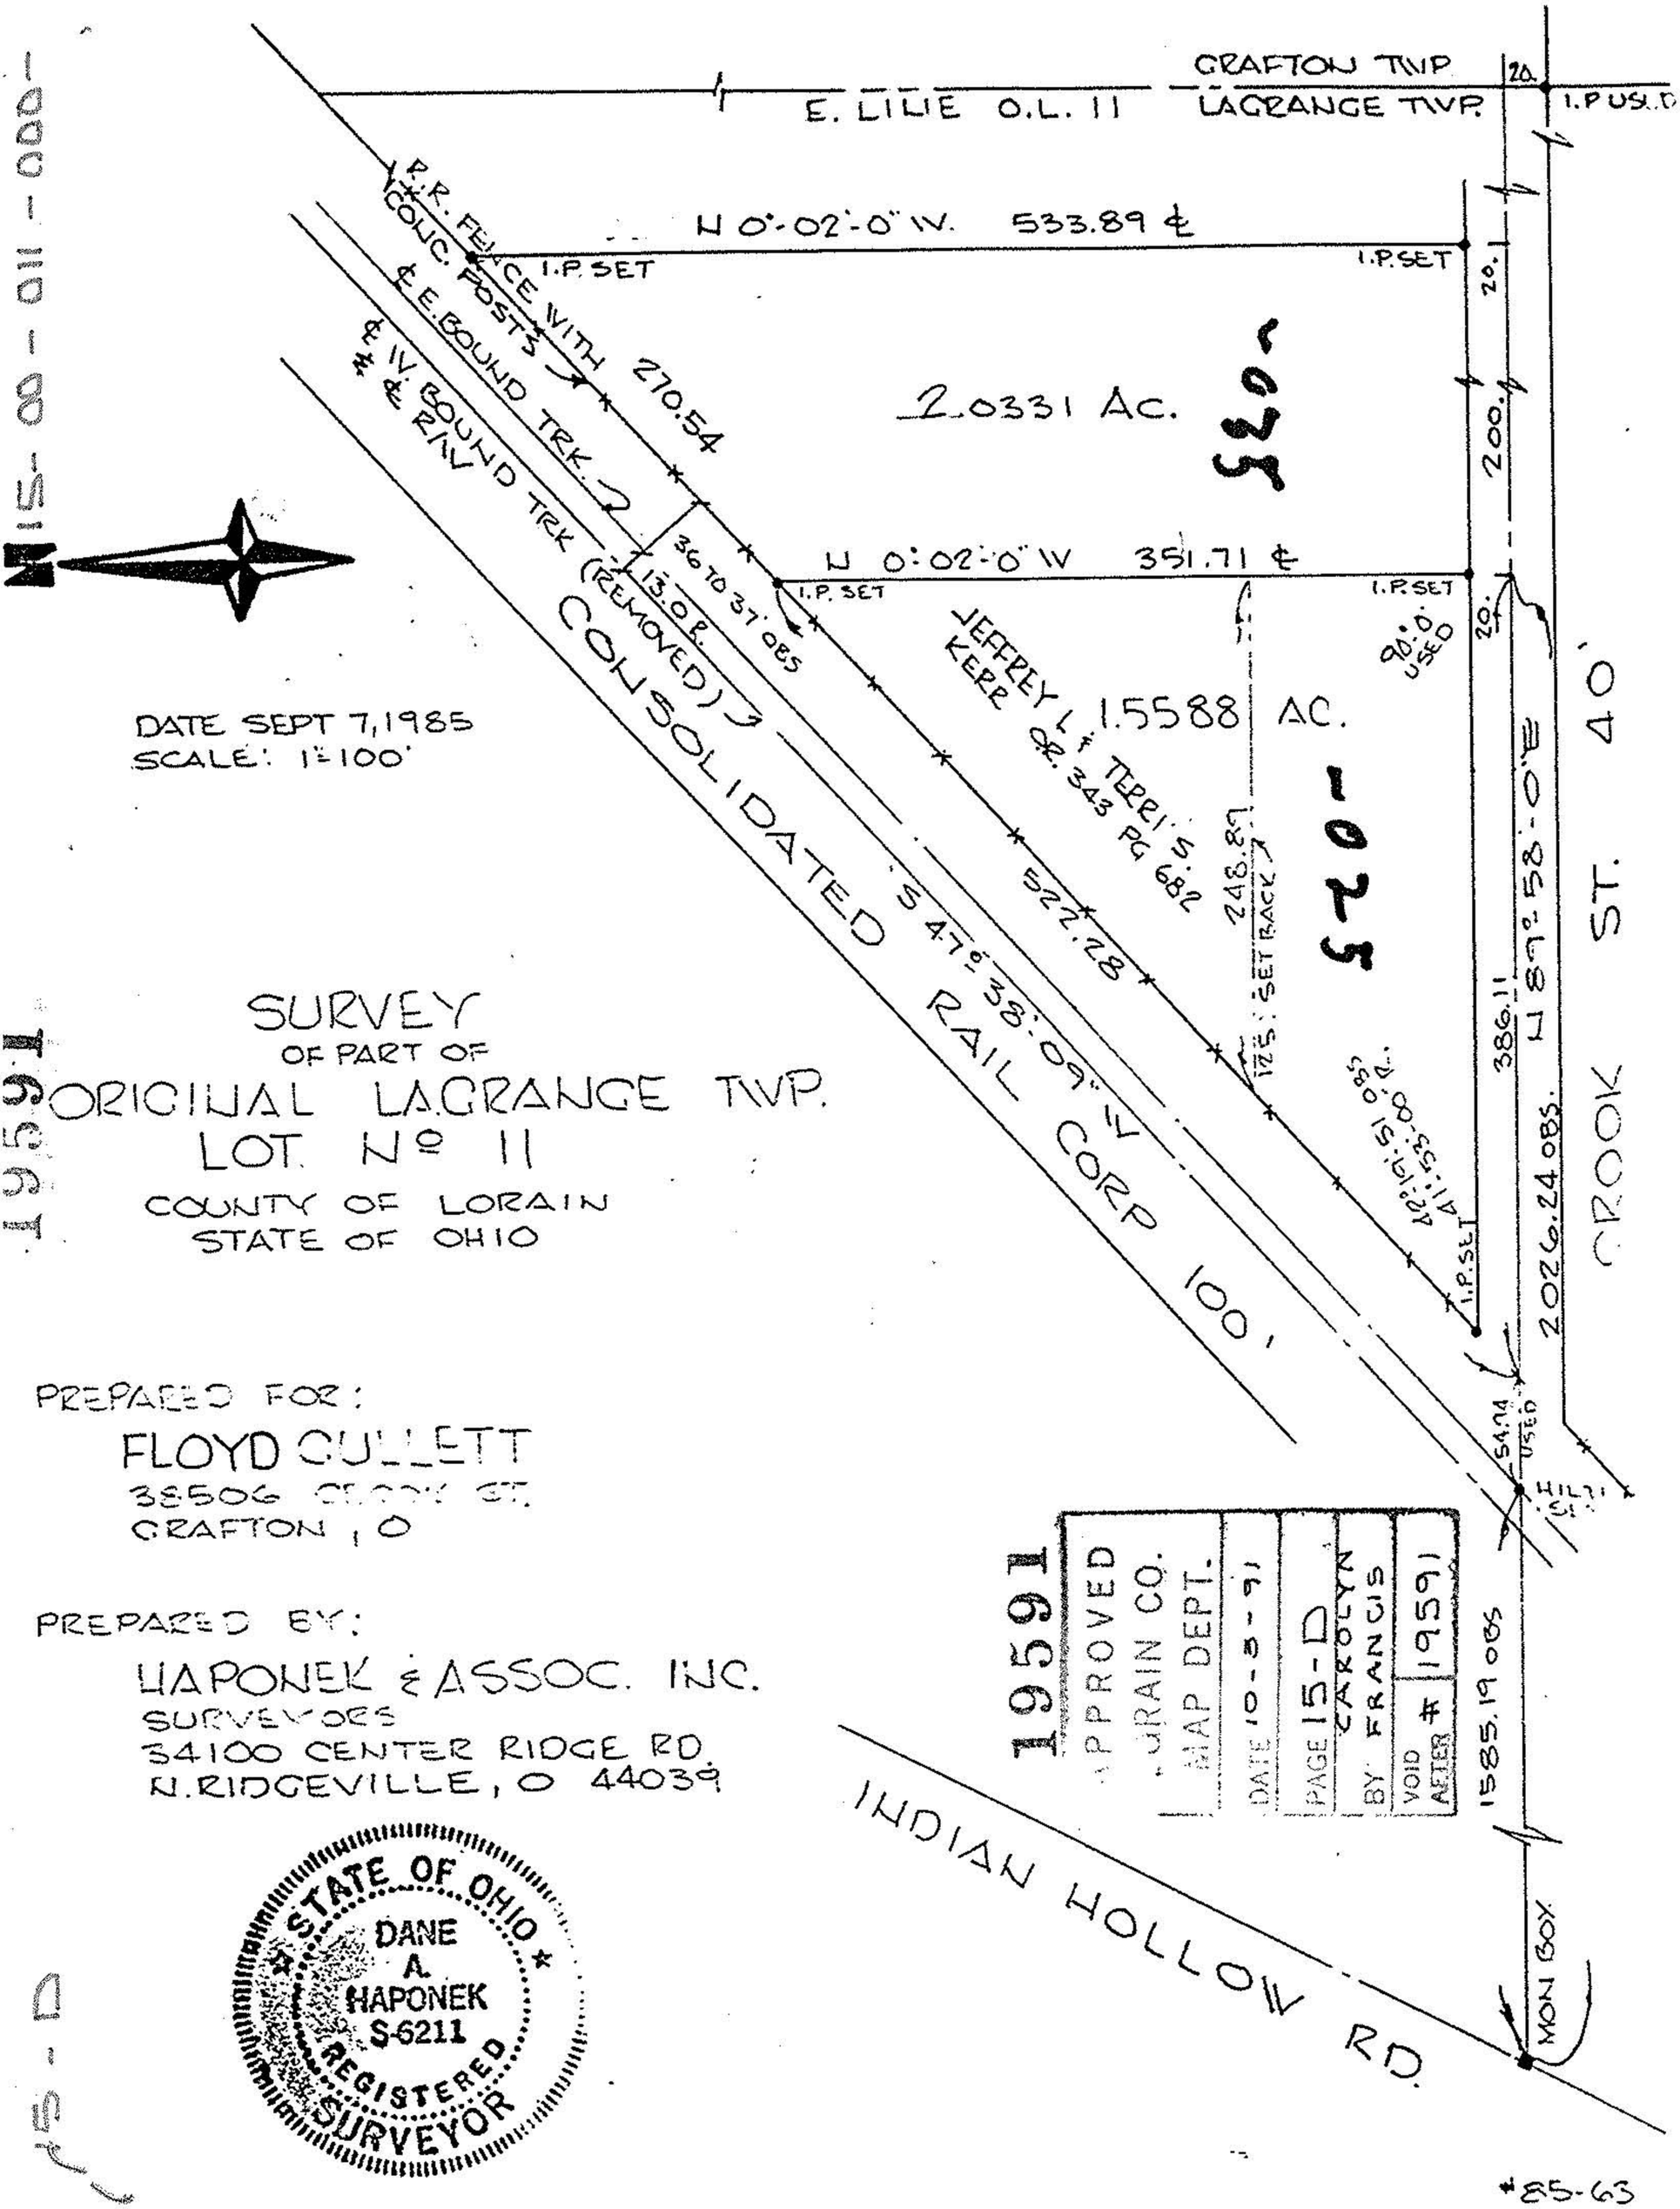

DATE SEPT 7, 1985
SCALE: 1"=100'

SURVEY
OF PART OF
ORIGINAL LAGRANGE TWP.
LOT Nº 11
COUNTY OF LORAIN
STATE OF OHIO

PREPARED FOR:
FLOYD CULLETT
38506 CROOK ST.
GRAFTON, O

PREPARED BY:
HAPONEK & ASSOC. INC.
SURVEYORS
34100 CENTER RIDGE RD
N. RIDGEVILLE, O 44039

STATE OF OHIO
DANE A. HAPONEK
S-6211
REGISTERED SURVEYOR

19591
APPROVED
LORAIN CO.
MAP DEPT.
DATE 10-3-91
PAGE 15-D
BY CAROLYN FRANCIS
VOID AFTER # 19591

#85-63