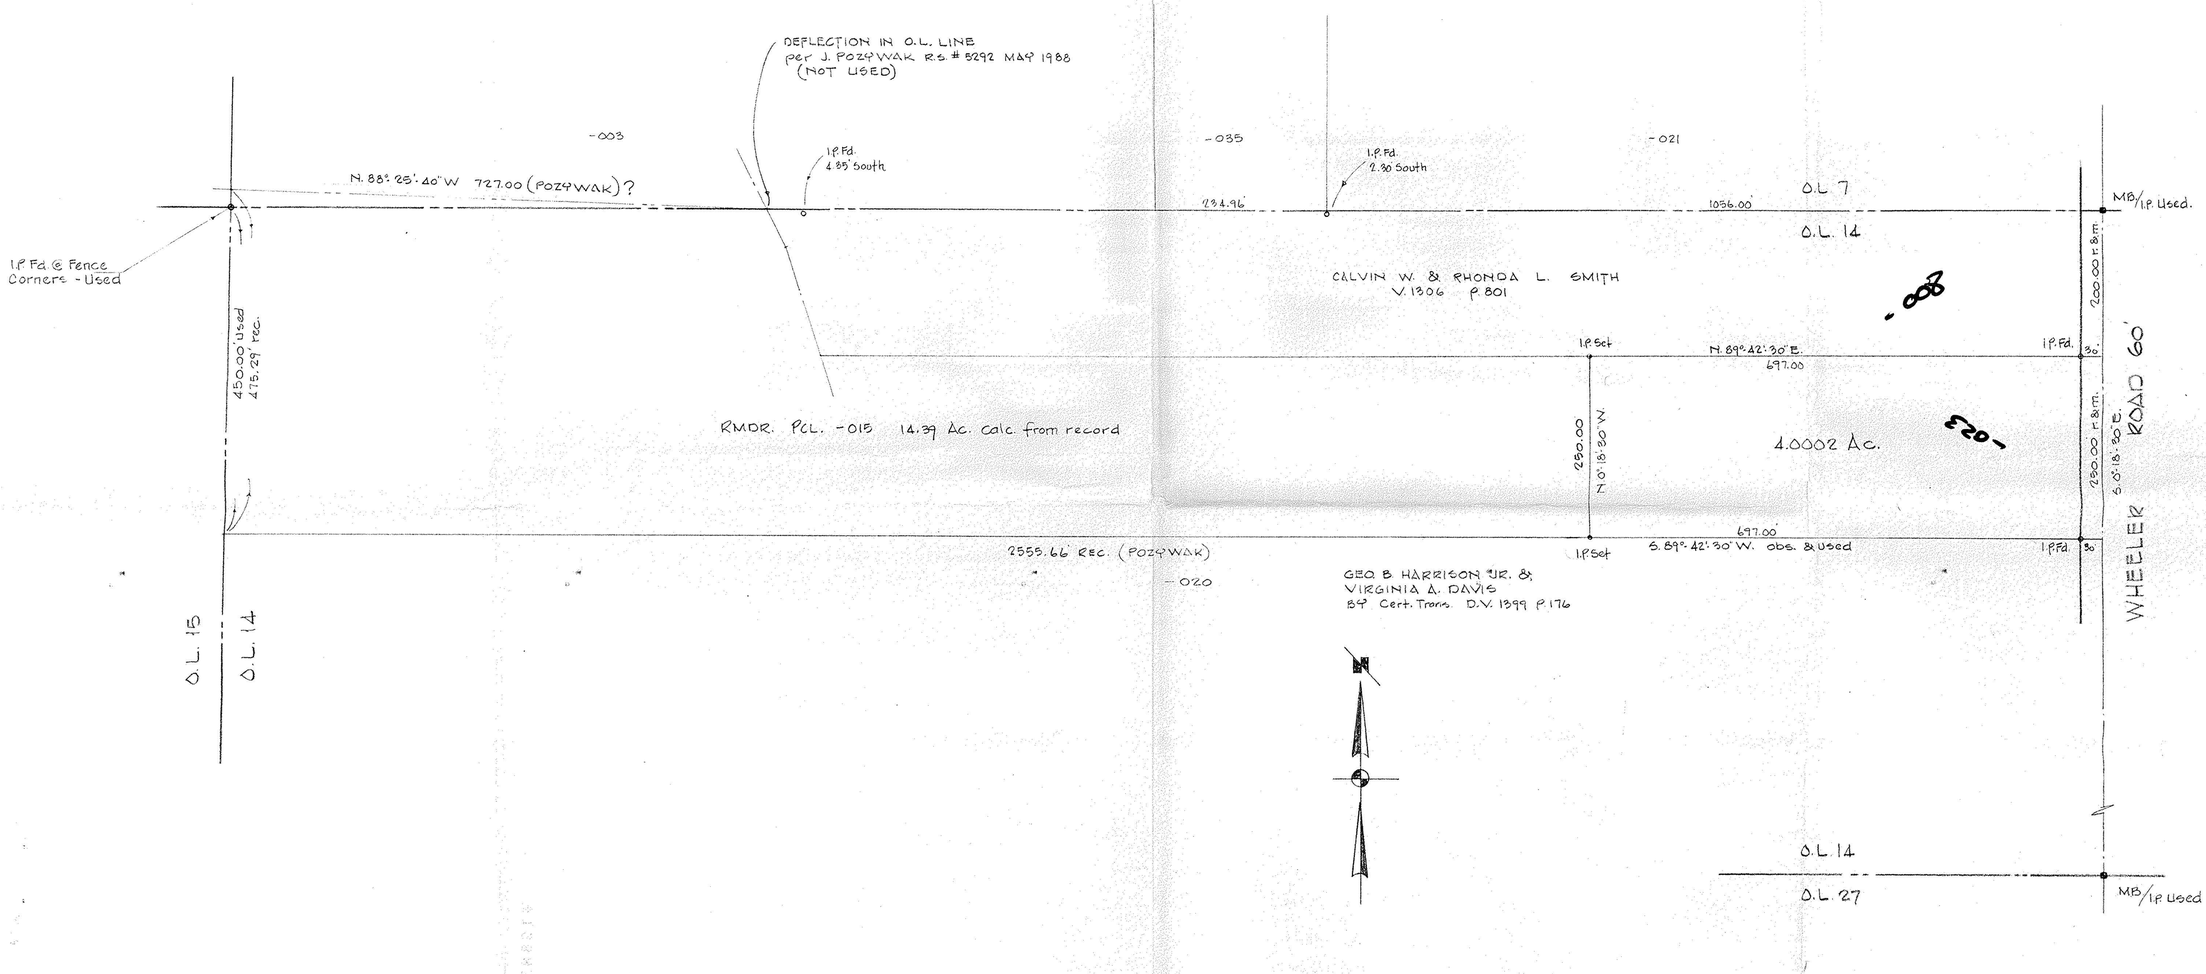

19881

APPROVED
LORAIN CO.
MAP DEPT.
DATE 4-28-92
PAGE 15-C
BY CAROLYN FRANCIS
VOID AFTER # 19881
15-00-014-000

SURVEY FOR

CALVIN W. & RHONDA L. SMITH

PART OF O.L. 14 TOWNSHIP OF LAGRANGE
COUNTY OF LORAIN STATE OF OHIO

SCALE 1" = 100 MARCH, 1992

LAUNDON · SIMON · CAHL & ASSOC.
ENGINEERS SURVEYORS

JOB No: 92-2168
F.B. 223 P. 11 APR 6 1992

STATE OF OHIO
RODGER G. SIMON
5201
REGISTERED SURVEYOR

REV. 4-6-92 R.G.S.