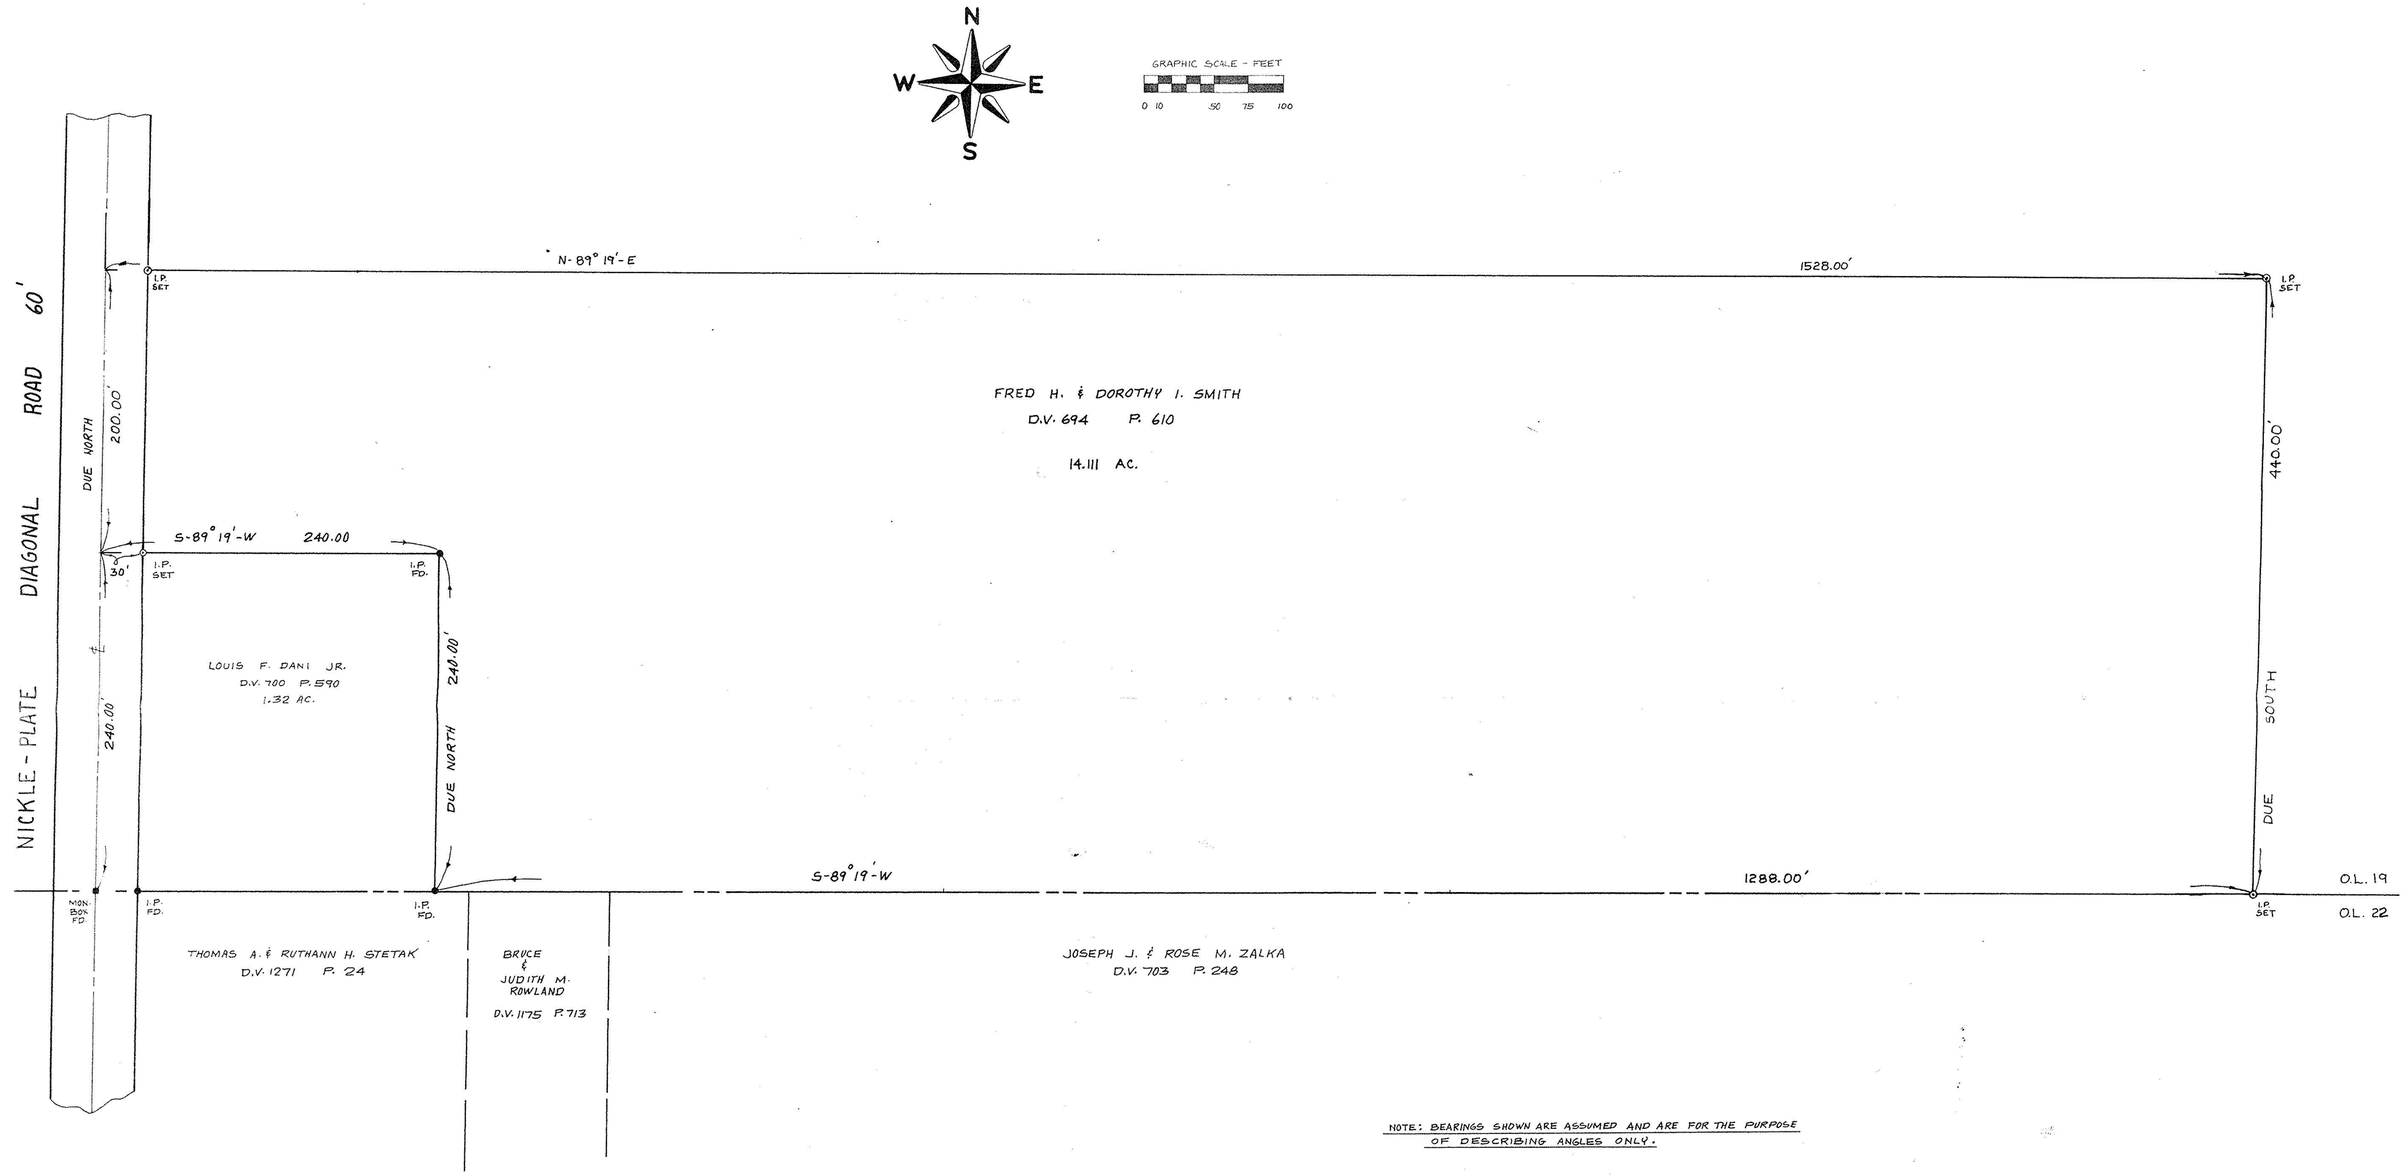

NOTE: BEARINGS SHOWN ARE ASSUMED AND ARE FOR THE PURPOSE OF DESCRIBING ANGLES ONLY.

#16502
APPROVED
LORAIN CO.
MAP DEPT.
DATE 12.16.85
PAGE 15-A
BY T. McNair
VOID METER

PROJECT
BOUNDARY SURVEY
PART OF ORIGINAL LaGRANGE TOWNSHIP LOT 19
TOWNSHIP OF LaGRANGE, COUNTY OF LORAIN, STATE OF OHIO

Rev. 9-24-85 10-9-85

Prepared for
FRED SMITH
15177 DIAGONAL ROAD
LaGRANGE, OHIO 44050

Drawn by: K.V.S.
Checked by: [illegible]
App. by: [illegible]
Scale: 1" = 60'
Date: Sept. 10th., 1985

KLEINOEDER · SCHMIDT
and ASSOCIATES
ENGINEERS — SURVEYORS — CONSULTANTS in LAND PLANNING
ELYRIA OHIO

REFERENCES
P.P.# 15-00-019-000-004

SHEET NO. 1 of 1

JOB NO. 85-100