LAUNDON • SIMON • CAHL & ASSOC., INC.
PROFESSIONAL LAND SURVEYORS
110 MIDDLE AVE., ELYRIA, O. 44035

SURVEY & SPLIT FOR:
ROBERT & ARLENE WACKER
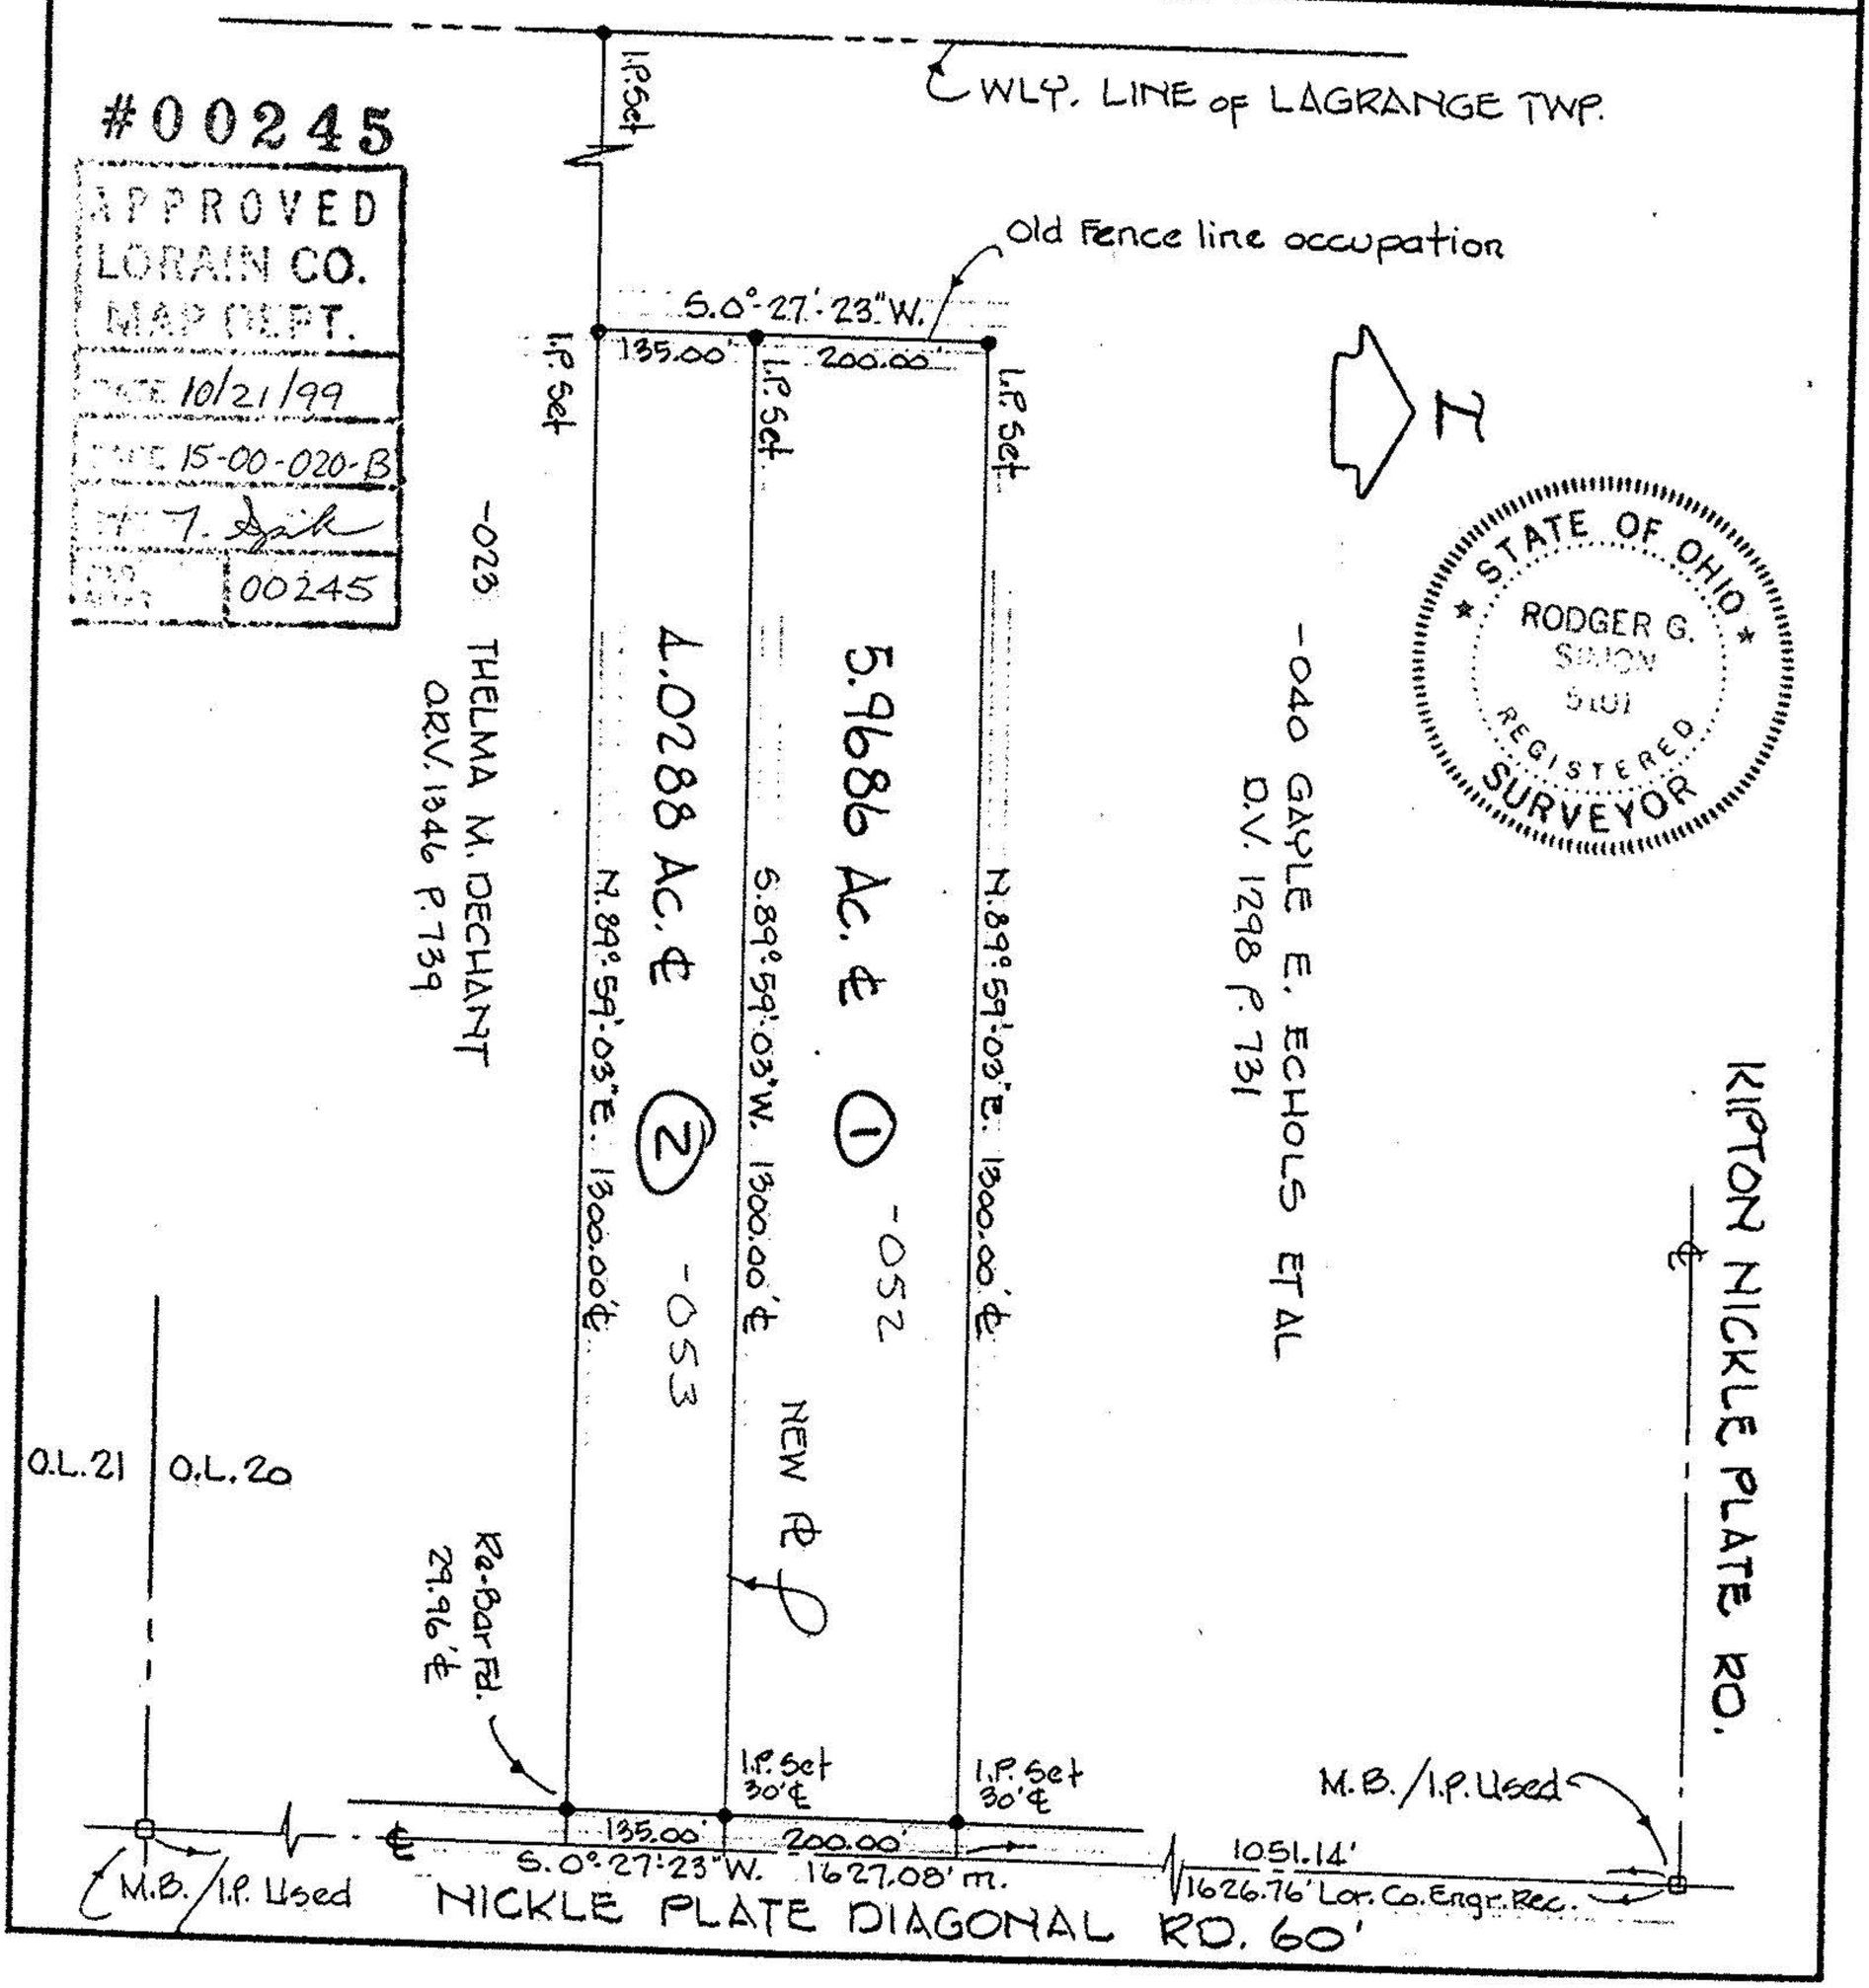
Orig. Lot No. 20	City of	Date SEPT. '99 Scale 1" = 200'
Orig. Sec No.	Village of	Dwn. by R.G.S. Chkd. by R.C.
Tract	County of LORAIN	Job No. 99-3179 F.B. 245/71
Township of LAGRANGE	State of Ohio	Printed