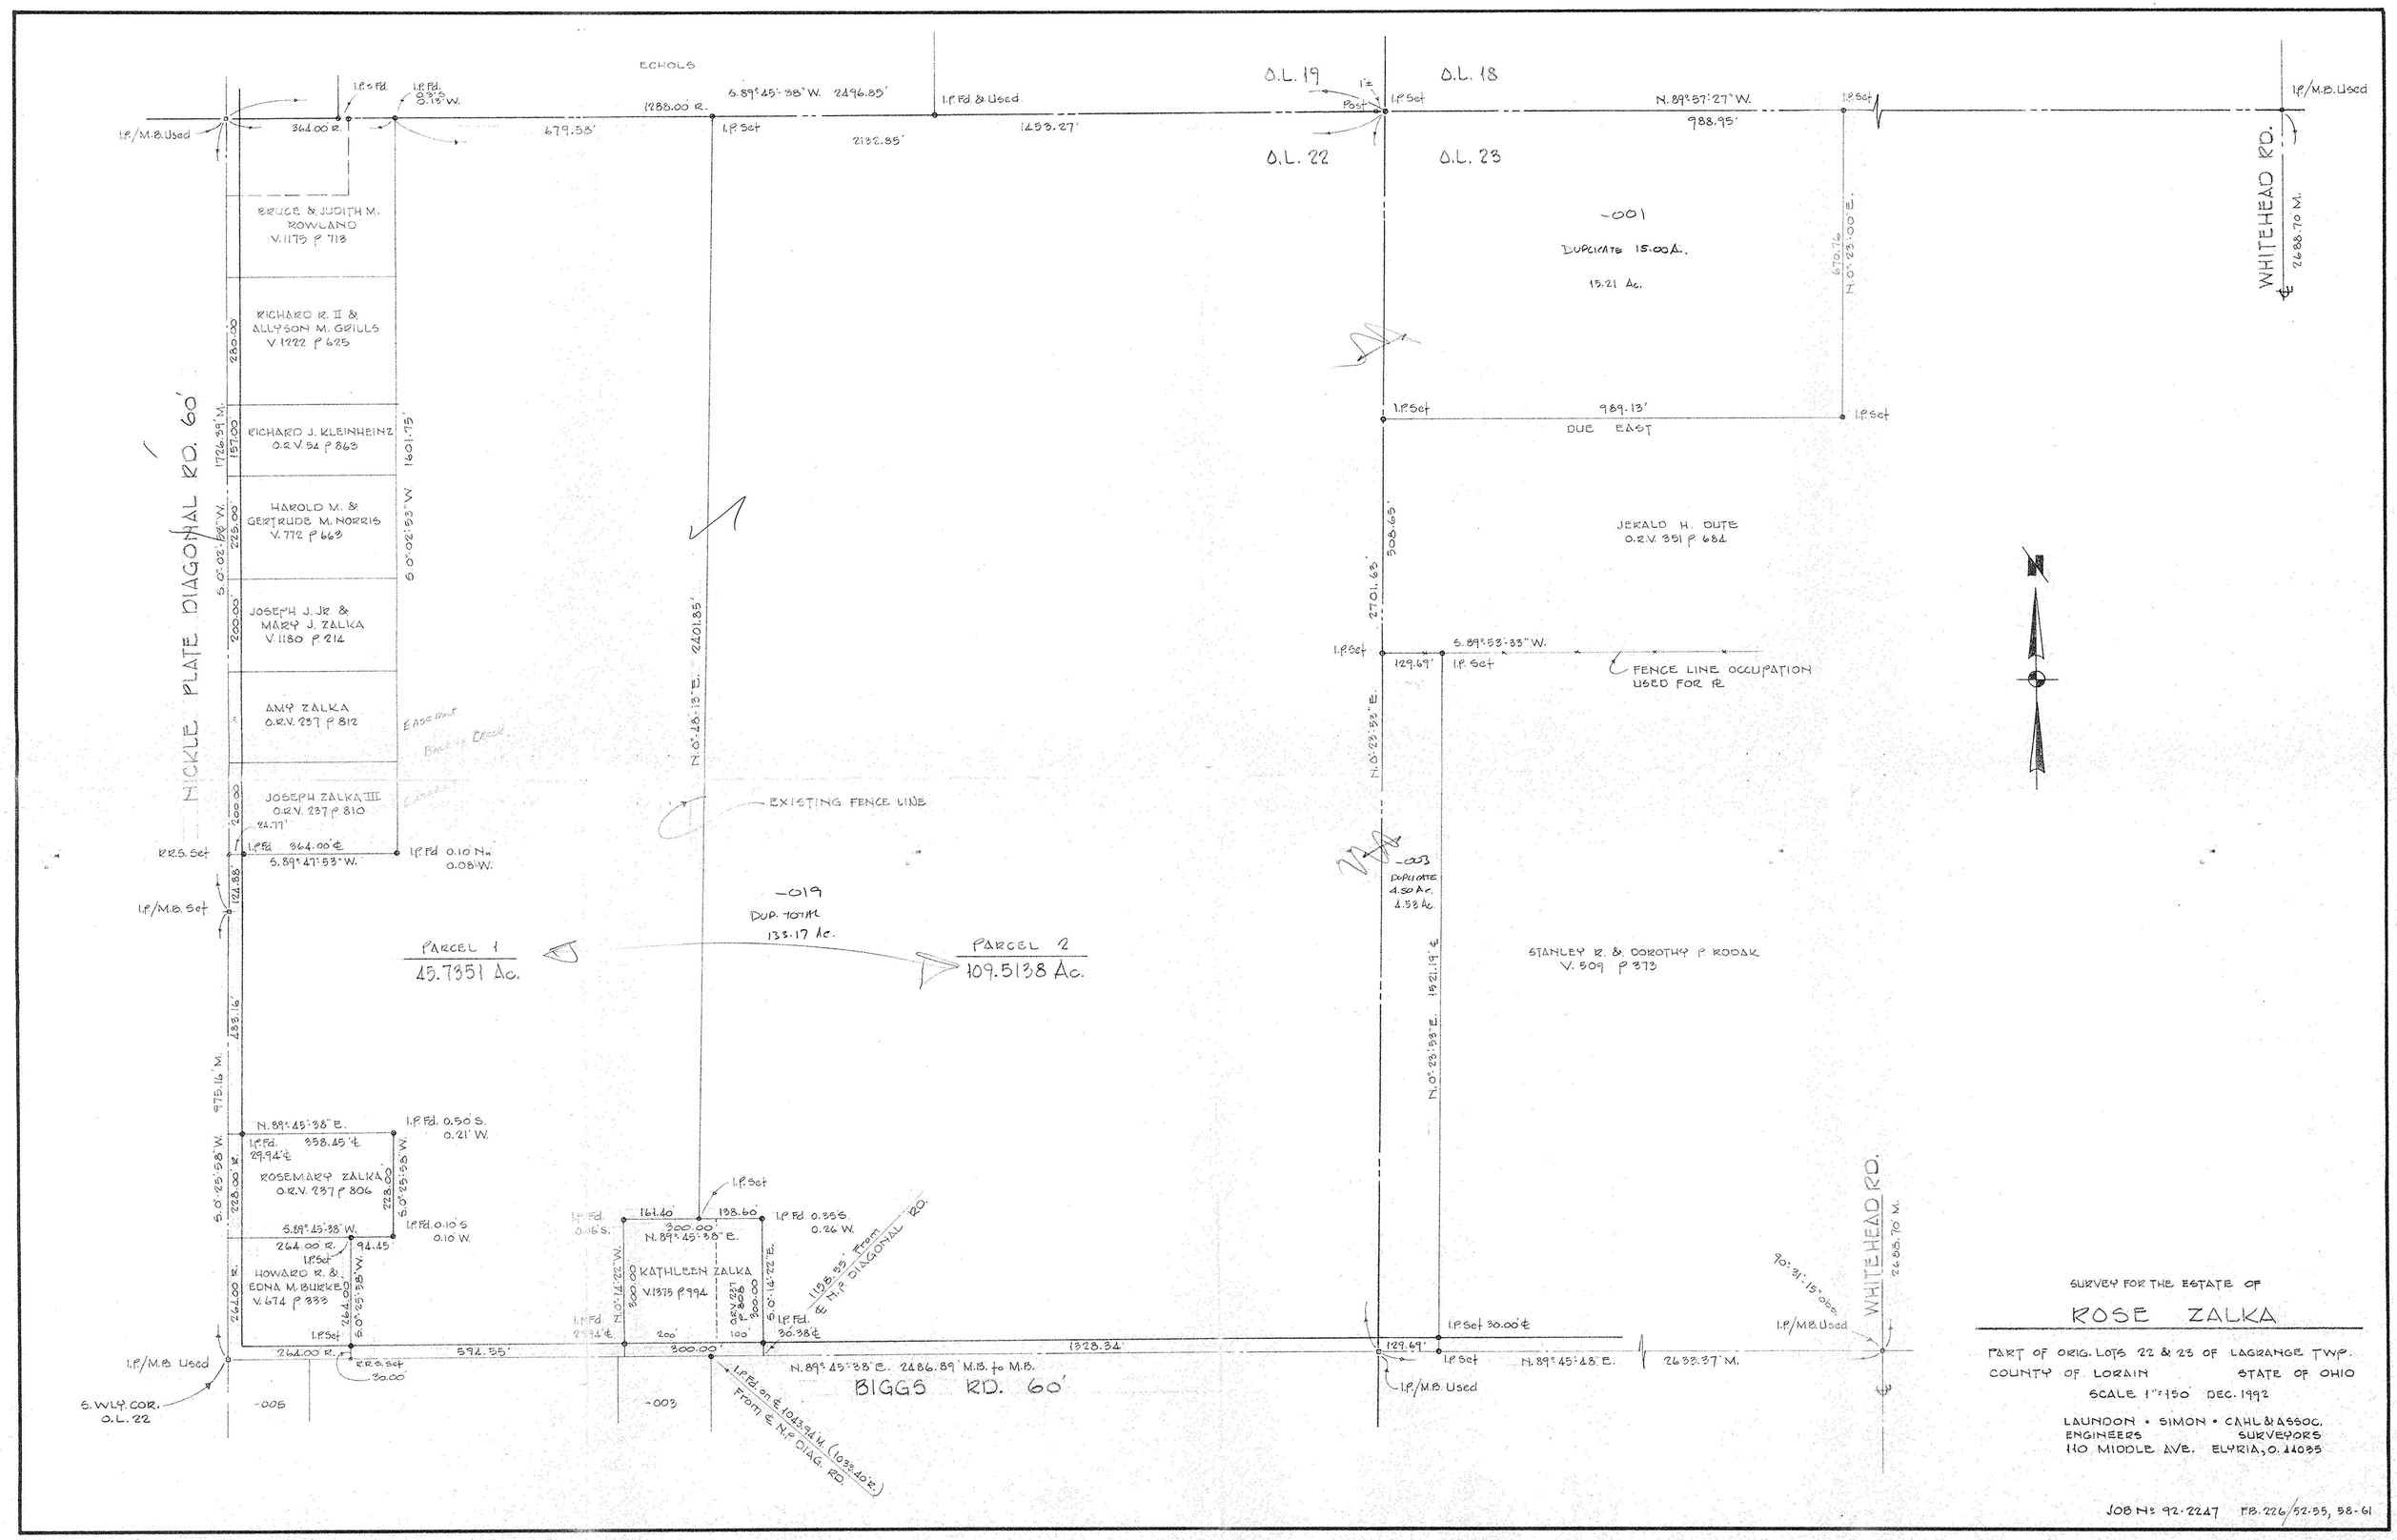

SURVEY FOR THE ESTATE OF

ROSE ZALKA

PART OF ORIG. LOTS 22 & 23 OF LAGRANGE TWP.
COUNTY OF LORAIN STATE OF OHIO
SCALE 1" = 150' DEC. 1992

LAUNDON • SIMON • CAHL & ASSOC.
ENGINEERS SURVEYORS
110 MIDDLE AVE. ELYRIA, O. 44035

JOB No: 92-2247 FB. 226/52-55, 58-61