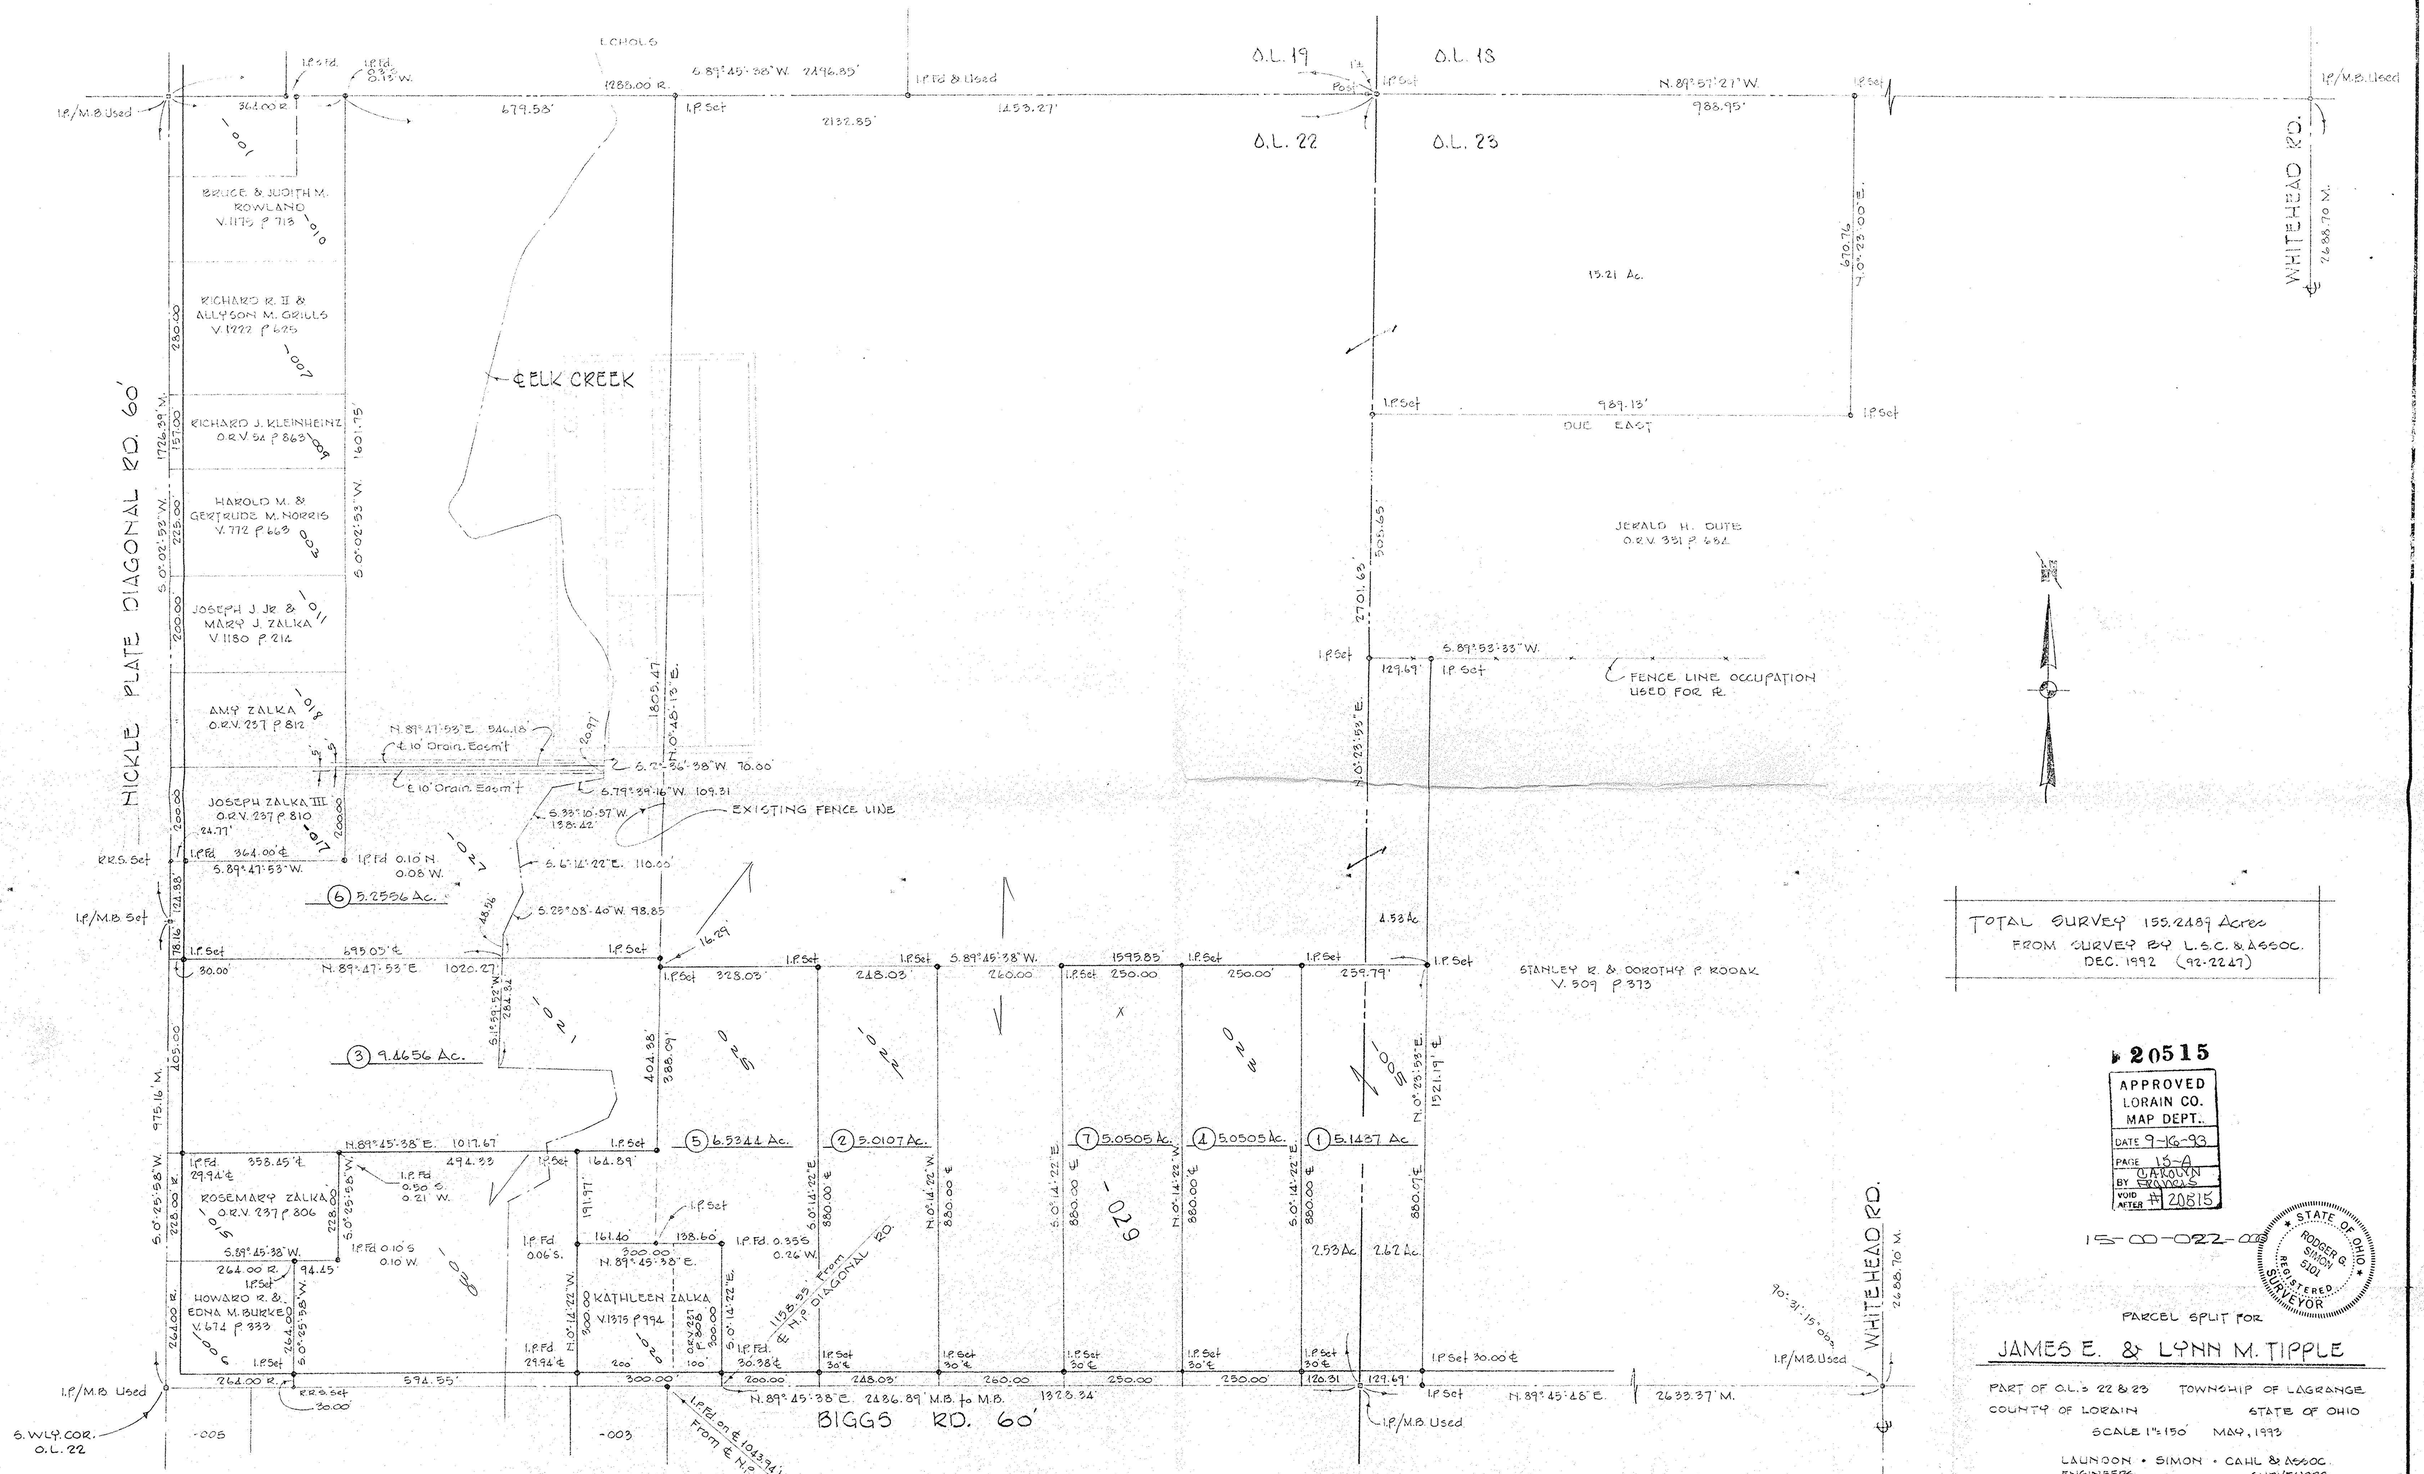
HICKLE PLATE DIAGONAL RD. 60'
BIGGS RD. 60'
WHITEHEAD RD.
BRUCE & JUDITH M. ROWLAND V. 1175 P. 713
RICHARD R. II & ALLYSON M. GRILLS V. 1222 P. 625
RICHARD J. KLEINHEINZ O.R.V. 54 P. 863
HAROLD M. & GERTRUDE M. NORRIS V. 772 P. 663
JOSEPH J. JR & MARY J. ZALKA V. 1150 P. 212
AMY ZALKA O.R.V. 237 P. 812
JOSEPH ZALKA III O.R.V. 237 P. 810
ROSEMARY ZALKA O.R.V. 237 P. 806
HOWARD R. & EDNA M. BURKE V. 674 P. 333
KATHLEEN ZALKA V. 1375 P. 994
JERALD H. DUTE O.R.V. 351 P. 681
STANLEY R. & DOROTHY P. ROOAK V. 509 P. 373
℄ ELK CREEK
O.L. 19
O.L. 18
O.L. 22
O.L. 23
15.21 Ac.
6.2556 Ac.
9.1656 Ac.
6.5344 Ac.
5.0107 Ac.
5.0505 Ac.
5.0505 Ac.
5.1437 Ac
2.53 Ac
2.62 Ac
4.58 Ac
EXISTING FENCE LINE
FENCE LINE OCCUPATION USED FOR R.
DUE EAST
N.89°57'27"W.
S.89°45'38"W.
N.89°45'38"E.
S.0°02'53"W.
N.0°48'13"E.
S.0°23'53"E.
N.0°23'53"E.
S.0°14'22"E.
N.0°14'22"W.
S.0°25'58"W.
S.89°47'53"W.
N.89°47'53"E.
S.79°39'16"W.
S.33°10'57"W.
S.6°14'22"E.
S.28°08'40"W.
S.89°53'33"W.
N.89°45'28"E.
S.WLY. COR. O.L. 22
I.P/M.B. Used
I.P/M.B. Set
R.R.S. Set
I.P. Set
I.P. Fd.
Post
TOTAL SURVEY 155.2489 Acres
FROM SURVEY BY L.S.C. & ASSOC.
DEC. 1992 (92-2247)
20515
APPROVED
LORAIN CO.
MAP DEPT.
DATE 9-16-93
PAGE 15-A
BY DARLYN
VOID AFTER #20515
15-00-022-000
STATE OF OHIO
RODGER G. SIMON
5101
REGISTERED SURVEYOR
PARCEL SPLIT FOR
JAMES E. & LYNN M. TIPPLE
PART OF O.L.s 22 & 23 TOWNSHIP OF LAGRANGE
COUNTY OF LORAIN STATE OF OHIO
SCALE 1"=150' MAY, 1993
LAUNDON • SIMON • CAHL & ASSOC.
ENGINEERS SURVEYORS
110 MIDDLE AVE. ELYRIA, O. 44035
JOB No. 93-2311 F.B. 226/52-55, 58-61
REV. 7-21-93 PCL. 7
REV. 6-21-93 PCL. 6
REV. 6-18-93 Corr. to PCL. 1 R.G.S.
REV. 6-3-93 PCL. 5
REV. 6-1-93 PCL. 4
REV. 5-28-93 PCL. 3