


1

RUSSIA TWP. PAGE 4
Twp line

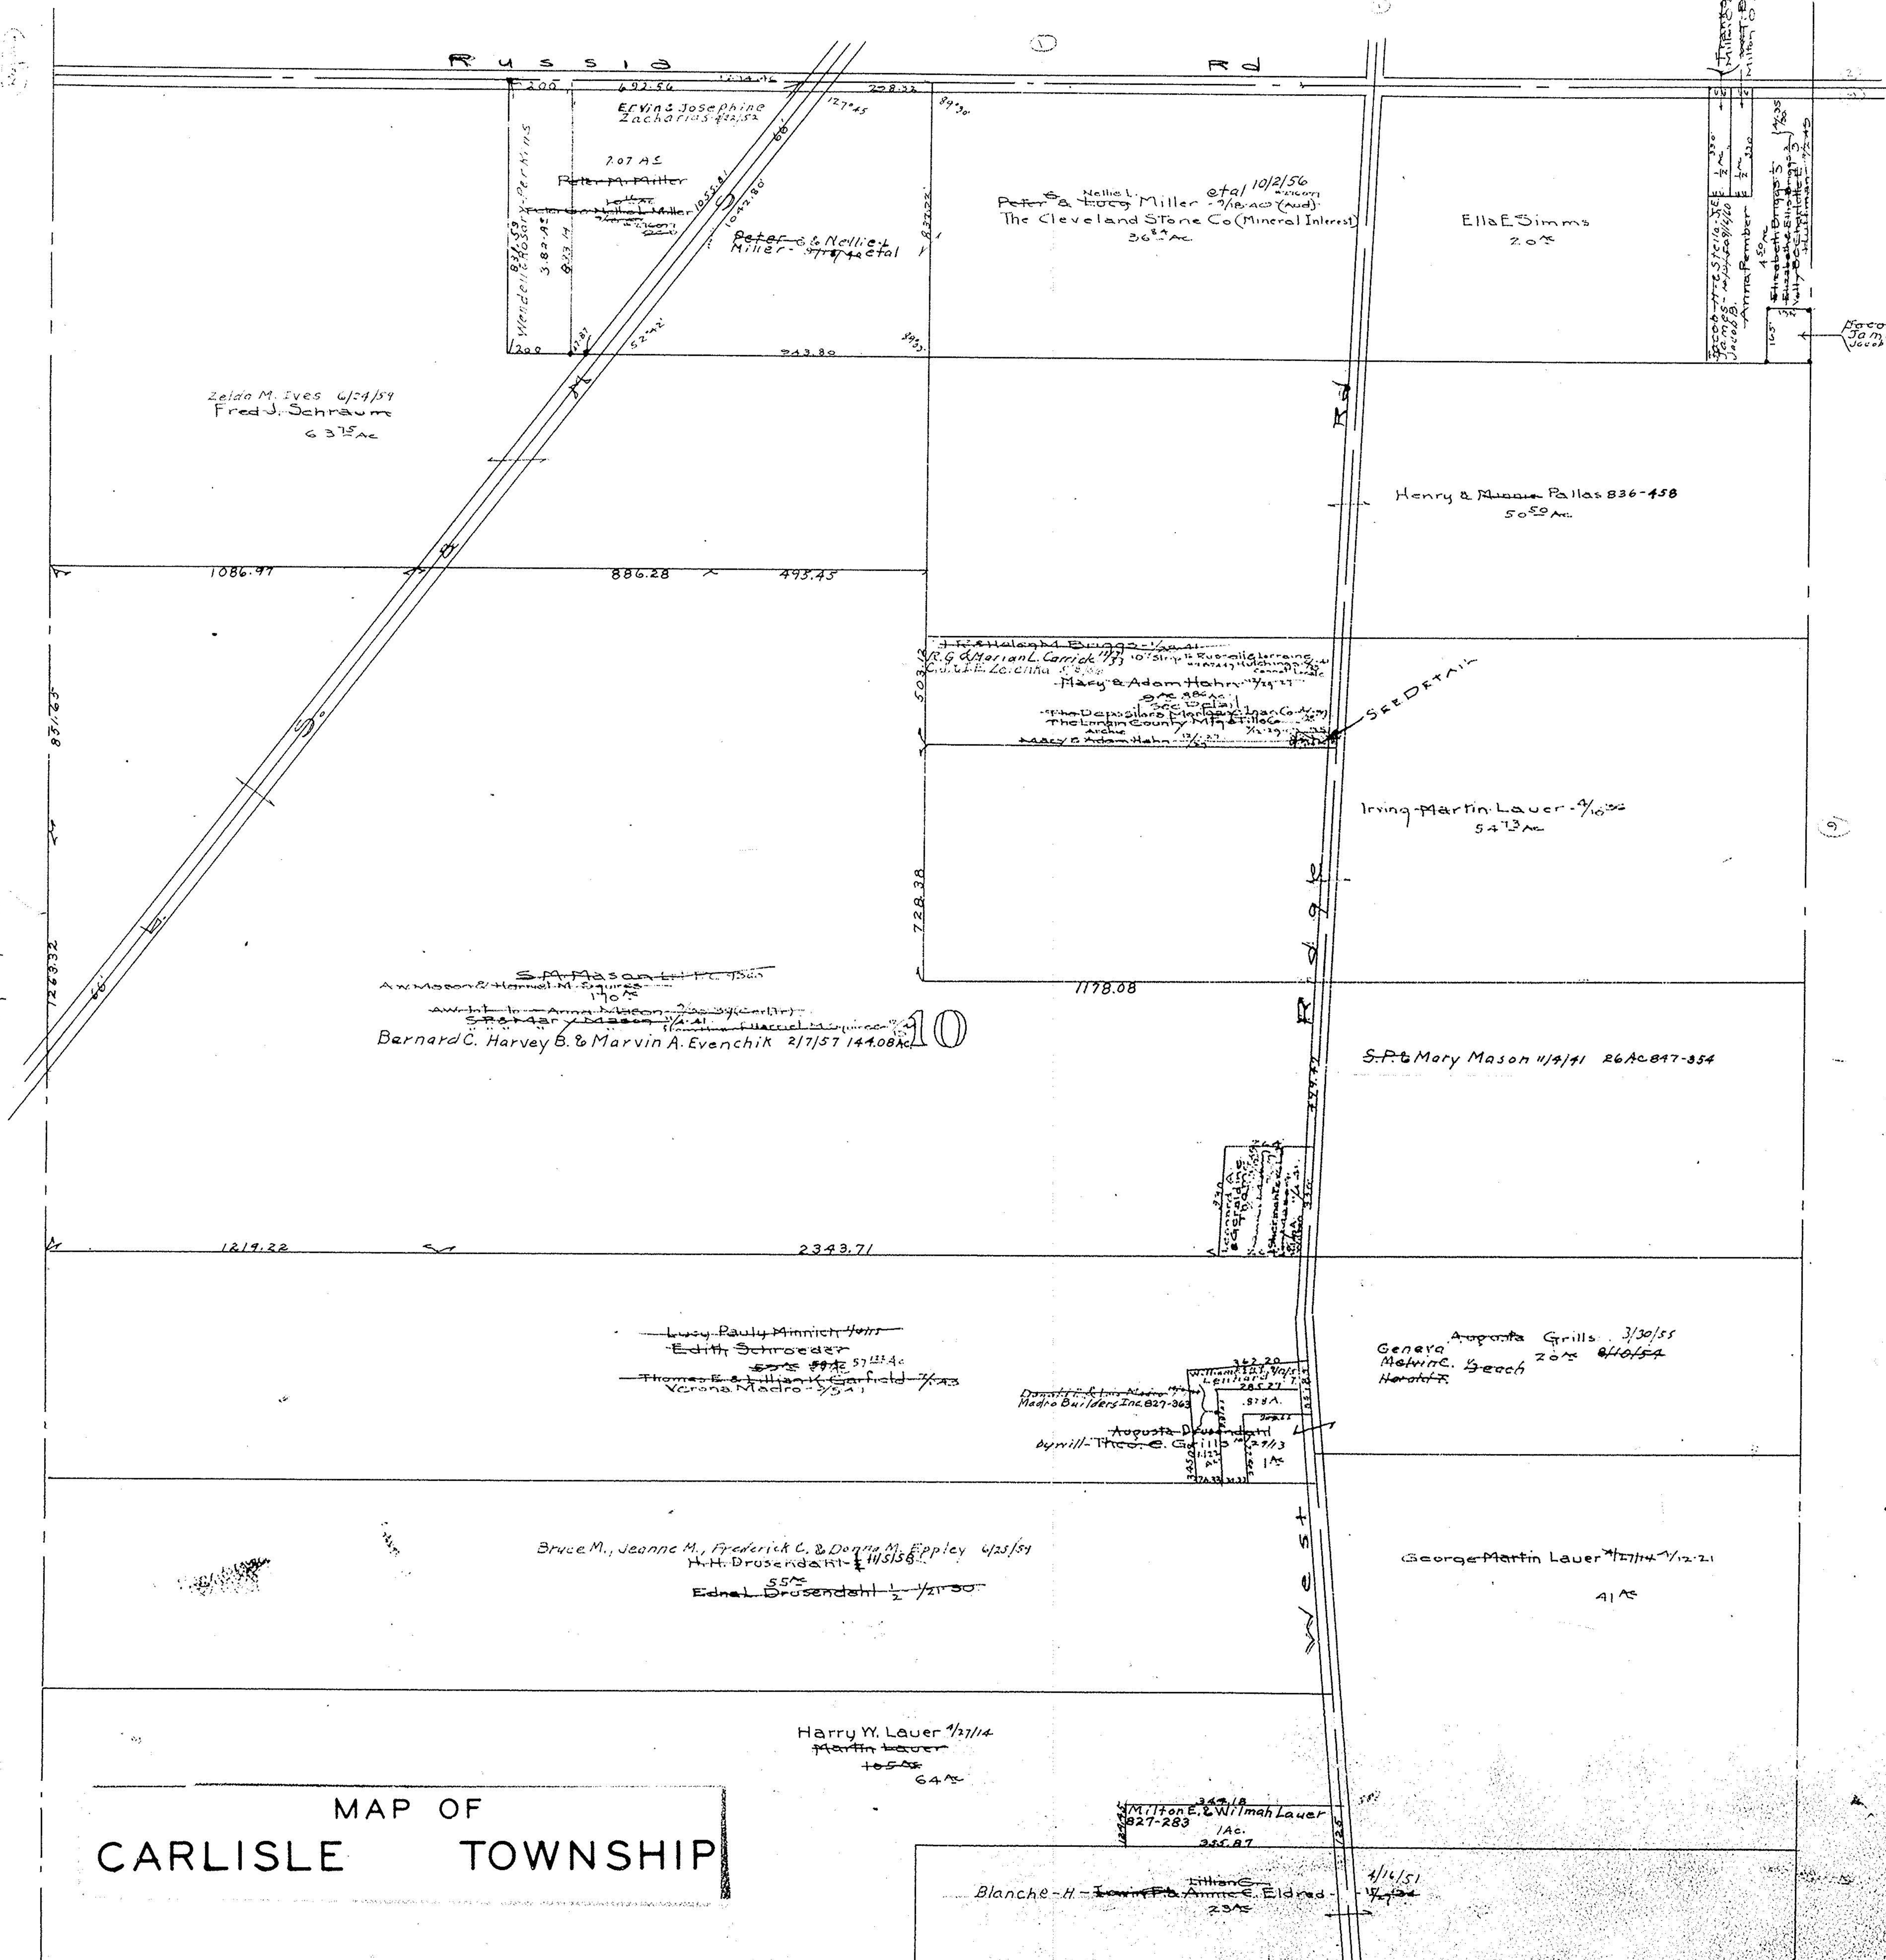

CARLISLE TWP
Scale 1" = 300
NW Part

27.5
John ...
Cords ...

West Ridge Rd

Mabel Eldred 7/2/50
Harvey H. Andrews 4/4/44
William A. & G. E. Peabody 4/11/58

9

MAP OF CARLISLE TOWNSHIP

COPYRIGHT 1962
U.S. CODE, TITLE 17
LORAIN COUNTY, OHIO
Reproduced by,
Allied Microfilm Corp.
Akron, Ohio

11