#18950 15-00-027-000-

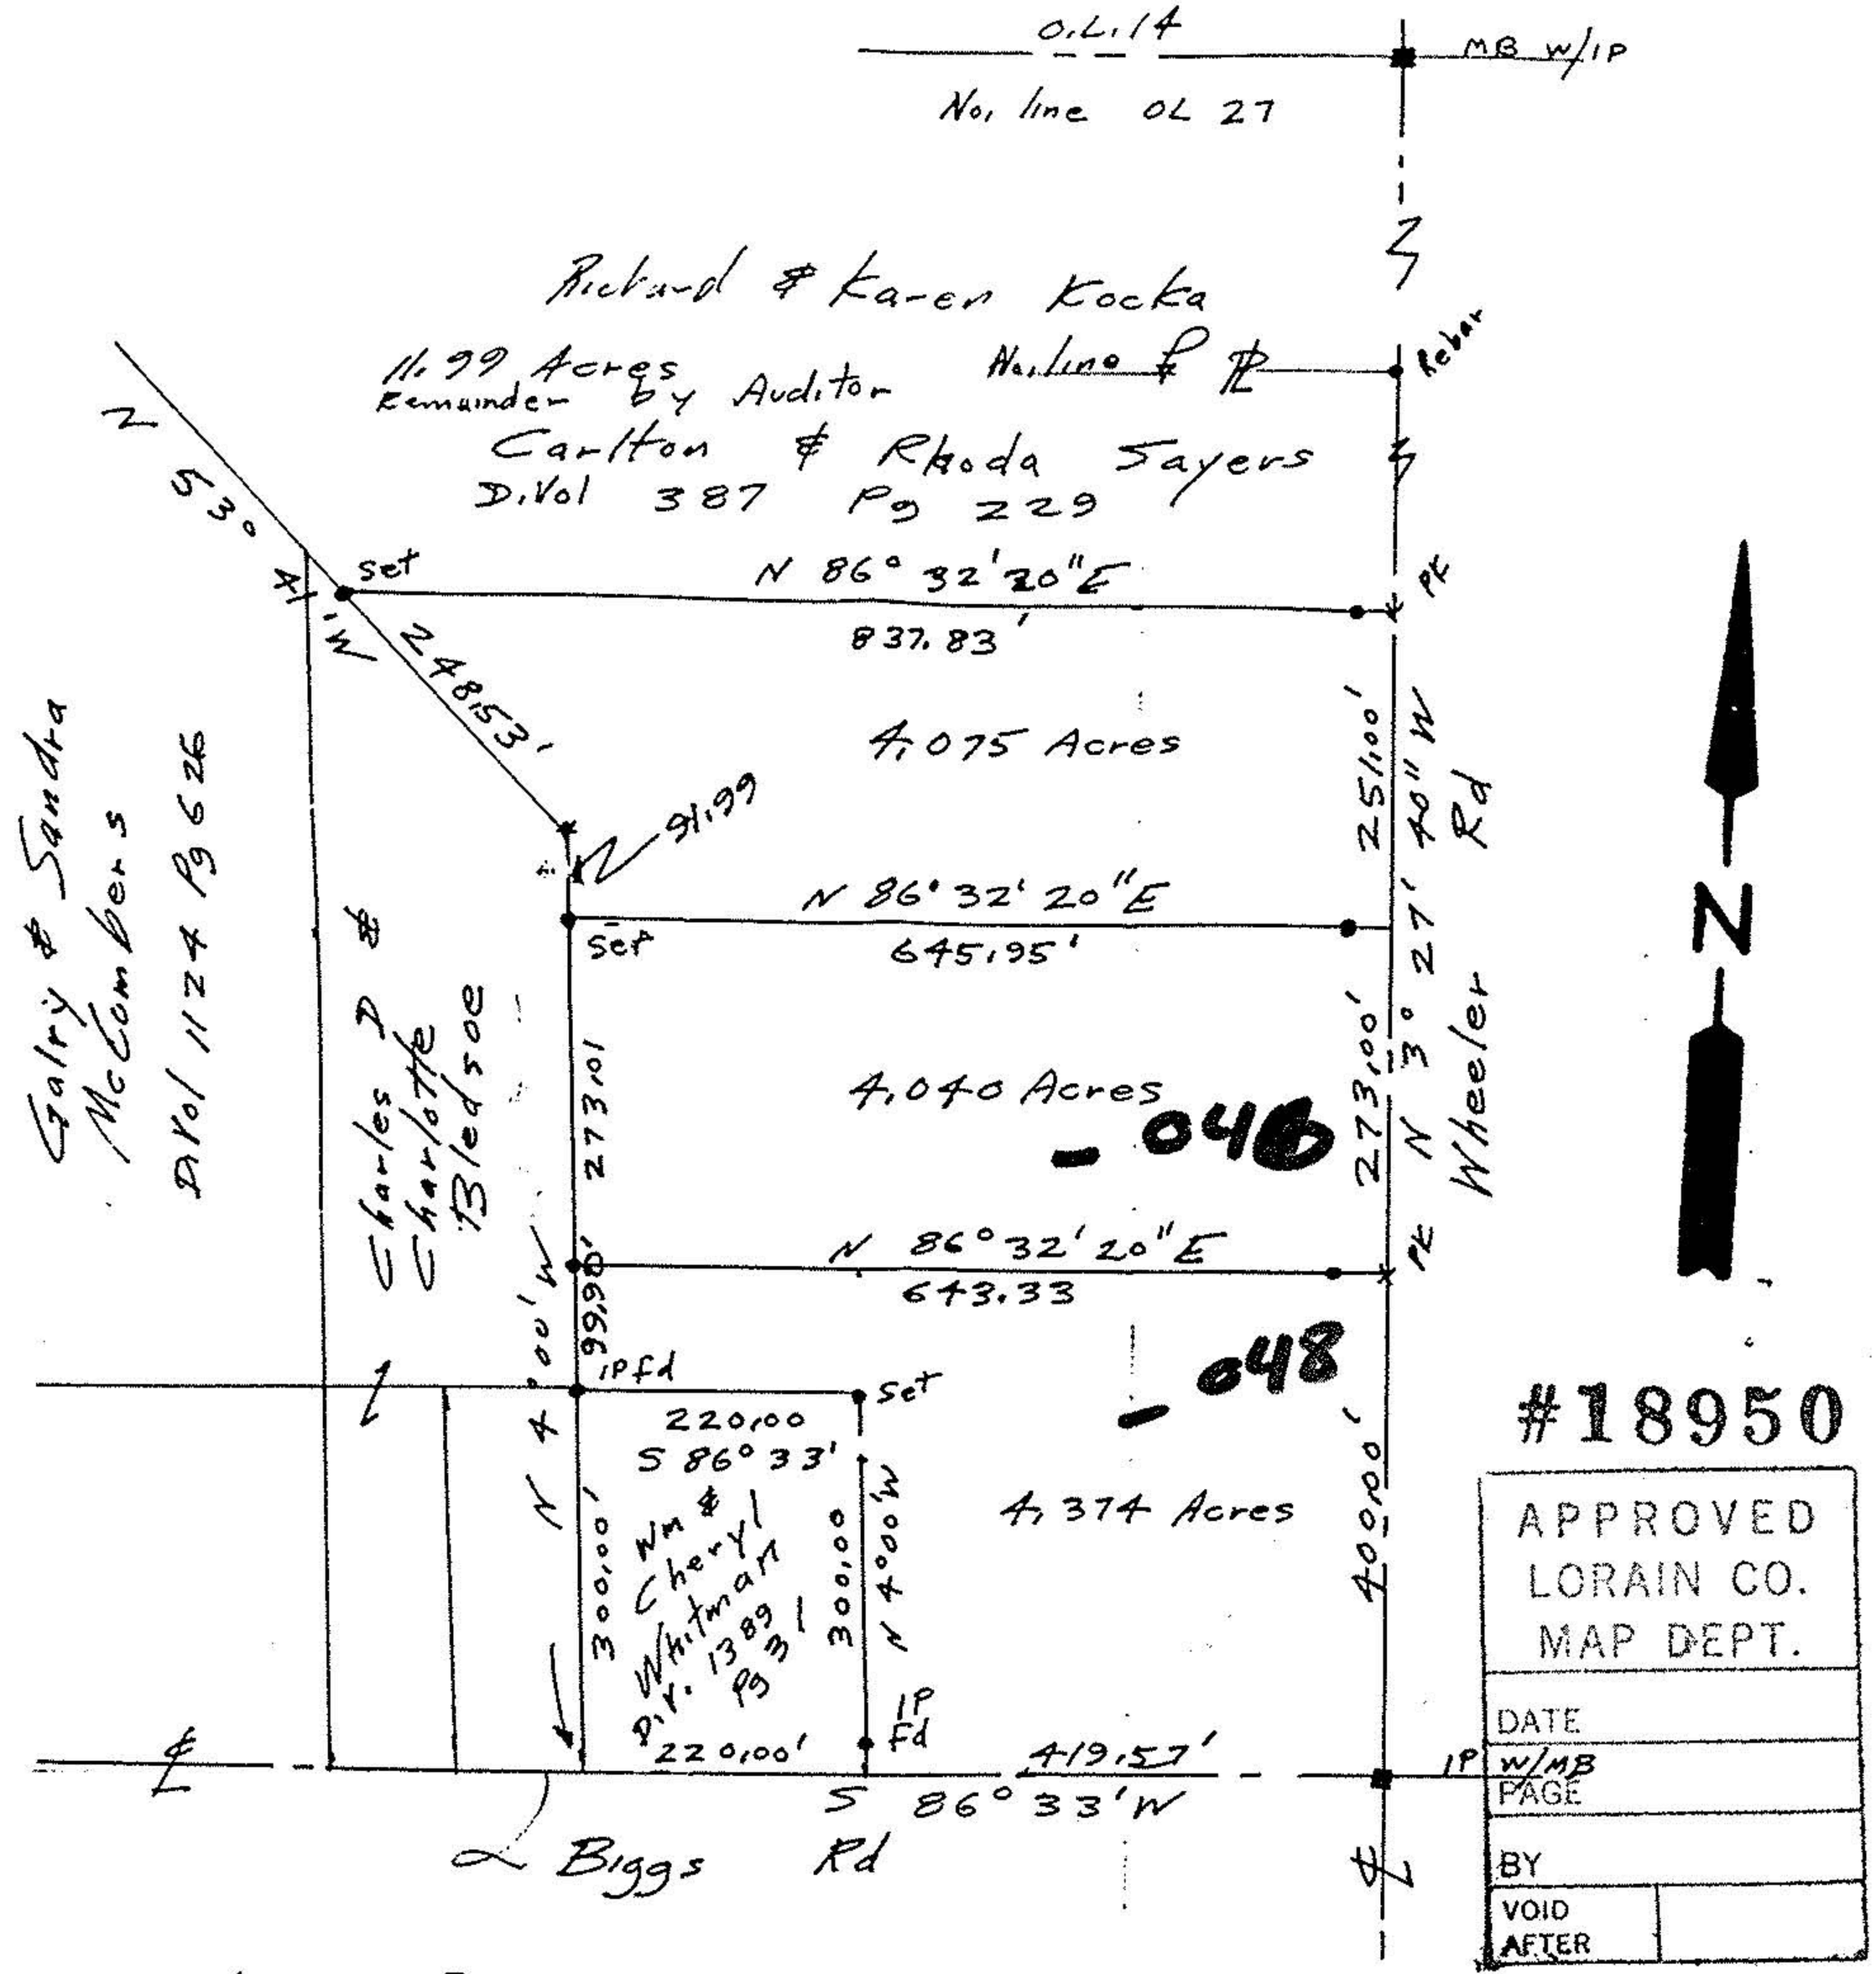

#18950

APPROVED LORAIN CO. MAP DEPT.	
DATE	
PAGE	
BY	
VOID AFTER	

- IP's set 30.0 from ℄ on Wheeler & Biggs Rd

John Pozywak
Reg Surveyor
5292

Survey of Parcel Splits
Carlton Sayers Property
Part of Original Lot 27
La Grange Township
Lorain County Ohio
Scale 1" = 200' Sept 5, 1989

0 200 400

15.00