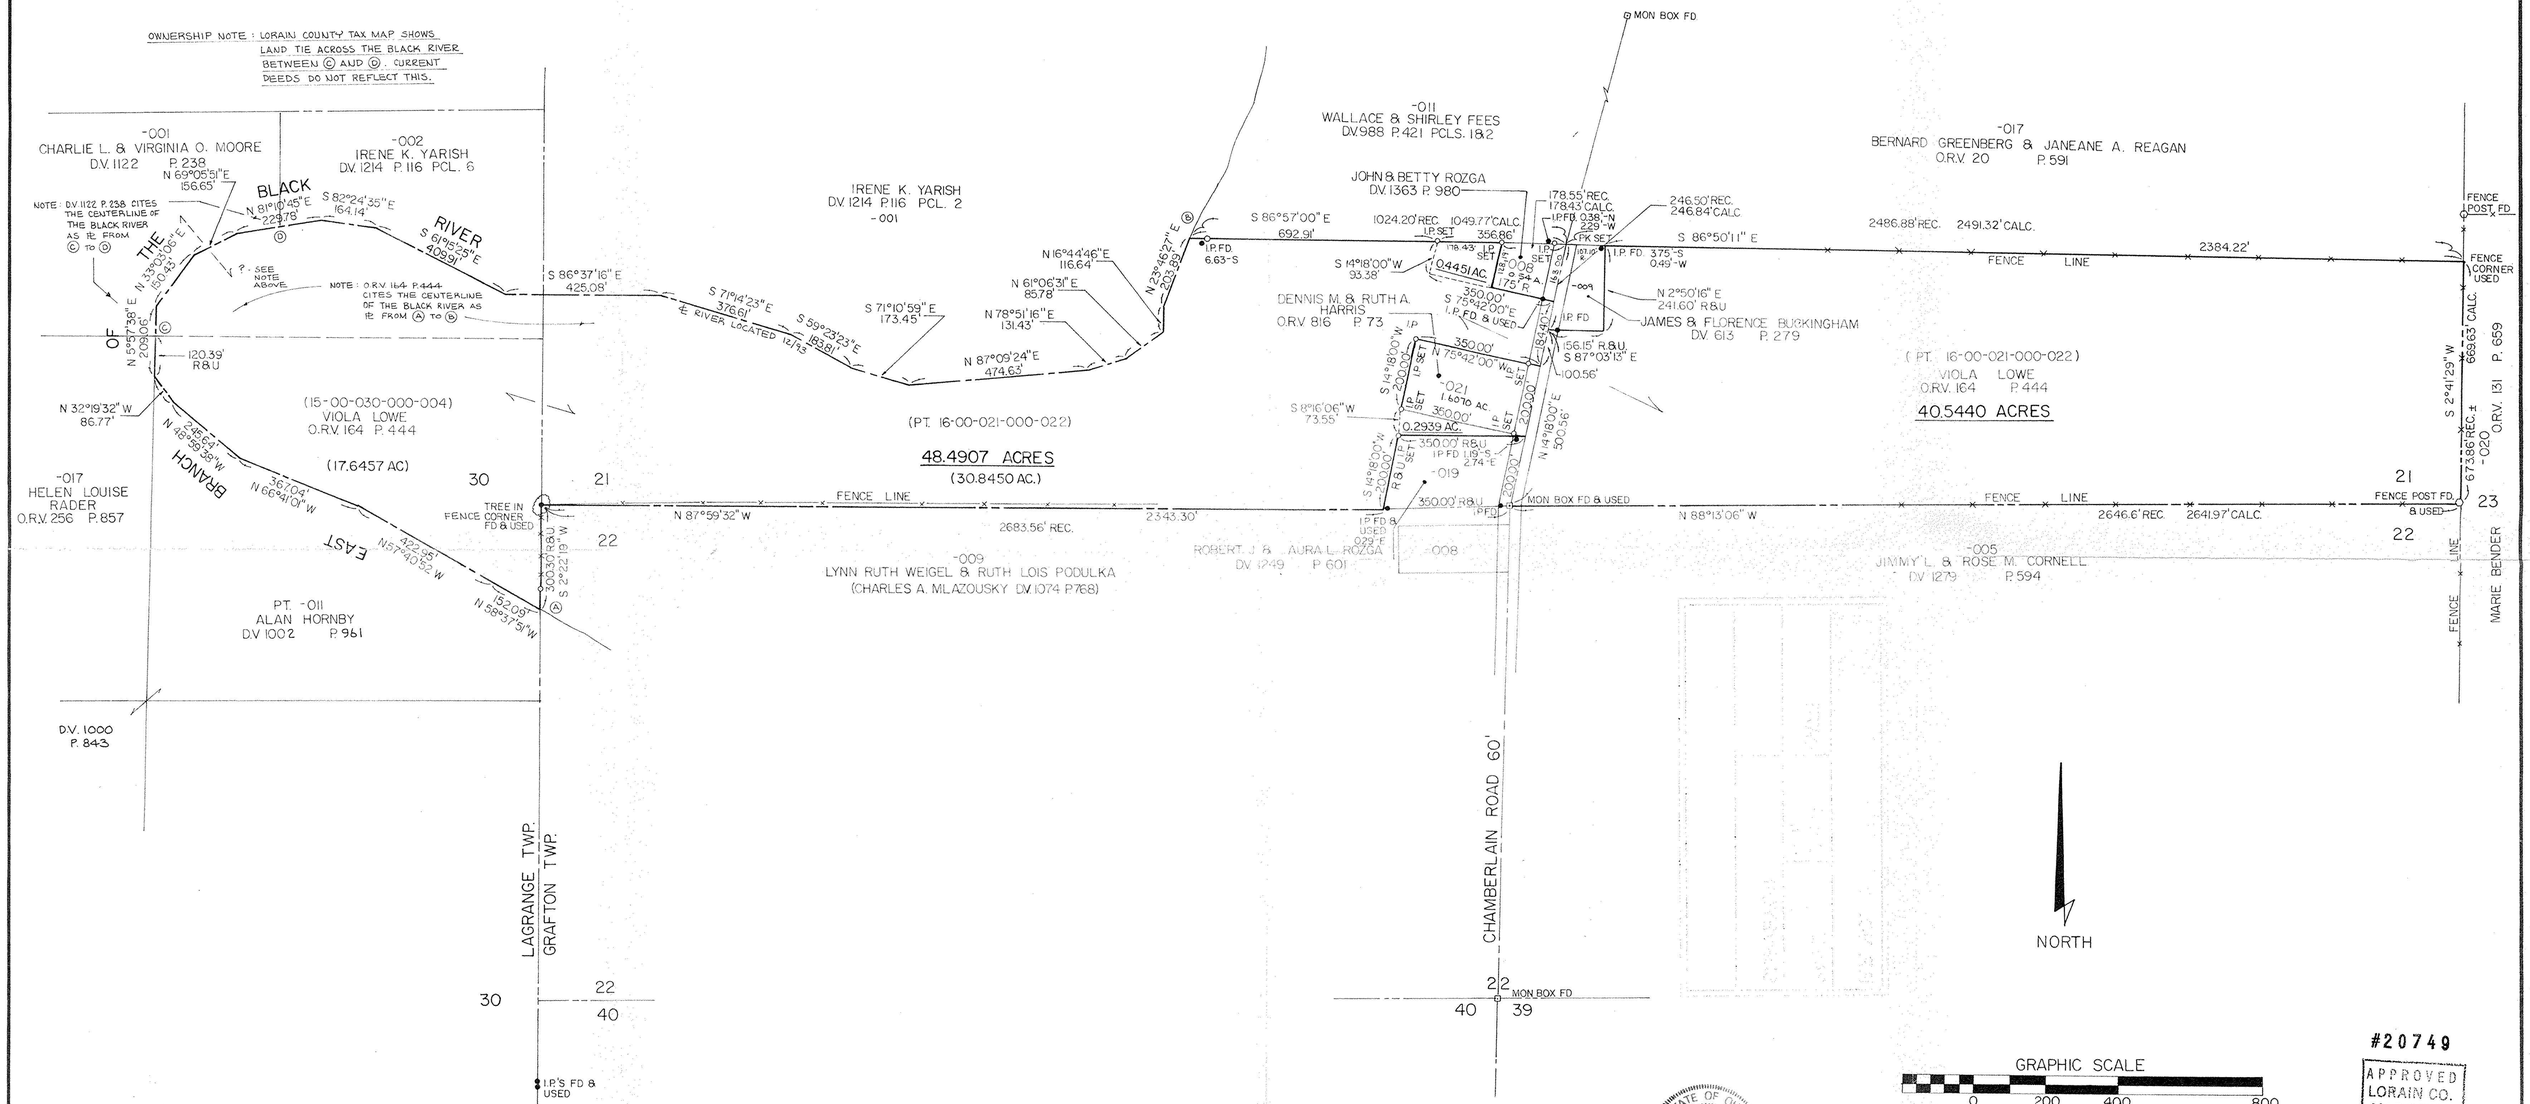

David L. Elwell
DAVID L. ELWELL
REG. SURVEYOR NO. 6333
01-24-94

STATE OF OHIO
DAVID L. ELWELL
6333
REGISTERED SURVEYOR

#20749

APPROVED
LORAIN CO.
MAP DEPT.
DATE 3-29-94
PAGE 15-D 16-A
BY T. McNair
VOID AFTER: 20749

REVISIONS

SURVEY MAP

PART OF ORIGINAL GRAFTON TOWNSHIP LOT NO. 21 &
PART OF ORIGINAL LAGRANGE TOWNSHIP LOT NO. 30
TOWNSHIP OF GRAFTON TOWNSHIP OF LAGRANGE
COUNTY OF LORAIN STATE OF OHIO
DECEMBER 21, 1993

KS ASSOCIATES, INC.
ENGINEERS/SURVEYORS
424 Middle Avenue
P.O. Box 89
Elyria, Ohio 44036
Elyria *(216) 322-6317* • **Lorain** *(216) 244-5757*

ENGINEERS/SURVEYORS KS ASSOCIATES INCORPORATED

SHEET 1 OF 1

JOB NO. 93-417