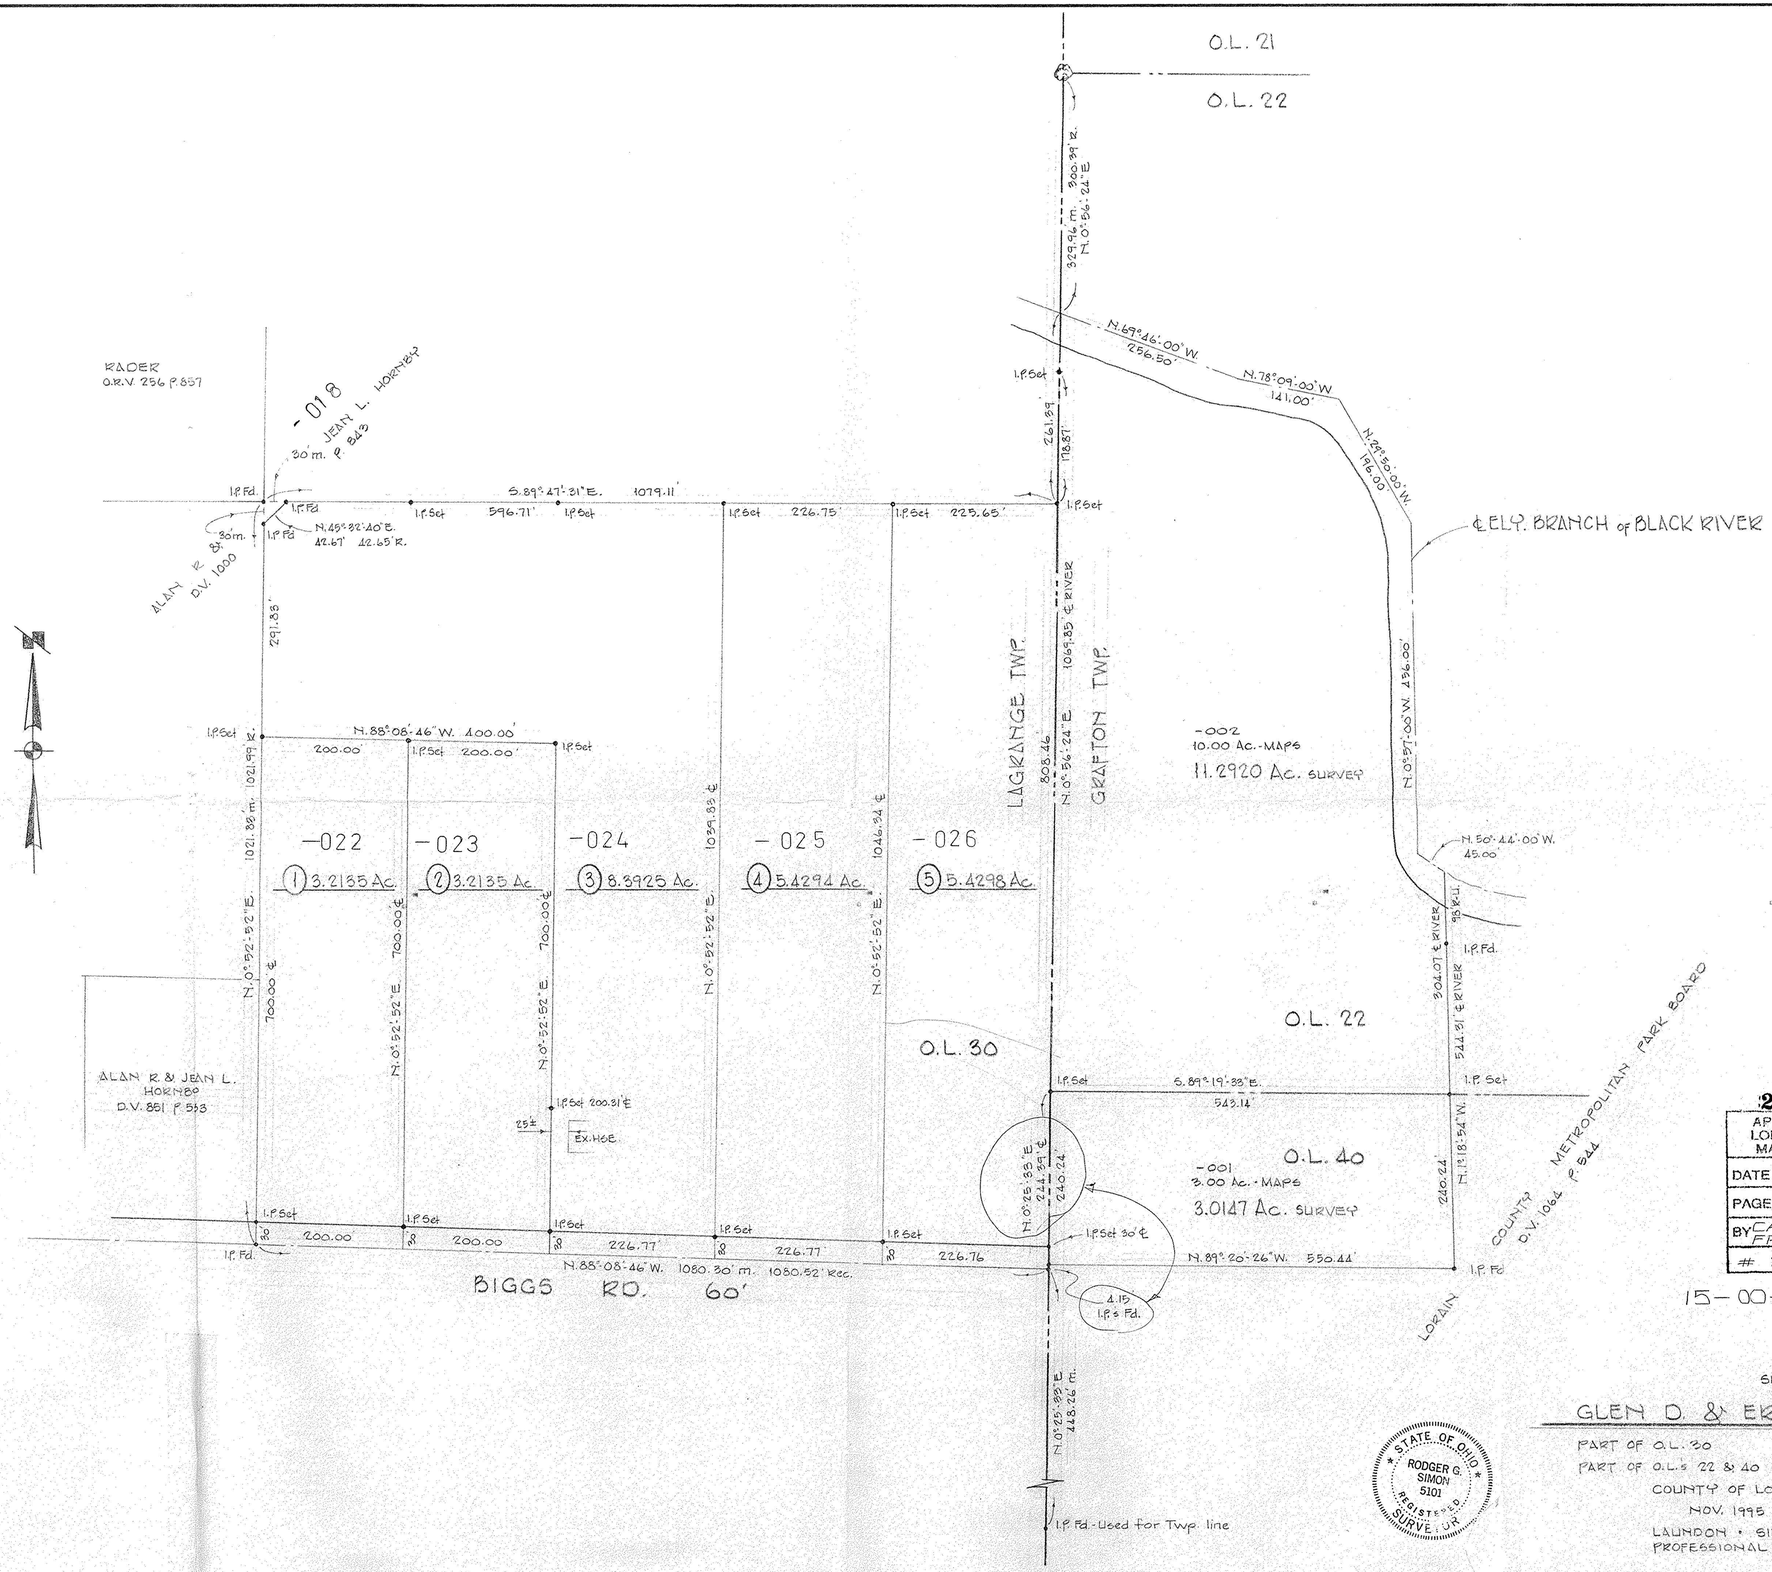

21648

APPROVED LORAIN CO. MAP DEPT
DATE 1-29-96
PAGE 15-D
BY CAROLYN FRANCIS
21648

15-00-030-000-025

SURVEY FOR

GLEN D. & ERIC D. HOVATTER

PART OF O.L. 30 — TOWNSHIP OF LAGRANGE
PART OF O.L.'s 22 & 40 — TOWNSHIP OF GRAFTON
COUNTY OF LORAIN — STATE OF OHIO
NOV. 1995 — SCALE 1" = 100'

LAUNDON • SIMON • CAHL & ASSOC.
PROFESSIONAL LAND SURVEYORS

95-2779 — FB. 238 P. 1,2+3