


NOTE: ● indicates iron pin set December of 1975 or March of 1977 unless otherwise designated.

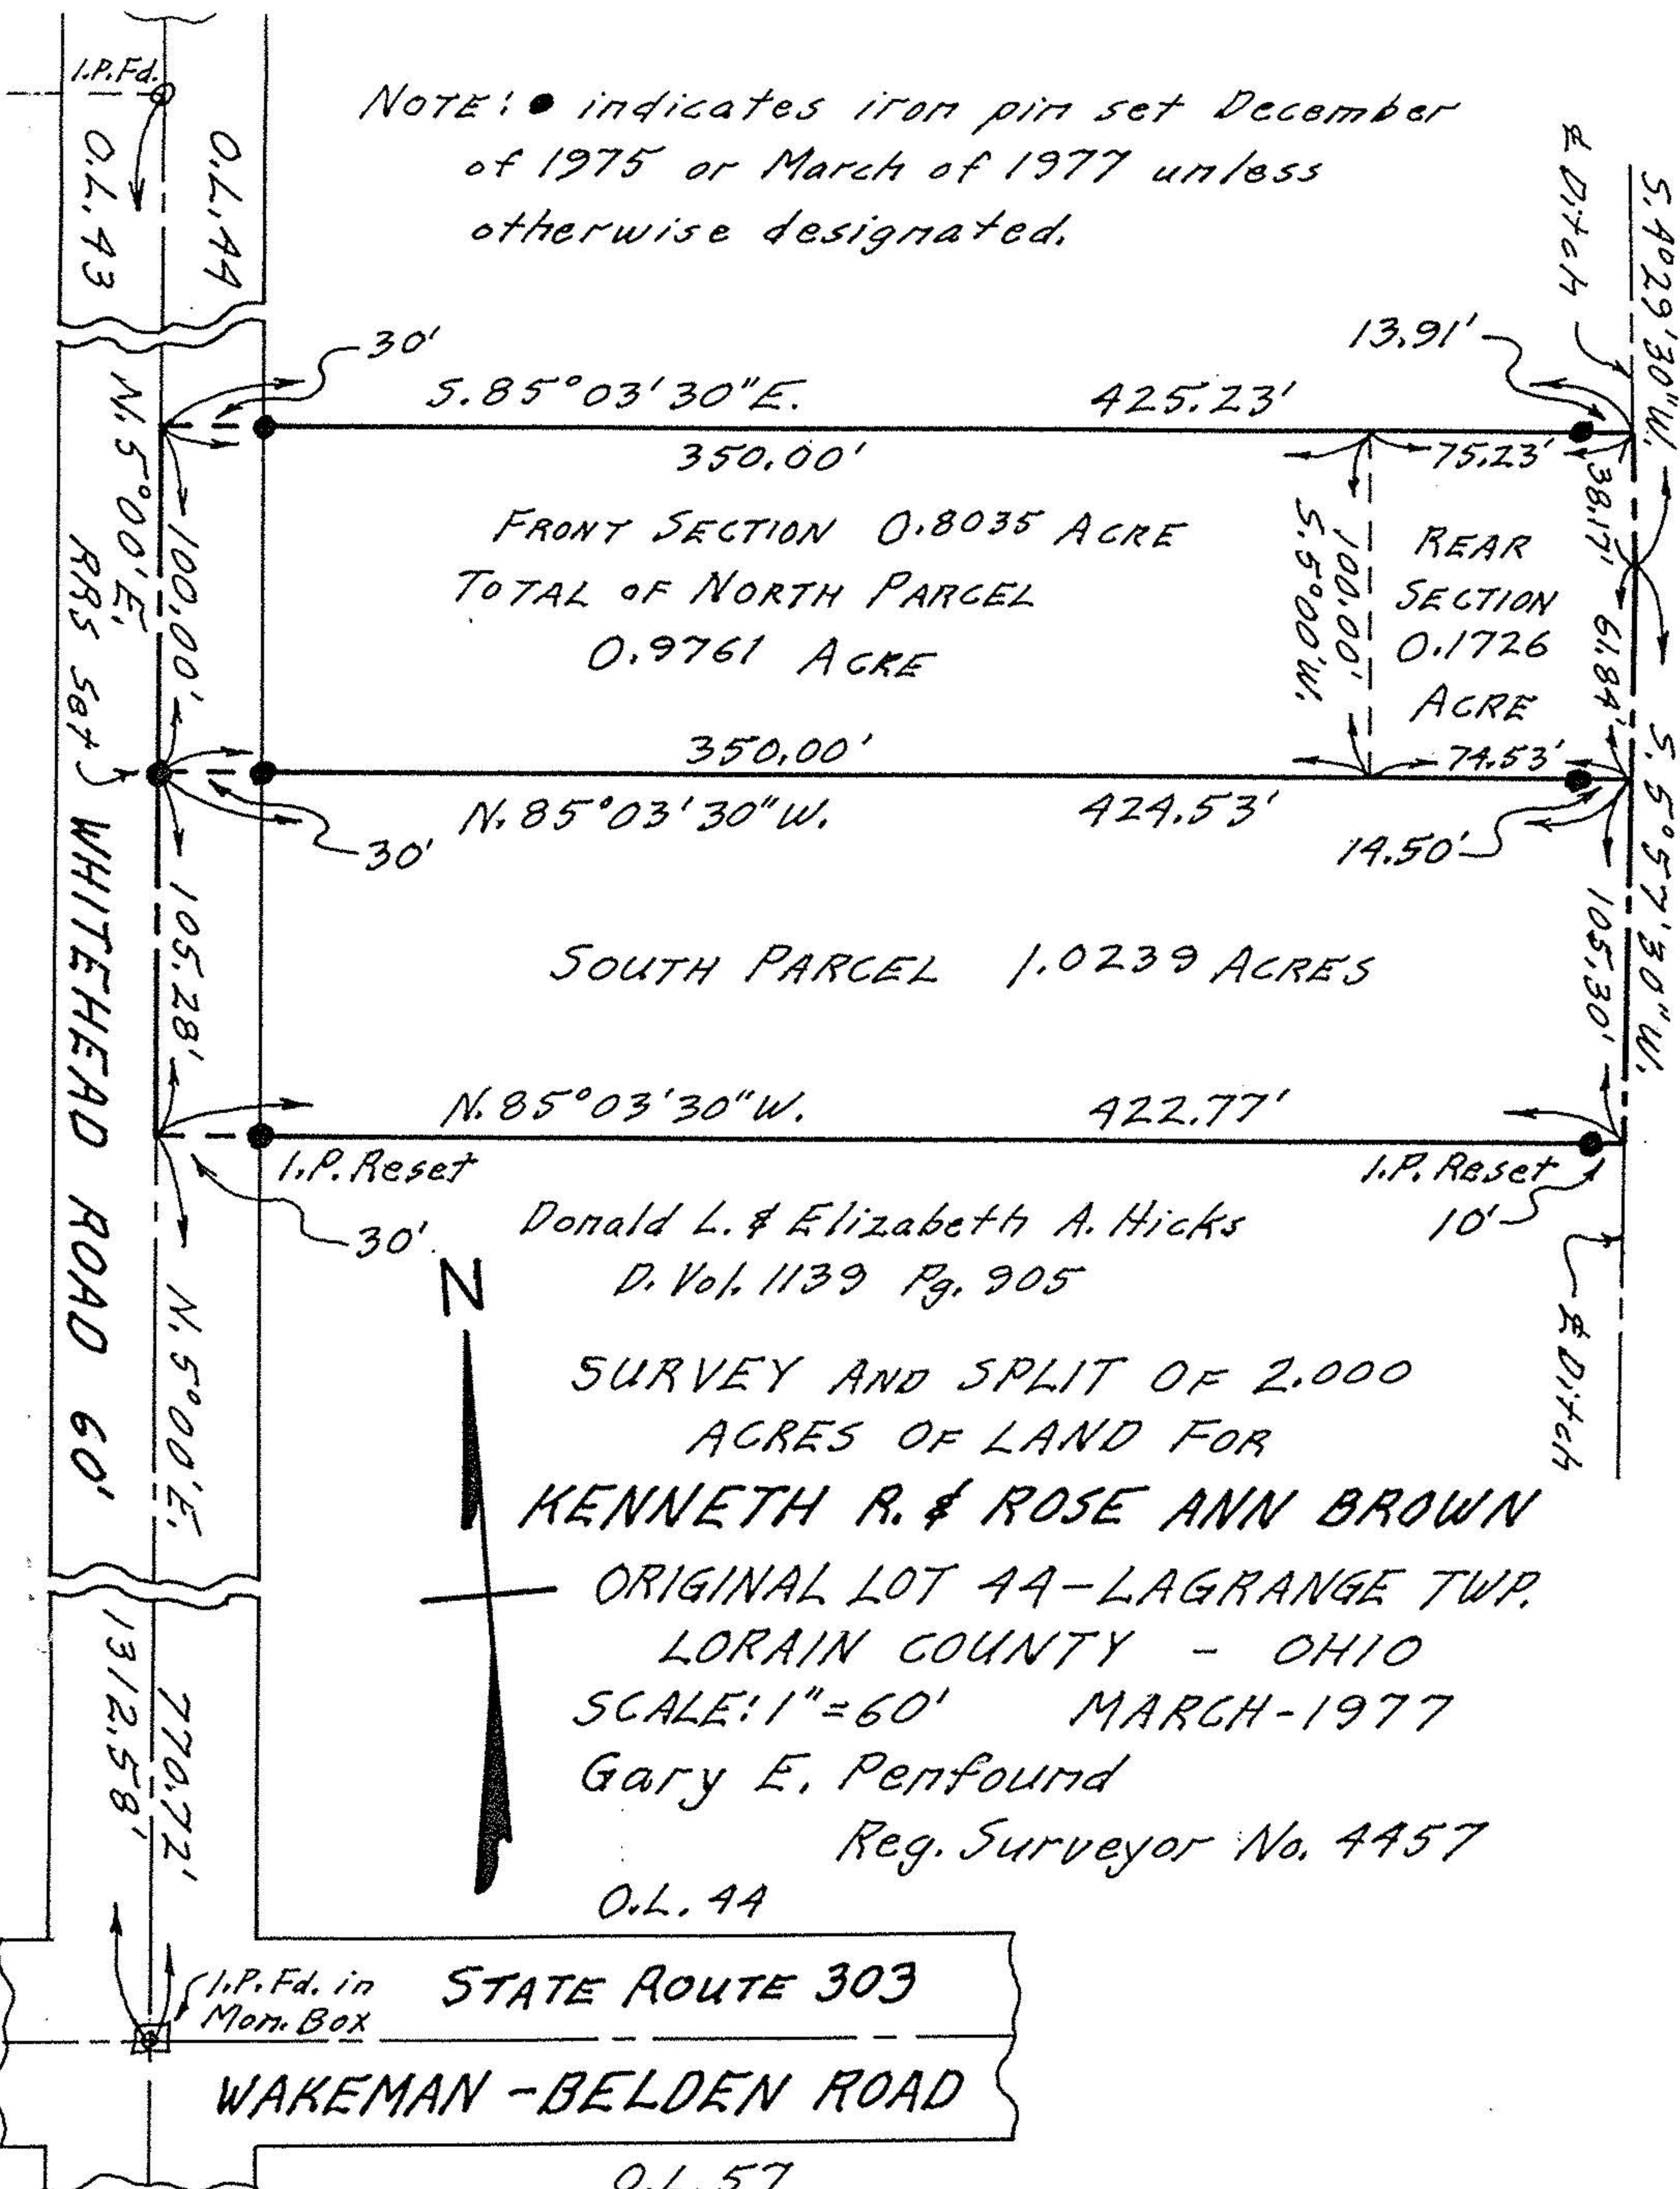

STATE ROUTE 303
WAKEMAN-BELDEN ROAD

O.L. 57