

PLAT OF SURVEYS FOR
GLEN BUSWELL

PARTS OF SUB-LOTS NOS. 2 & 3


VILLAGE PLAT OF LAGRANGE Vol. 1 Pg. 4

ORIG. LOT NO. 46 LAGRANGE TWP.

LAGRANGE VILLAGE - LORAIN CO. - OHIO

SCALE: 1" = 50' JUNE 1967

NOTE: ● indicates iron
pit set unless
otherwise designated.
X indicates cross cut.

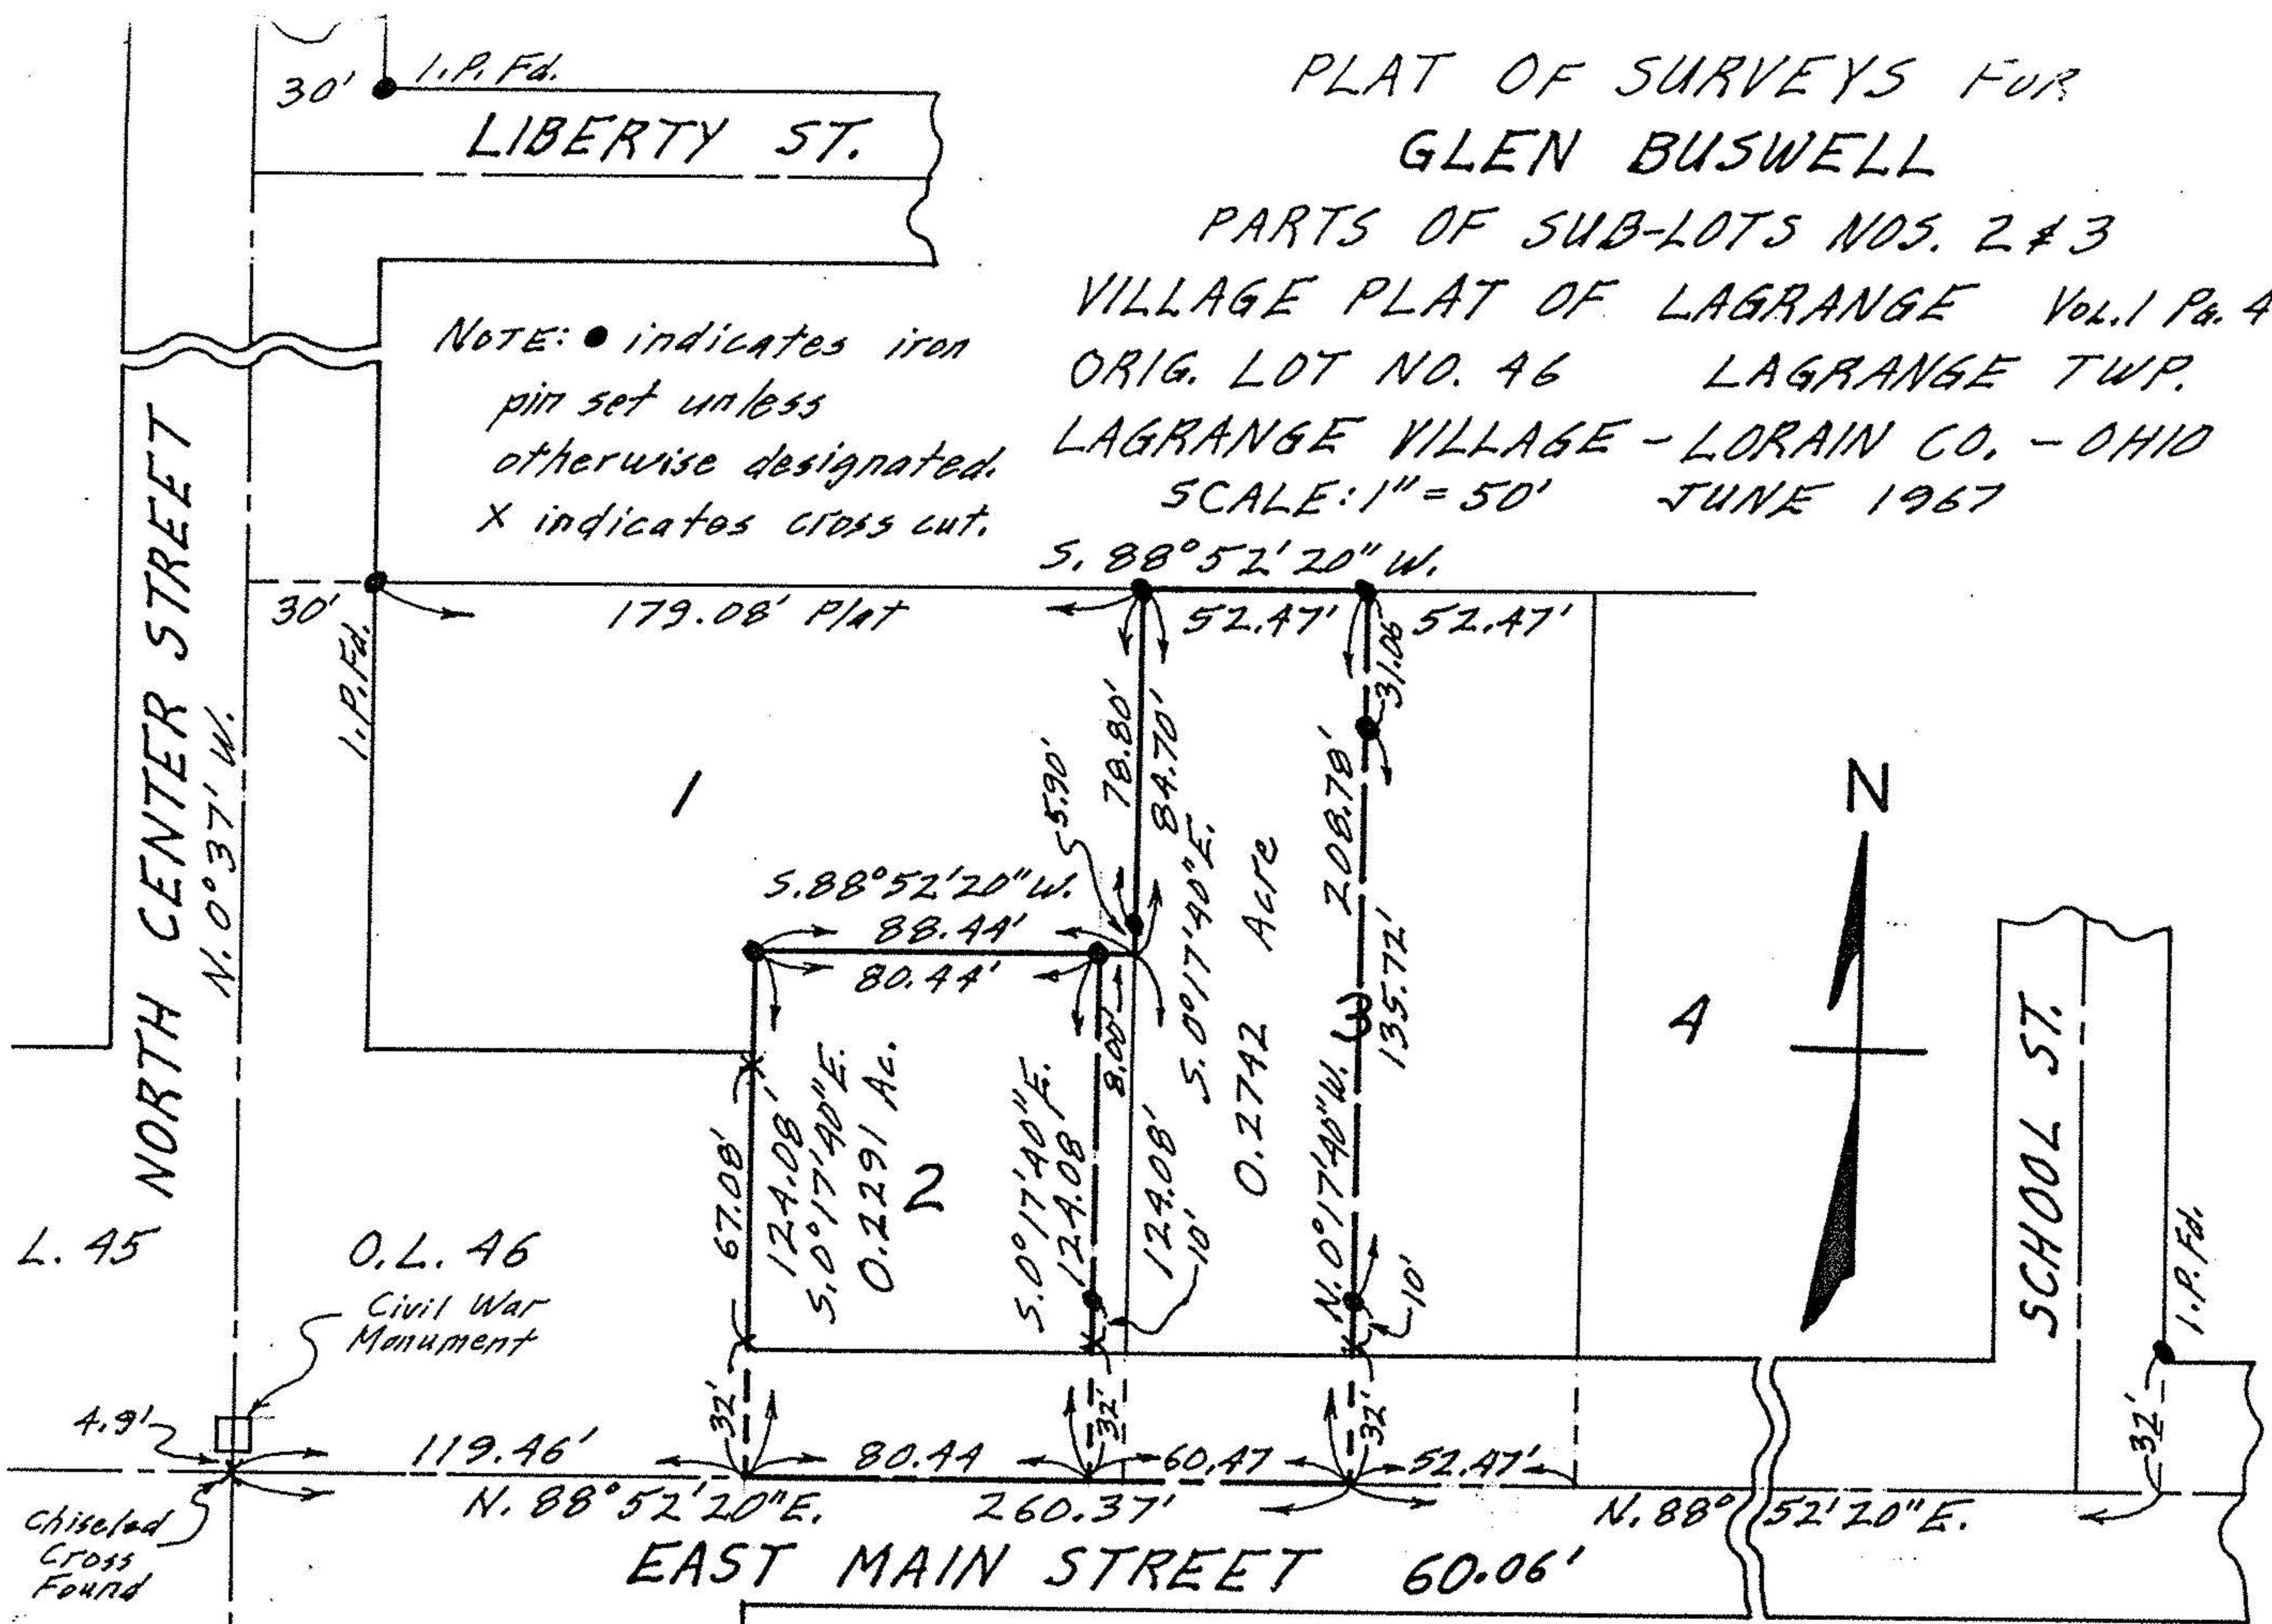

Gary E. Penfound REG. SURVEYOR NO. 4457