PLAT OF SURVEY FOR NELSON E. REISINGER
PART OF LANDS OF LESLIE KNOWLES
ORIGINAL LOT 52 LAGRANGE TOWNSHIP
LORAIN COUNTY - OHIO

SCALE: 1" = 60' JUNE 21, 1956

C.E. Penfound Registered Surveyor

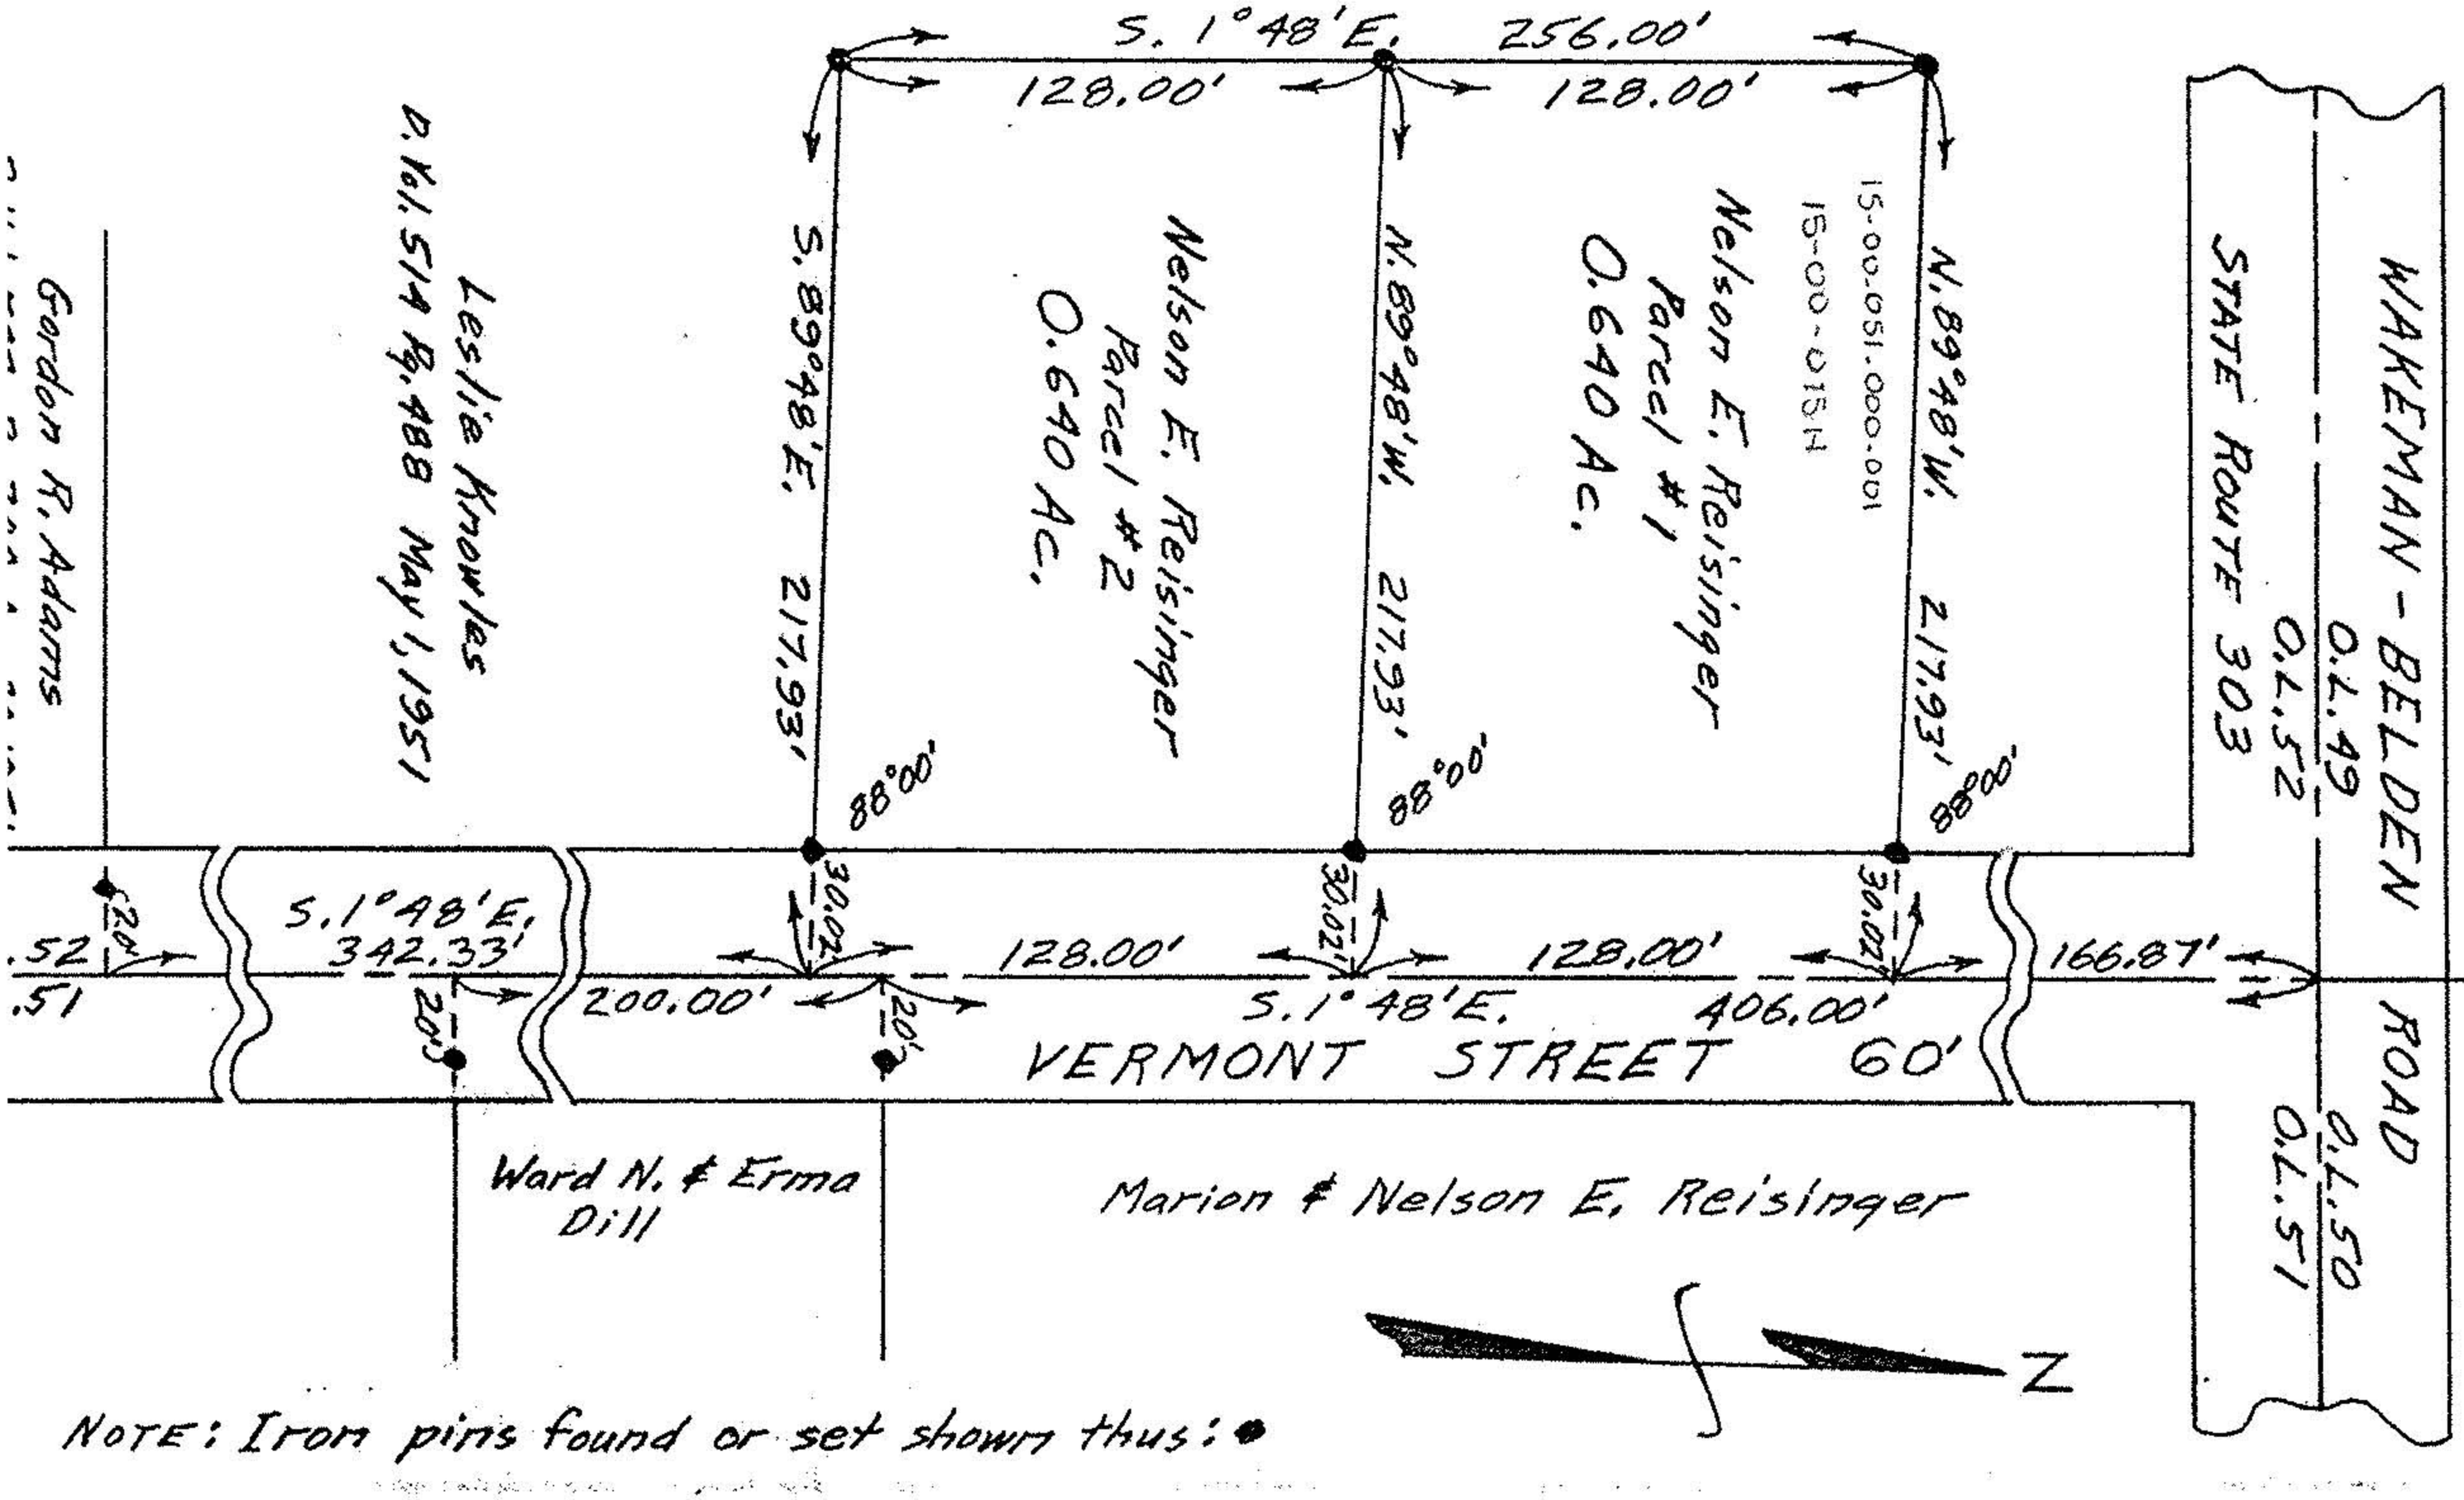

NOTE: Iron pins found or set shown thus: ●