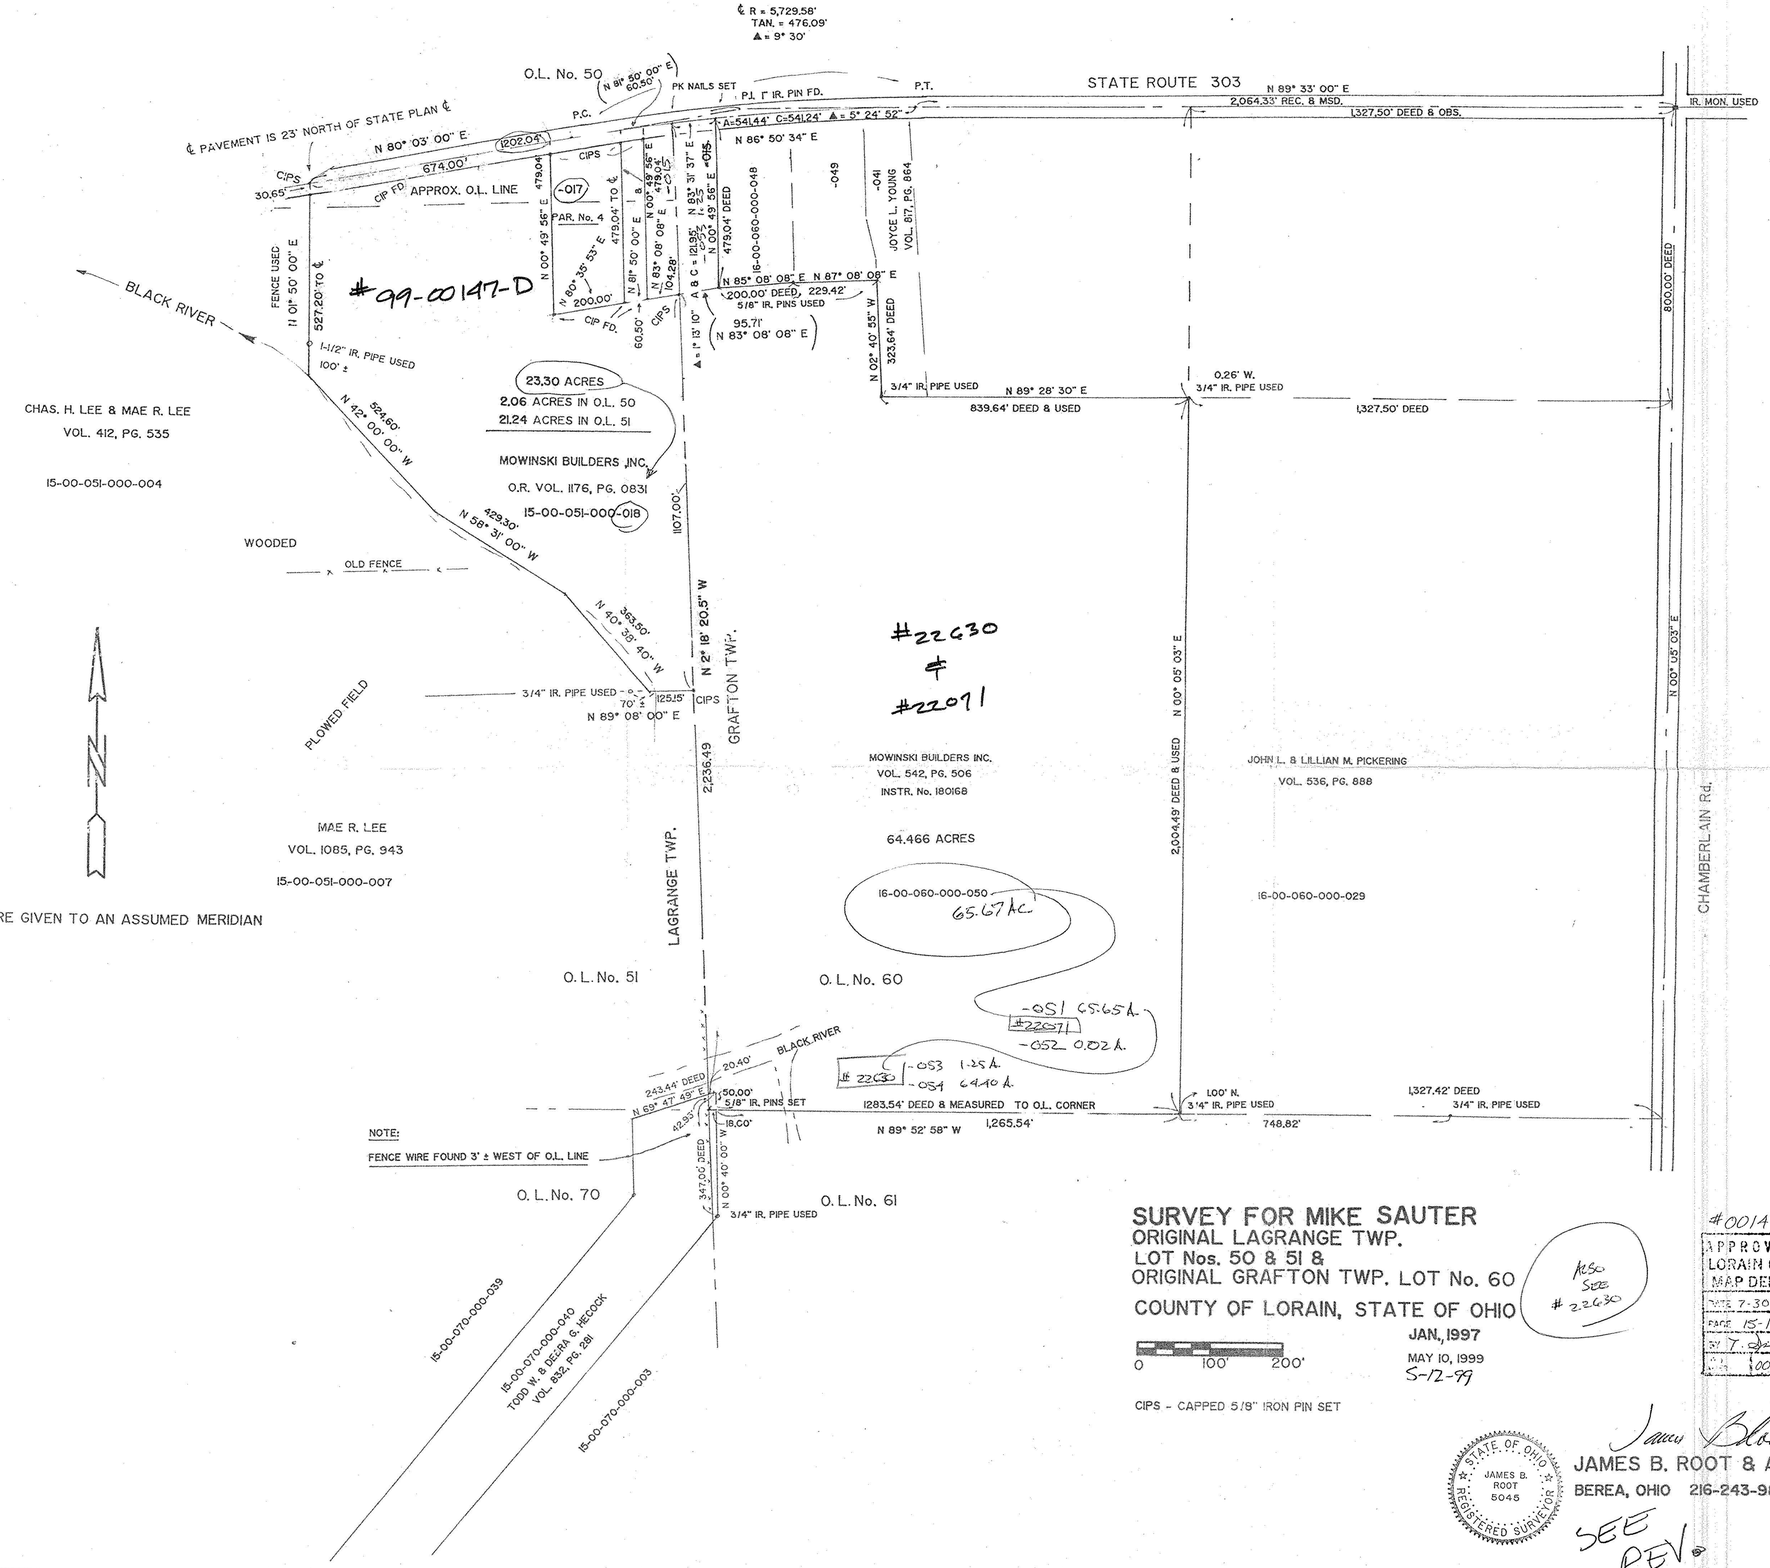

SURVEY FOR MIKE SAUTER
ORIGINAL LAGRANGE TWP.
LOT Nos. 50 & 51 &
ORIGINAL GRAFTON TWP. LOT No. 60
COUNTY OF LORAIN, STATE OF OHIO

JAN., 1997
MAY 10, 1999
5-12-99

Also See #22630

#00147-D
APPROVED
LORAIN CO.
MAP DEPT.
DATE 7-30-99
PAGE 15-11 & 16-E
BY T. Seal
#00147-D

James B. Root
JAMES B. ROOT & ASSOCS.
BEREA, OHIO 216-243-9843

SEE REV.