


15-00-055-101-20416

Main St SR 303

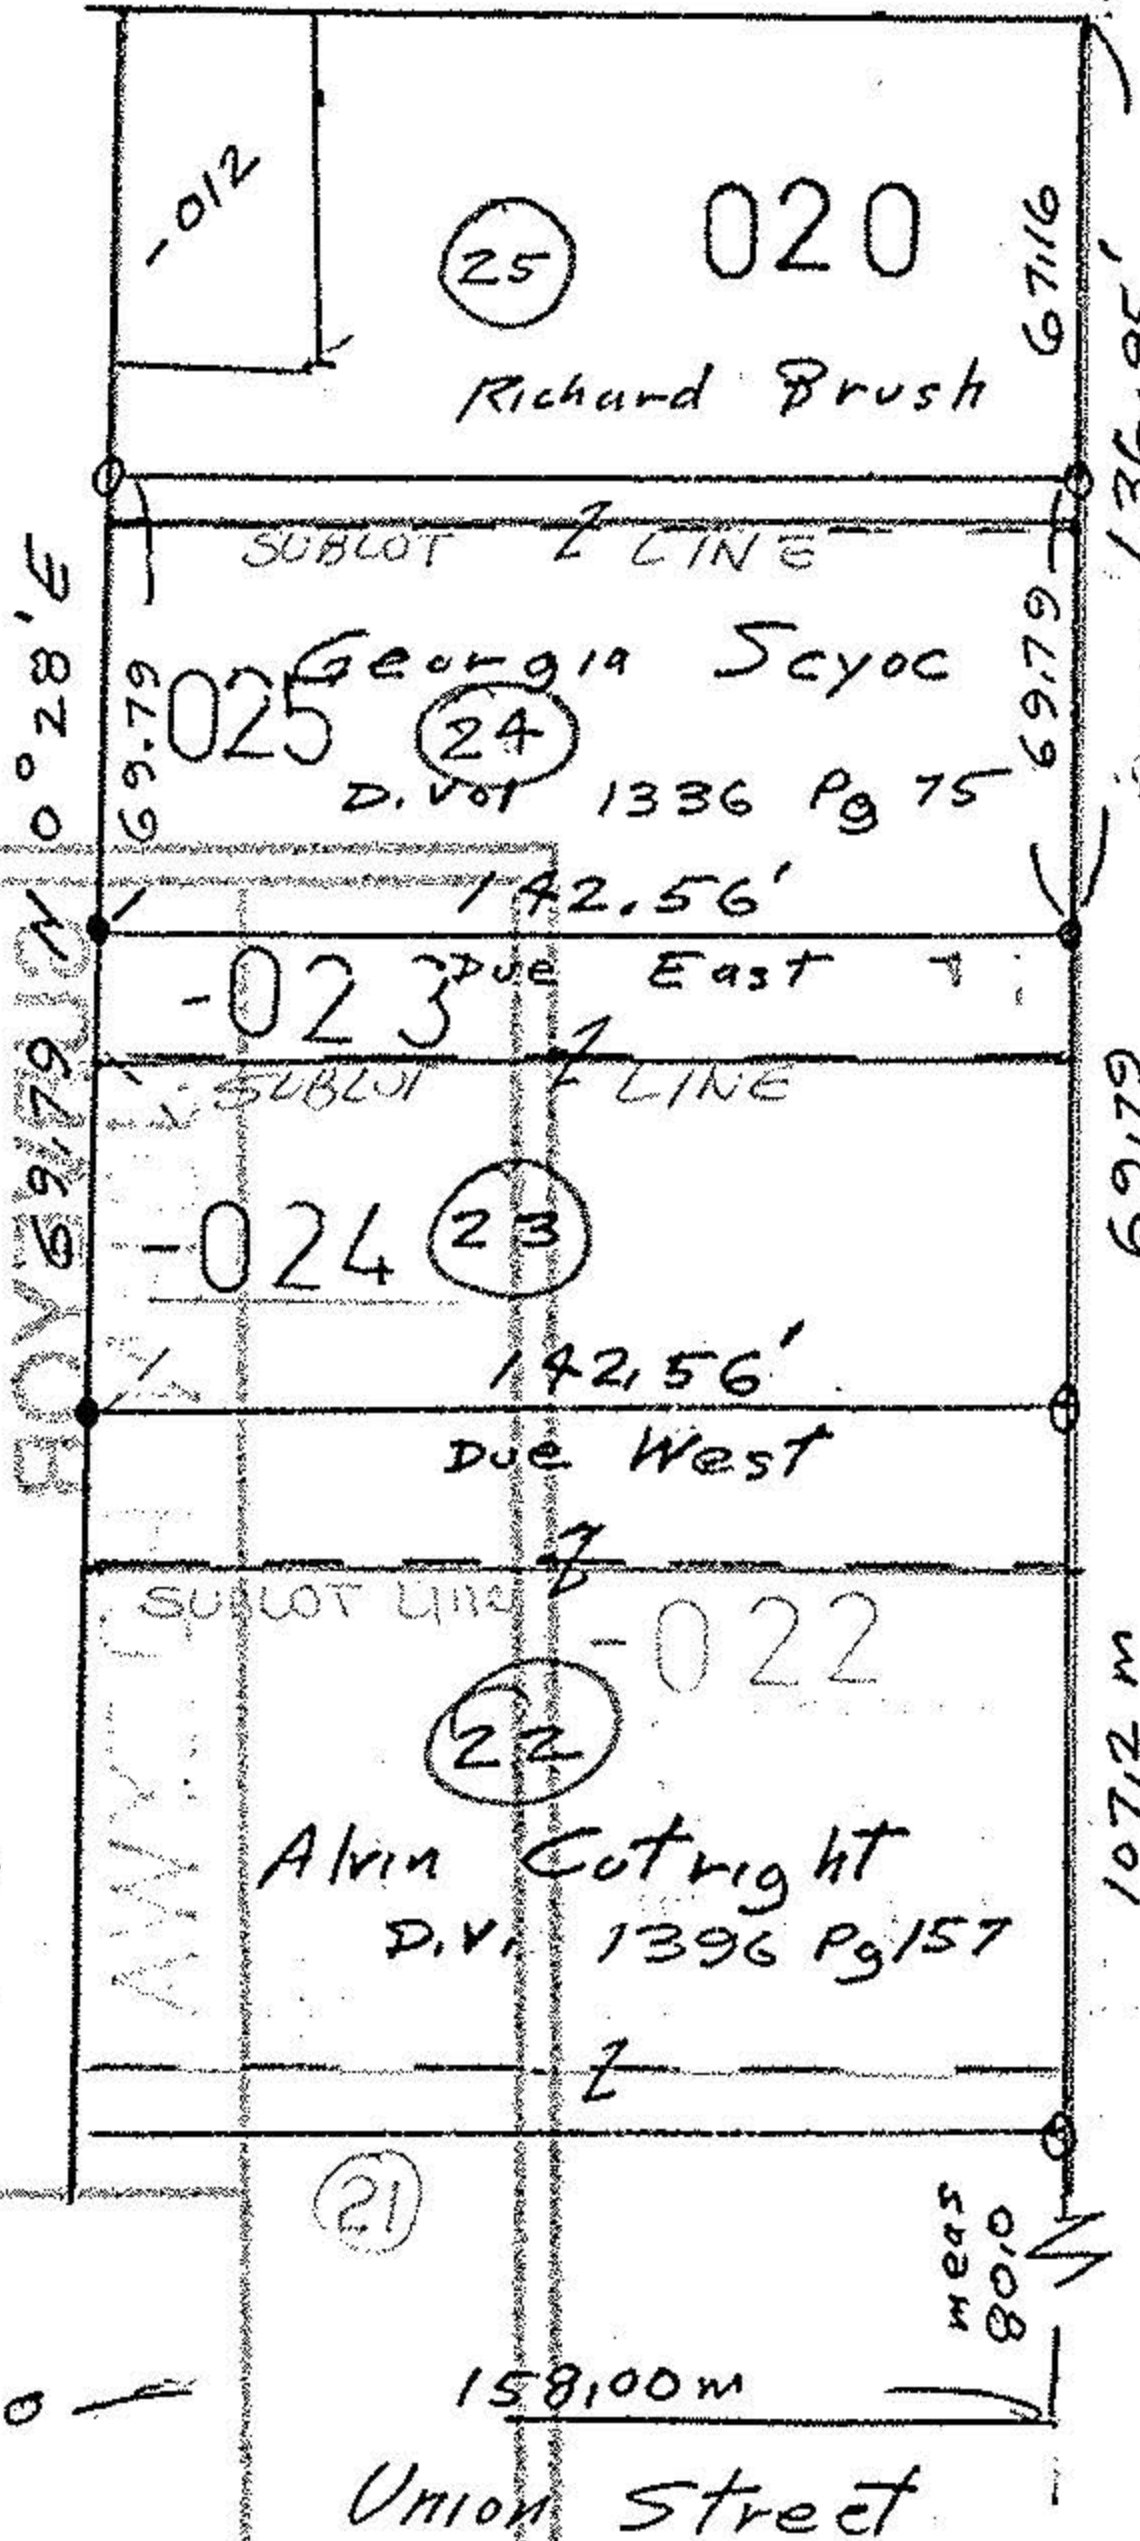

20416
 APPROVED
 LORAIN CO.
 MAP DEPT.
 DATE 7-2-93
 PAGE 15-00-055-A
 BY CAROLYN FRANCES
 VOID AFTER # 20416

Survey of
 Part sublots 24 & 23
 La Grange Village Plat
 Plat Vol. 1 Pg 4
 Plat Vol 2 Pg 24

John Pozzywak
 Reg. Surveyor
 5292

ORIGINAL LOT 55 DATE May 1993
 TOWNSHIP La Grange SCALE 1" = 60'
 CITY OF La Grange Village FIELD BOOK N/A
 COUNTY OF Lorain DRAWN BY _____
 STATE OF OHIO CHECKED BY _____
 W. O. _____ FILE NO. 15-00-055-101

STATE OF OHIO
 JOHN POZYWAK
 5292
 REGISTERED
 SURVEYOR

LEGAL NOTICE
 PAGE 15-00-055-A
 DATED 7-2-93

Iron pipes fd
 Iron pipes set
 original subplot lines