15-00-055-A

~~1760~~
17793-A

15-00-055-102

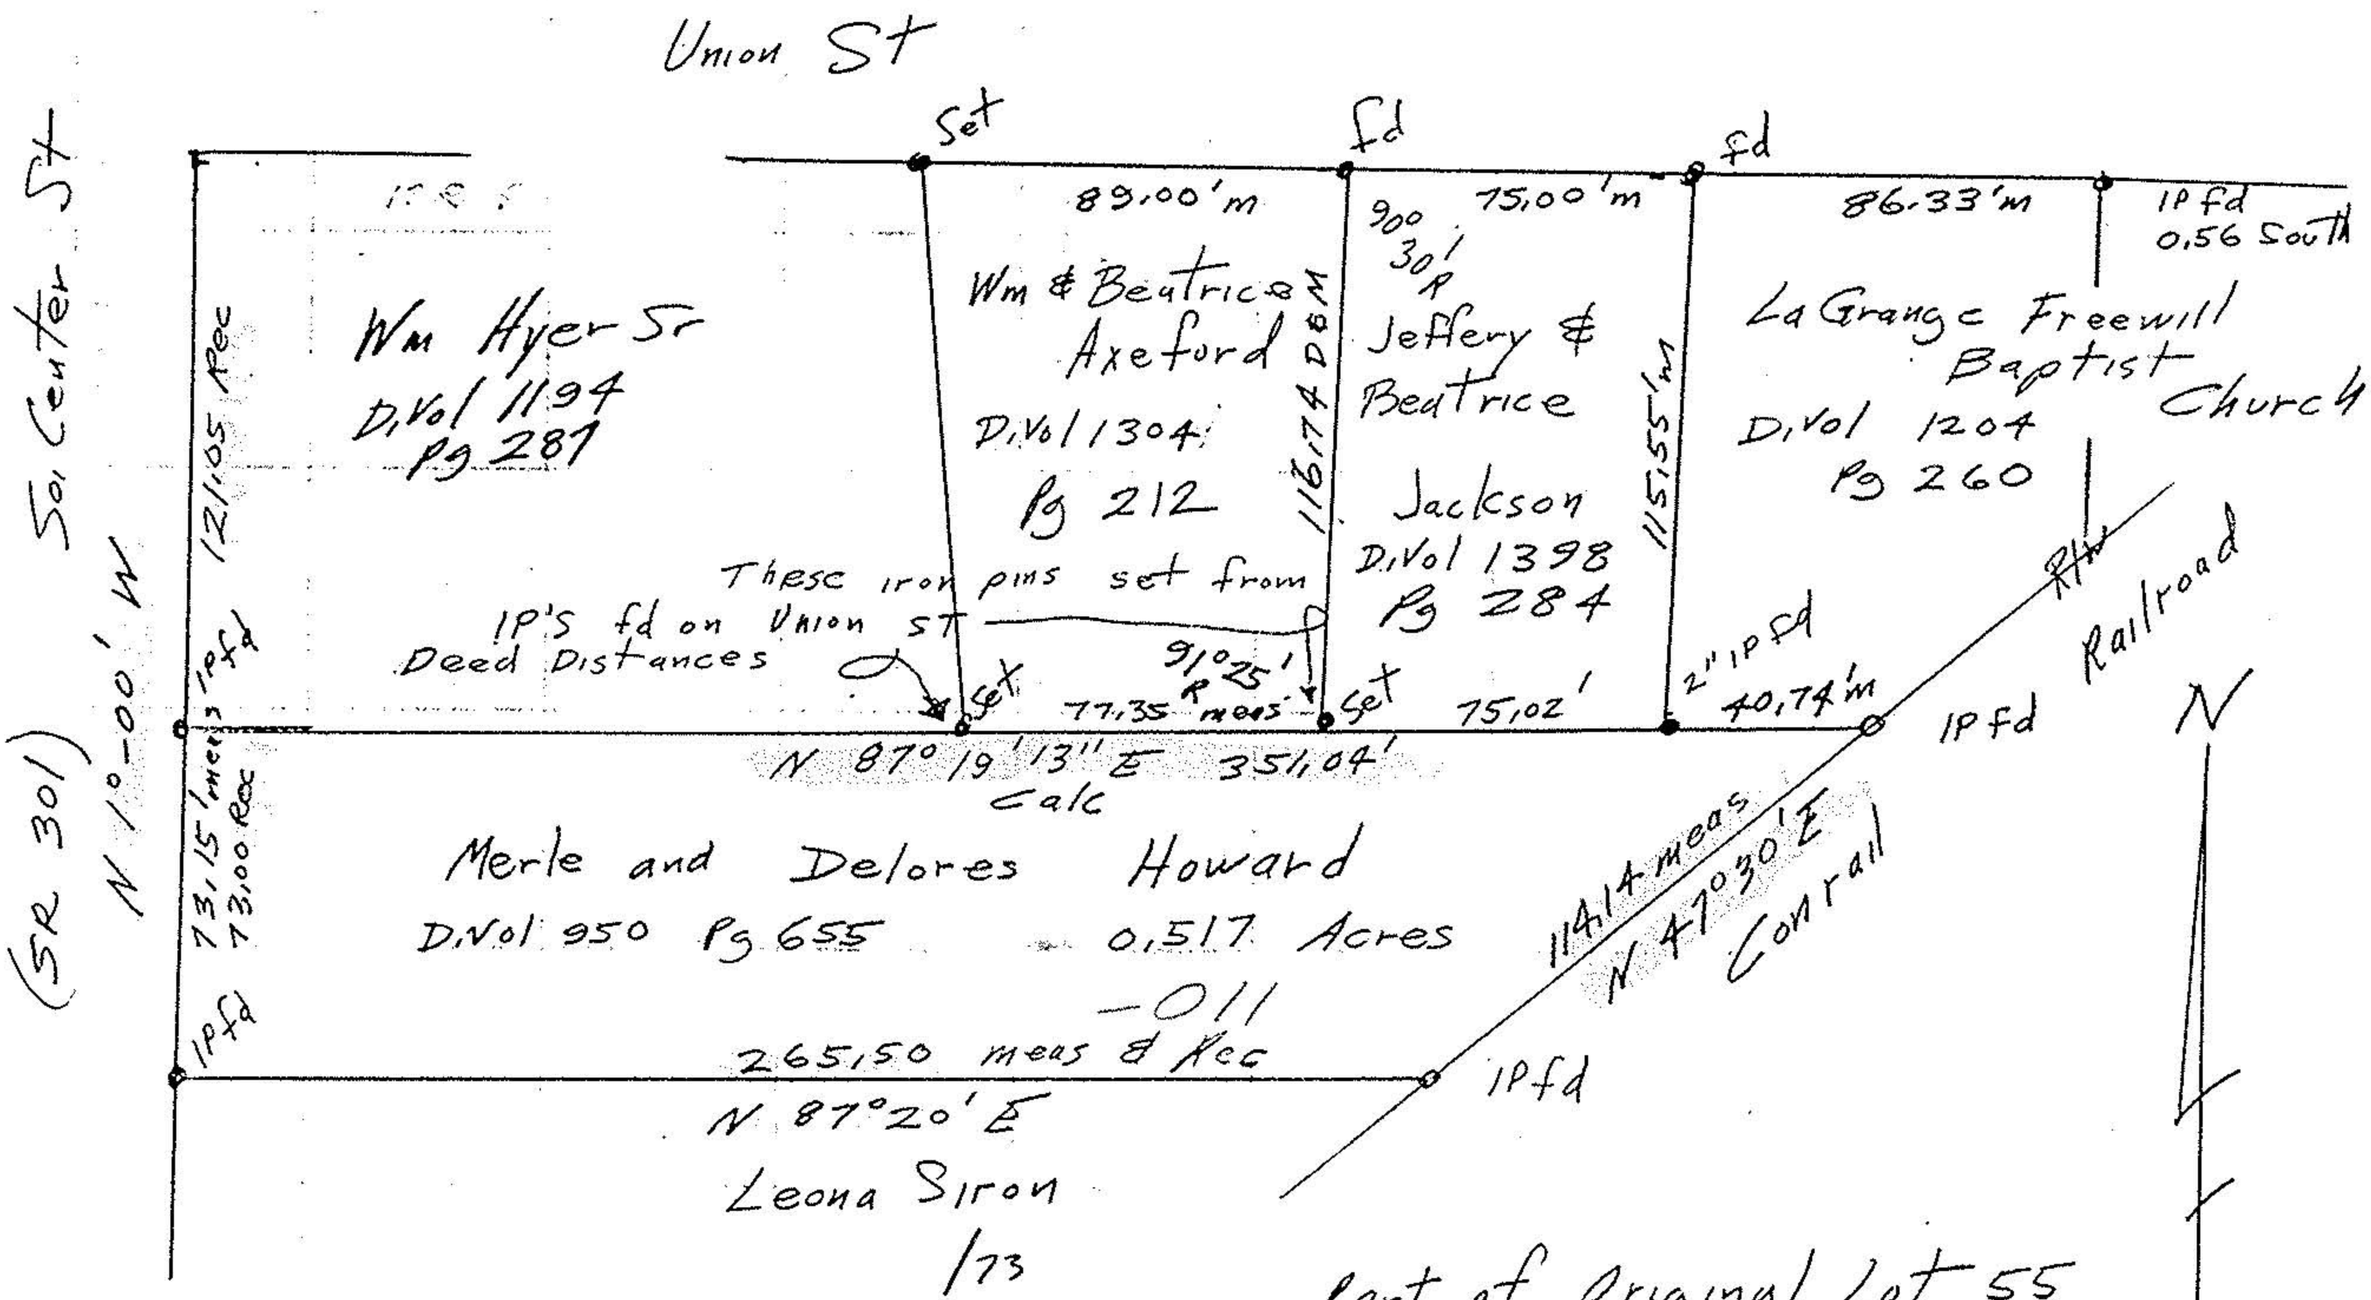

John Pozywal
Reg Surveyor 5292

Part of Original Lot 55
LaGrange Township
Lorain County, Ohio
Scale 1" = 50' June 1987

for sublots division See Tax Map 15-00-05