
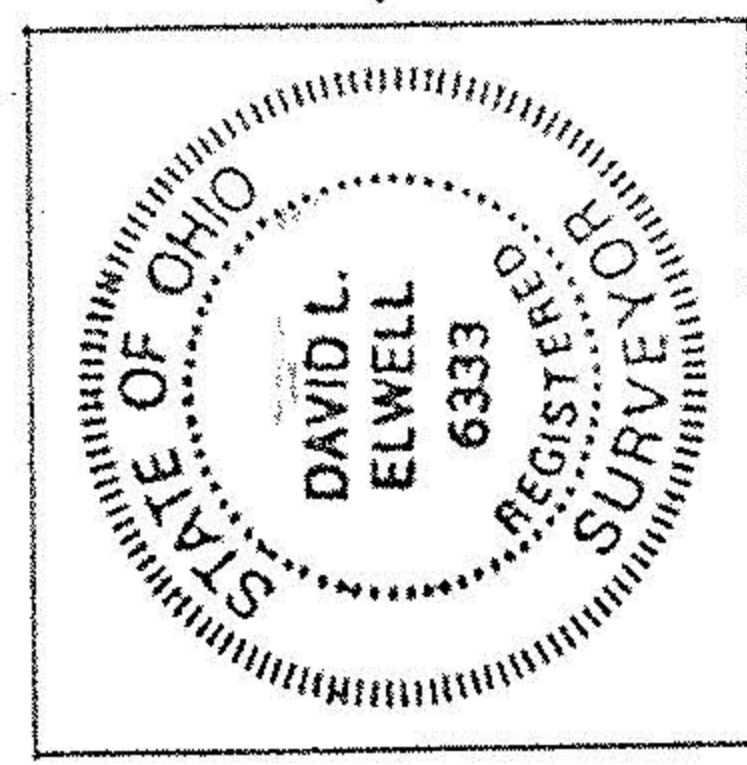


MAP OF PROPERTY SURVEY

PART OF
ORIGINAL GRAFTON TOWNSHIP LOT NO 91
COUNTY OF LORAIN - STATE OF OHIO

NORTH
SCALE 1" = 50'

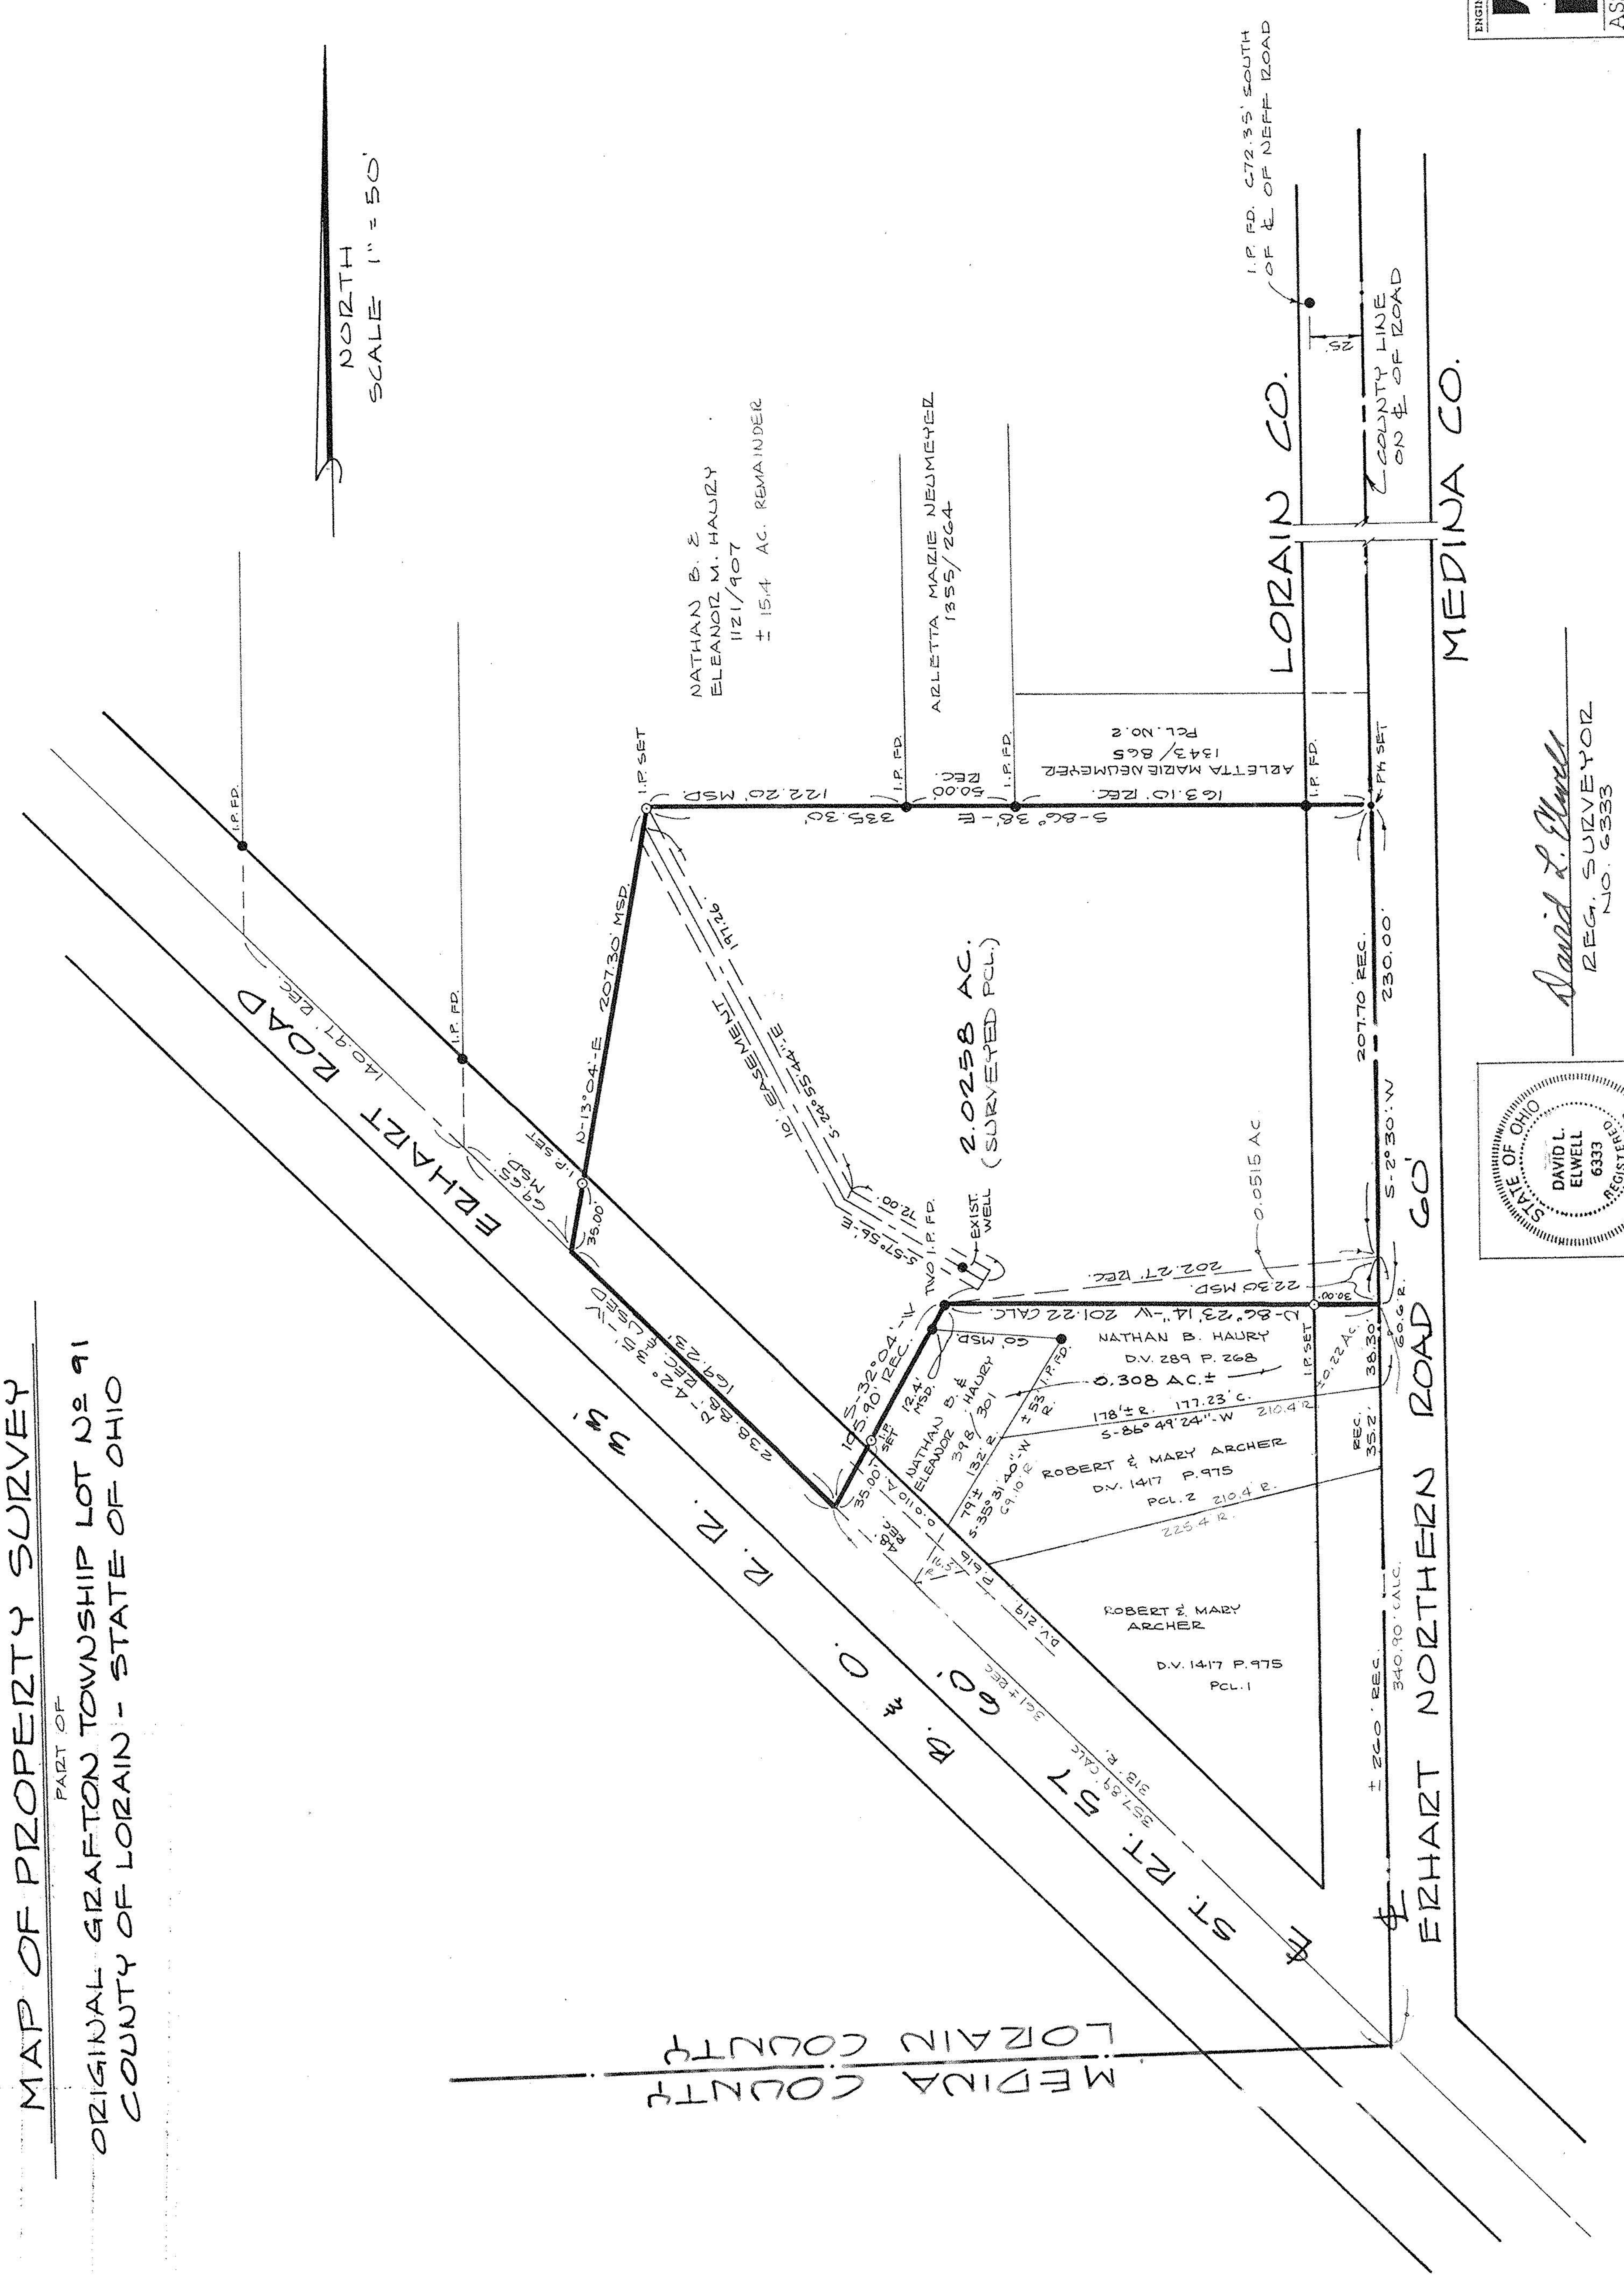

David L. Elwell
REG. SURVEYOR
NO. 6333

