LAUNDON . SIMON . CAHL & ASSOC. INC.
CONSULTING ENGINEERS & SURVEYORS
219 COURT ST. ELYRIA, OHIO 44035

SURVEY FOR:

MAURICE C. HILLS

Orig. Lot 55	City of	Date NOV. '87 Scale 1"=100'
Orig. Sec	Village of	Dwn. by R.G.S. Chkd. by C.J.
Tract	County of LORAIN	Job No. 87-1659 F.B.
Township of GRAFTON	State of OHIO	Printed

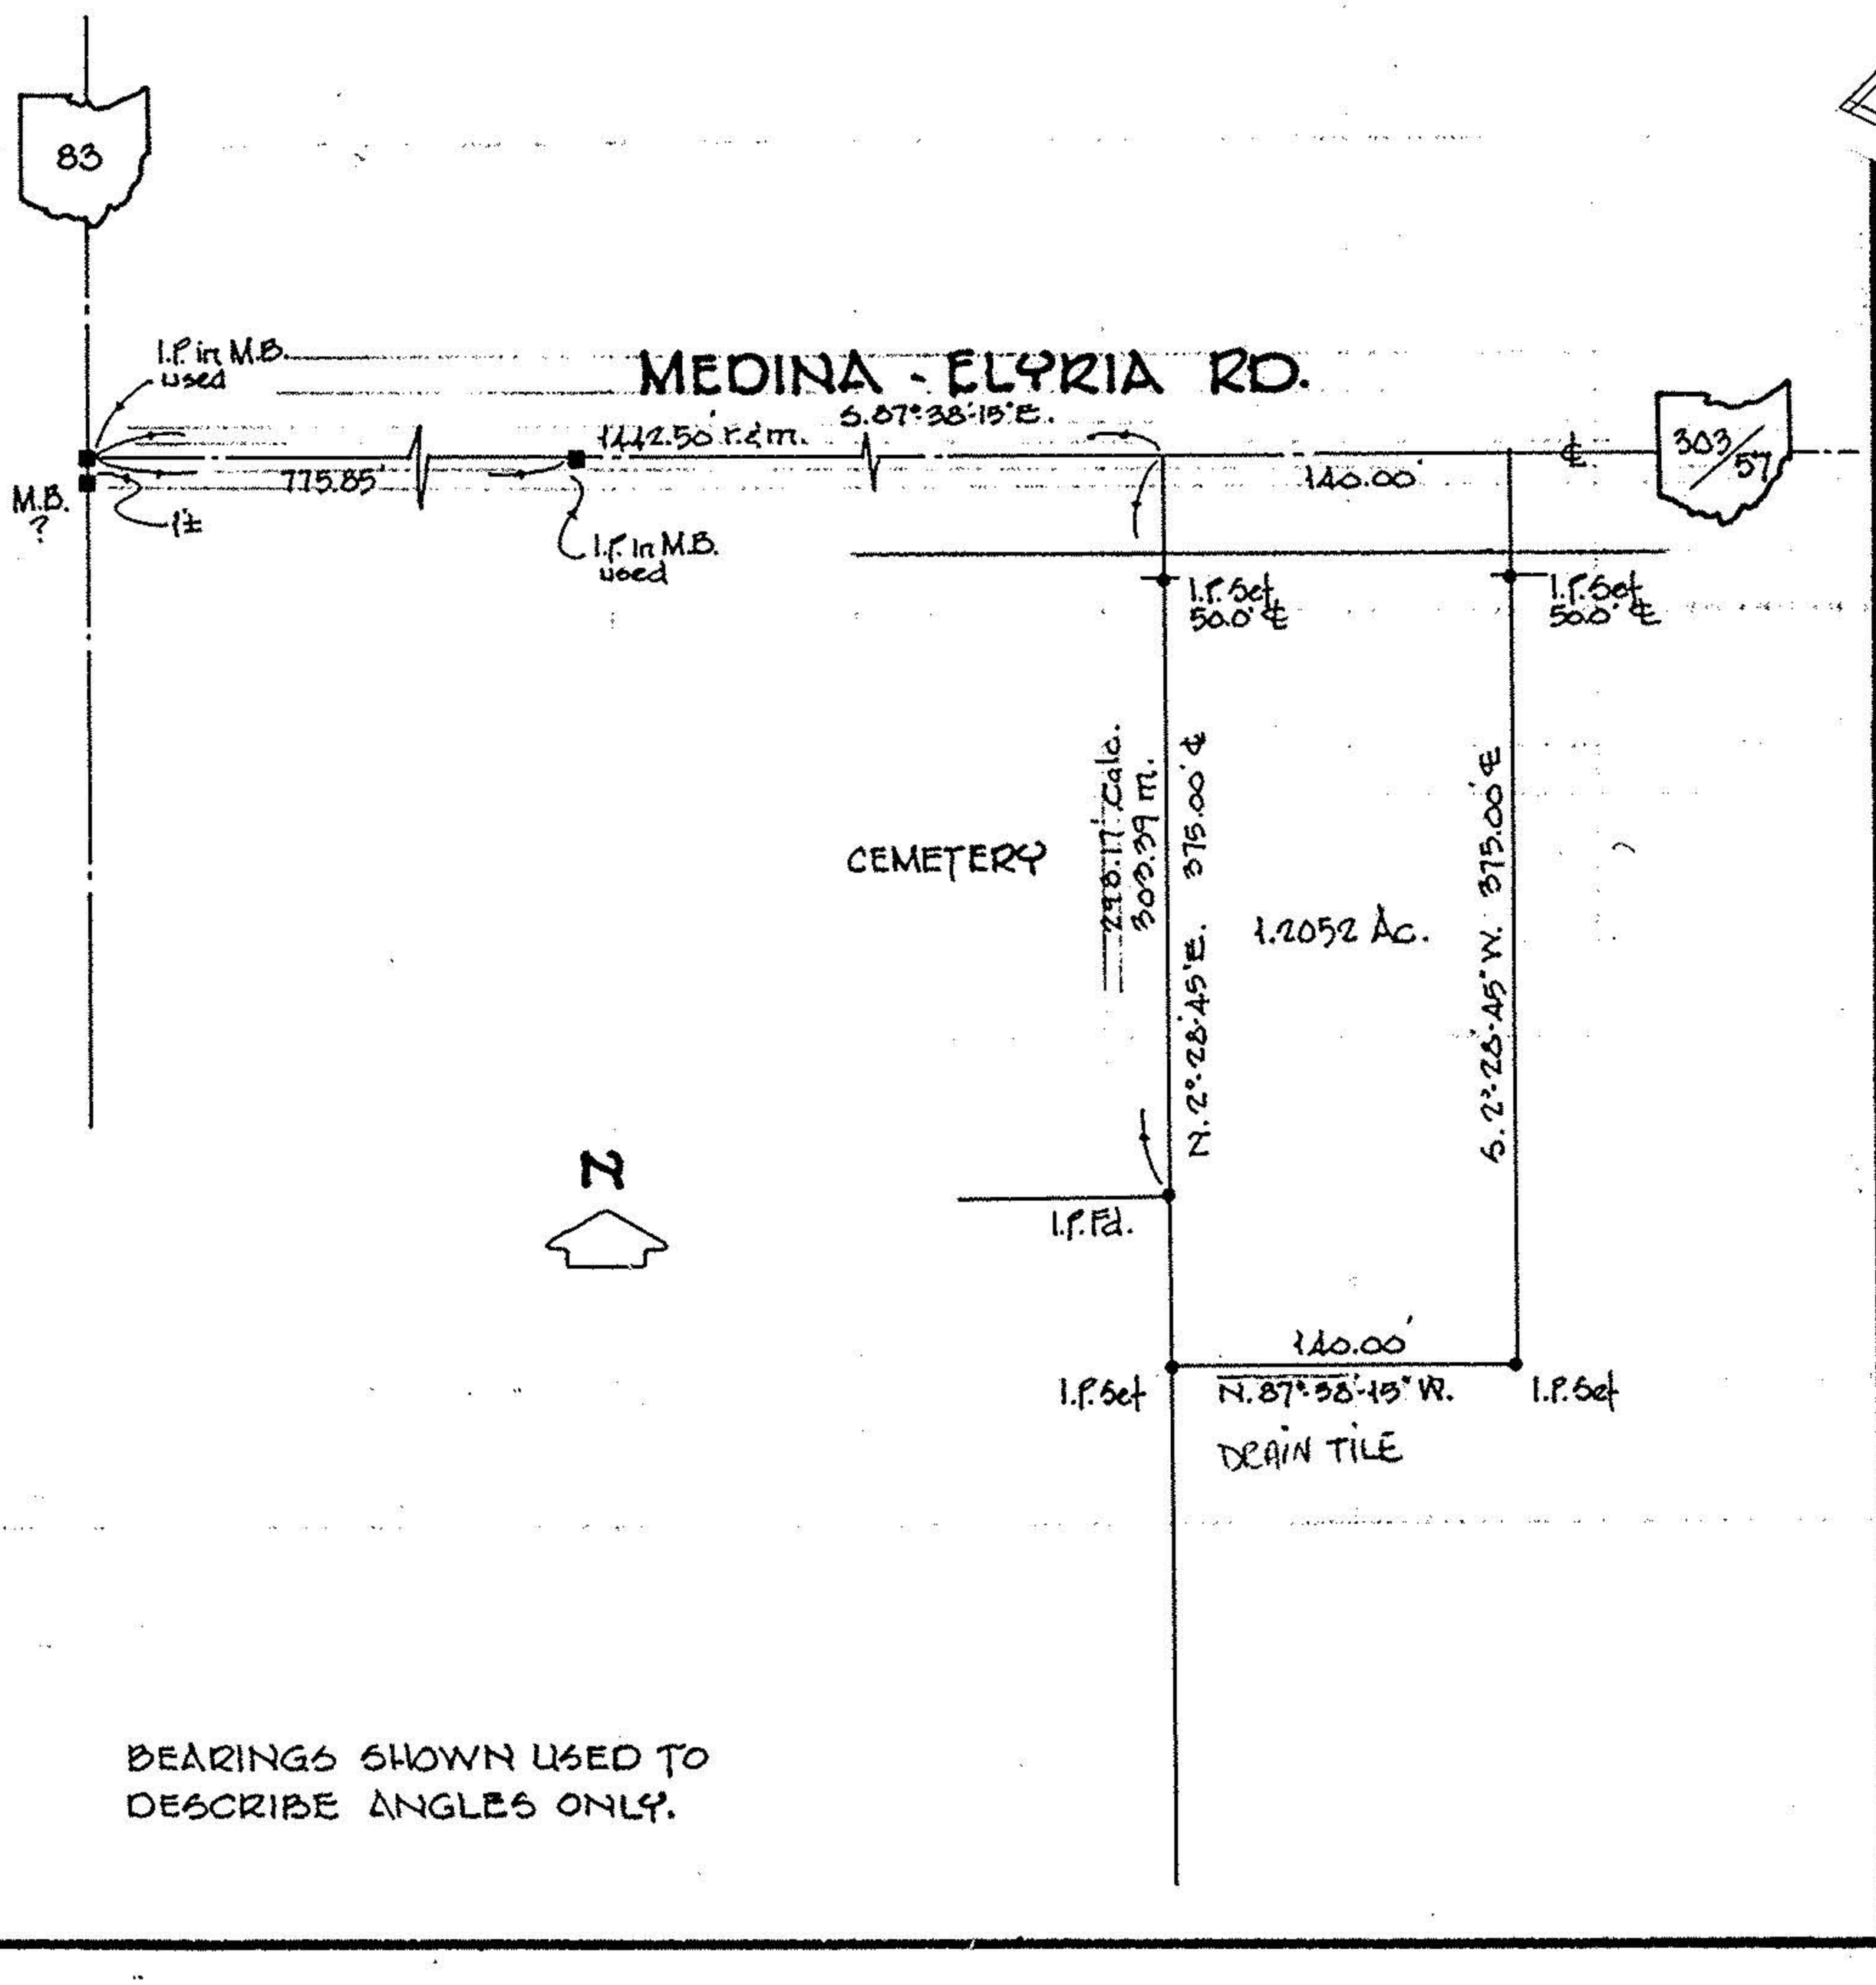

BEARINGS SHOWN USED TO DESCRIBE ANGLES ONLY.