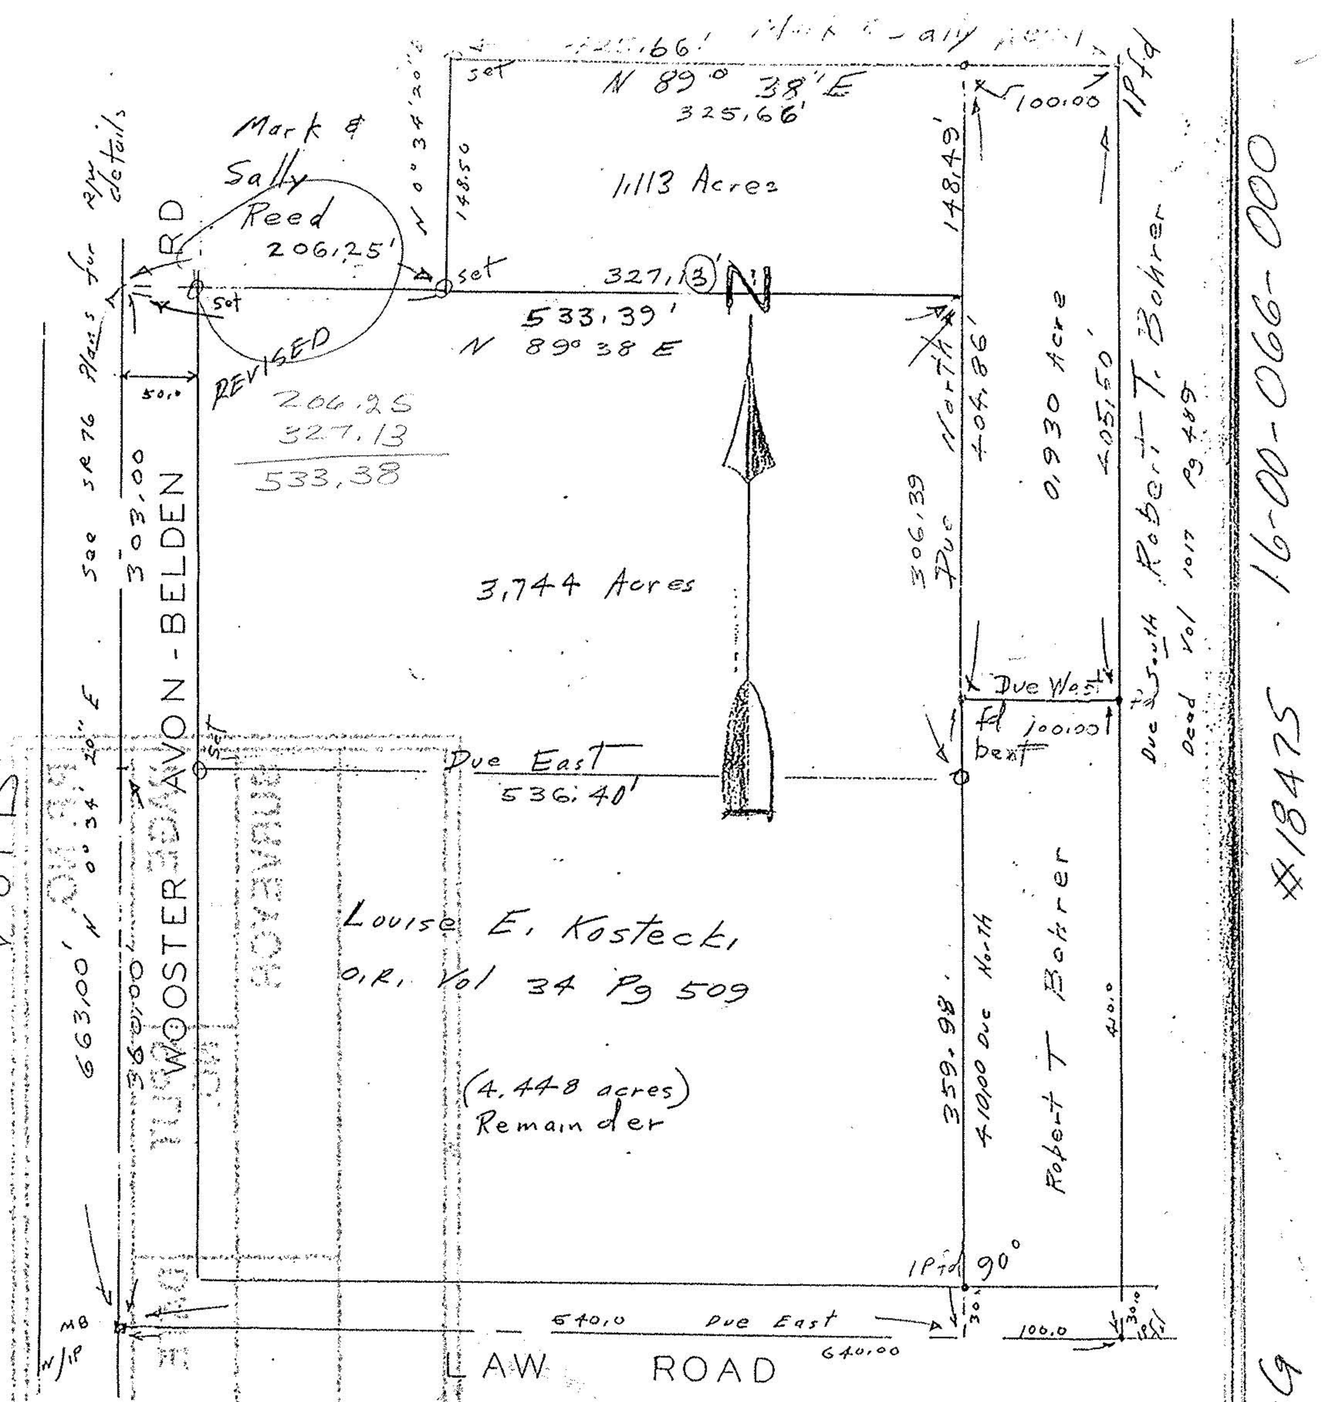
Mark & Sally Reed 206.25'
REVISED 206.25 327.13 533.38
N 89° 38' E 325.66'
1.113 Acres
N 0° 34' 20" E 148.50
327.13'
533.39' N 89° 38 E
148.49'
100.00
IPfd
0.930 Acre
405.50'
306.39' Due North 404.86'
3.744 Acres
Due West
fd 100.00 bent
Due South Robert T. Bohrer Deed Vol 1017 Pg 489
16-00-066-000
#18475
16-G
AVON-BELDEN
WOOSTER
Due East 536.40'
Louise E. Kostecki O.R. Vol 34 Pg 509
(4.448 acres) Remainder
359.98' Due North 410.00'
Robert T Bohrer
40.0'
IPfd 90°
MB N/IP
540.0 Due East 640.00'
30'
100.0
LAW ROAD
John Pozywak Reg Surveyor 5292
May, 9, 1988
Survey for Louise Kostecki
Part Original Lot 66
Grafton Township
Lorain County, Ohio
Apr 10, 1988
Scale 1"=100'

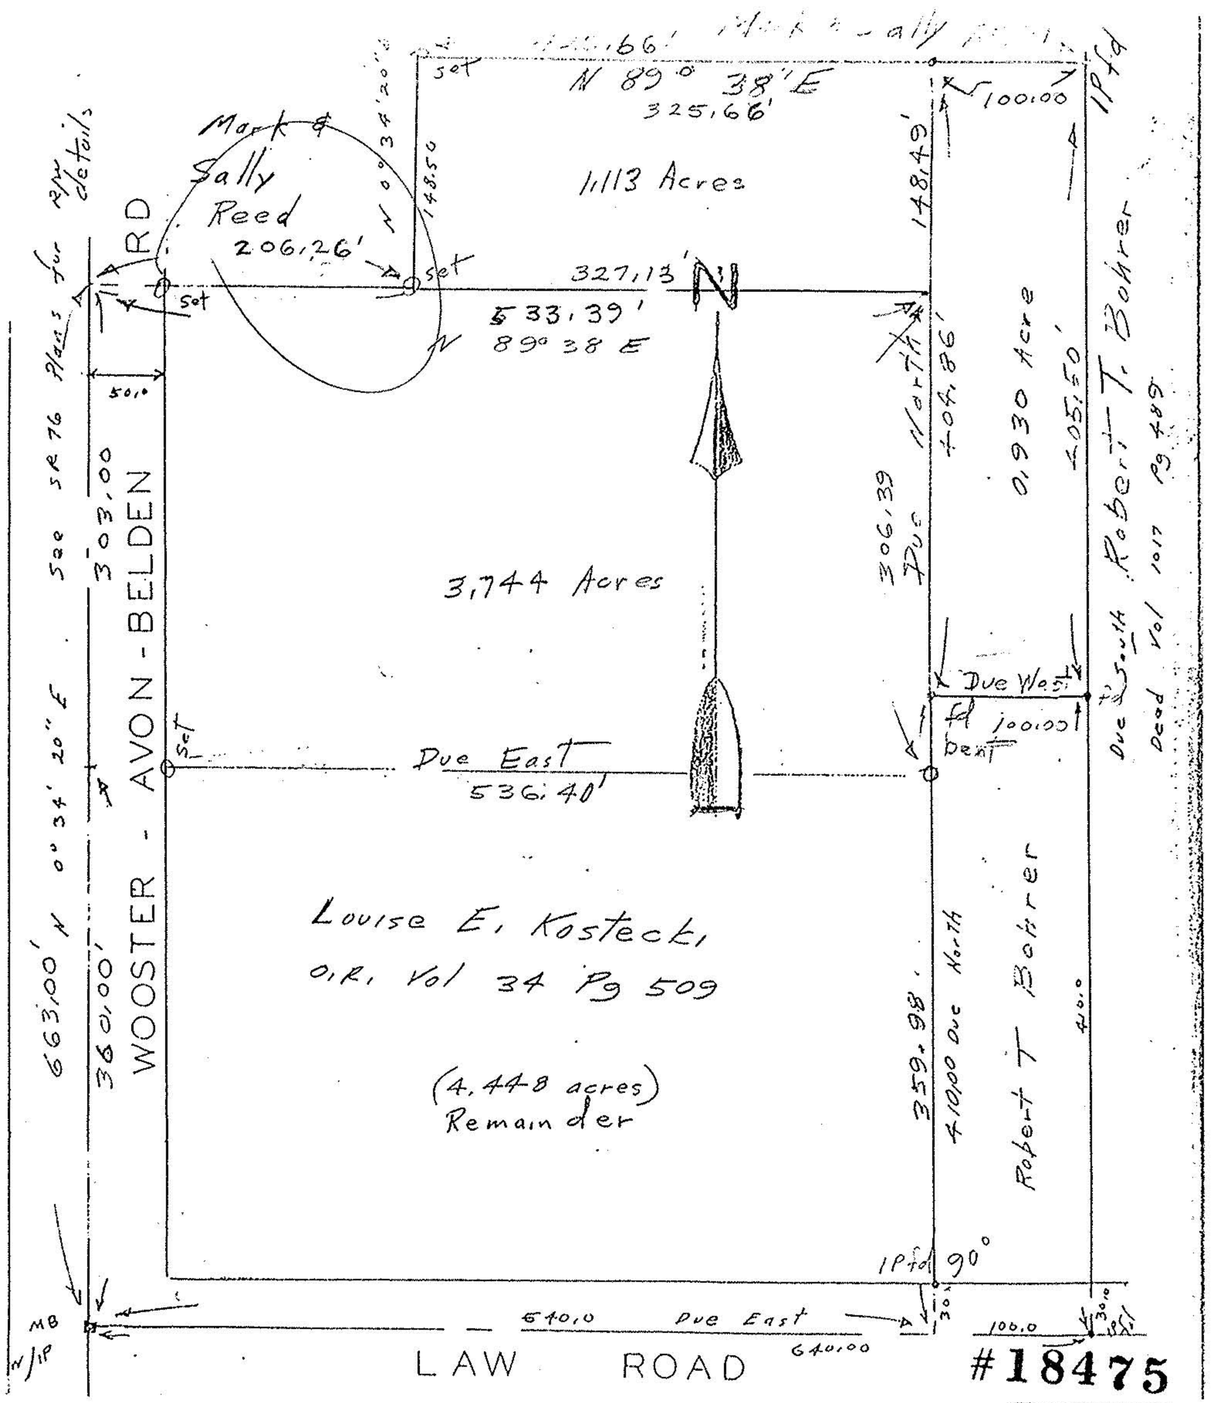
Mark & Sally Reed 206.26'
N 89° 38' E 325.66'
1.113 Acres
N 0° 34' 20" E 148.50
327.13'
533.39' N 89° 38 E
148.49'
100.00
IPfd
0.930 Acre
405.50'
306.39' Due North 404.86'
3.744 Acres
Due West
fd 100.00 bent
Due South Robert T. Bohrer Deed Vol 1017 Pg 489
AVON-BELDEN
WOOSTER
Due East 536.40'
Louise E. Kostecki O.R. Vol 34 Pg 509
(4.448 acres) Remainder
359.98' Due North 410.00'
Robert T Bohrer
40.0'
IPfd 90°
MB N/IP
540.0 Due East 640.00'
30'
100.0
LAW ROAD
#18475
John Pozywak Reg Surveyor 5292
May, 9, 1988
Survey for Louise Kostecki
Part Original Lot 66
Grafton Township
Lorain County, Ohio
Apr 10, 1988
Scale 1"=100'
APPROVED LORAIN CO. MAP DEPT.
DATE 6-22-89
PAGE 16-G
BY Carolyn Francis
VOID # 18475